



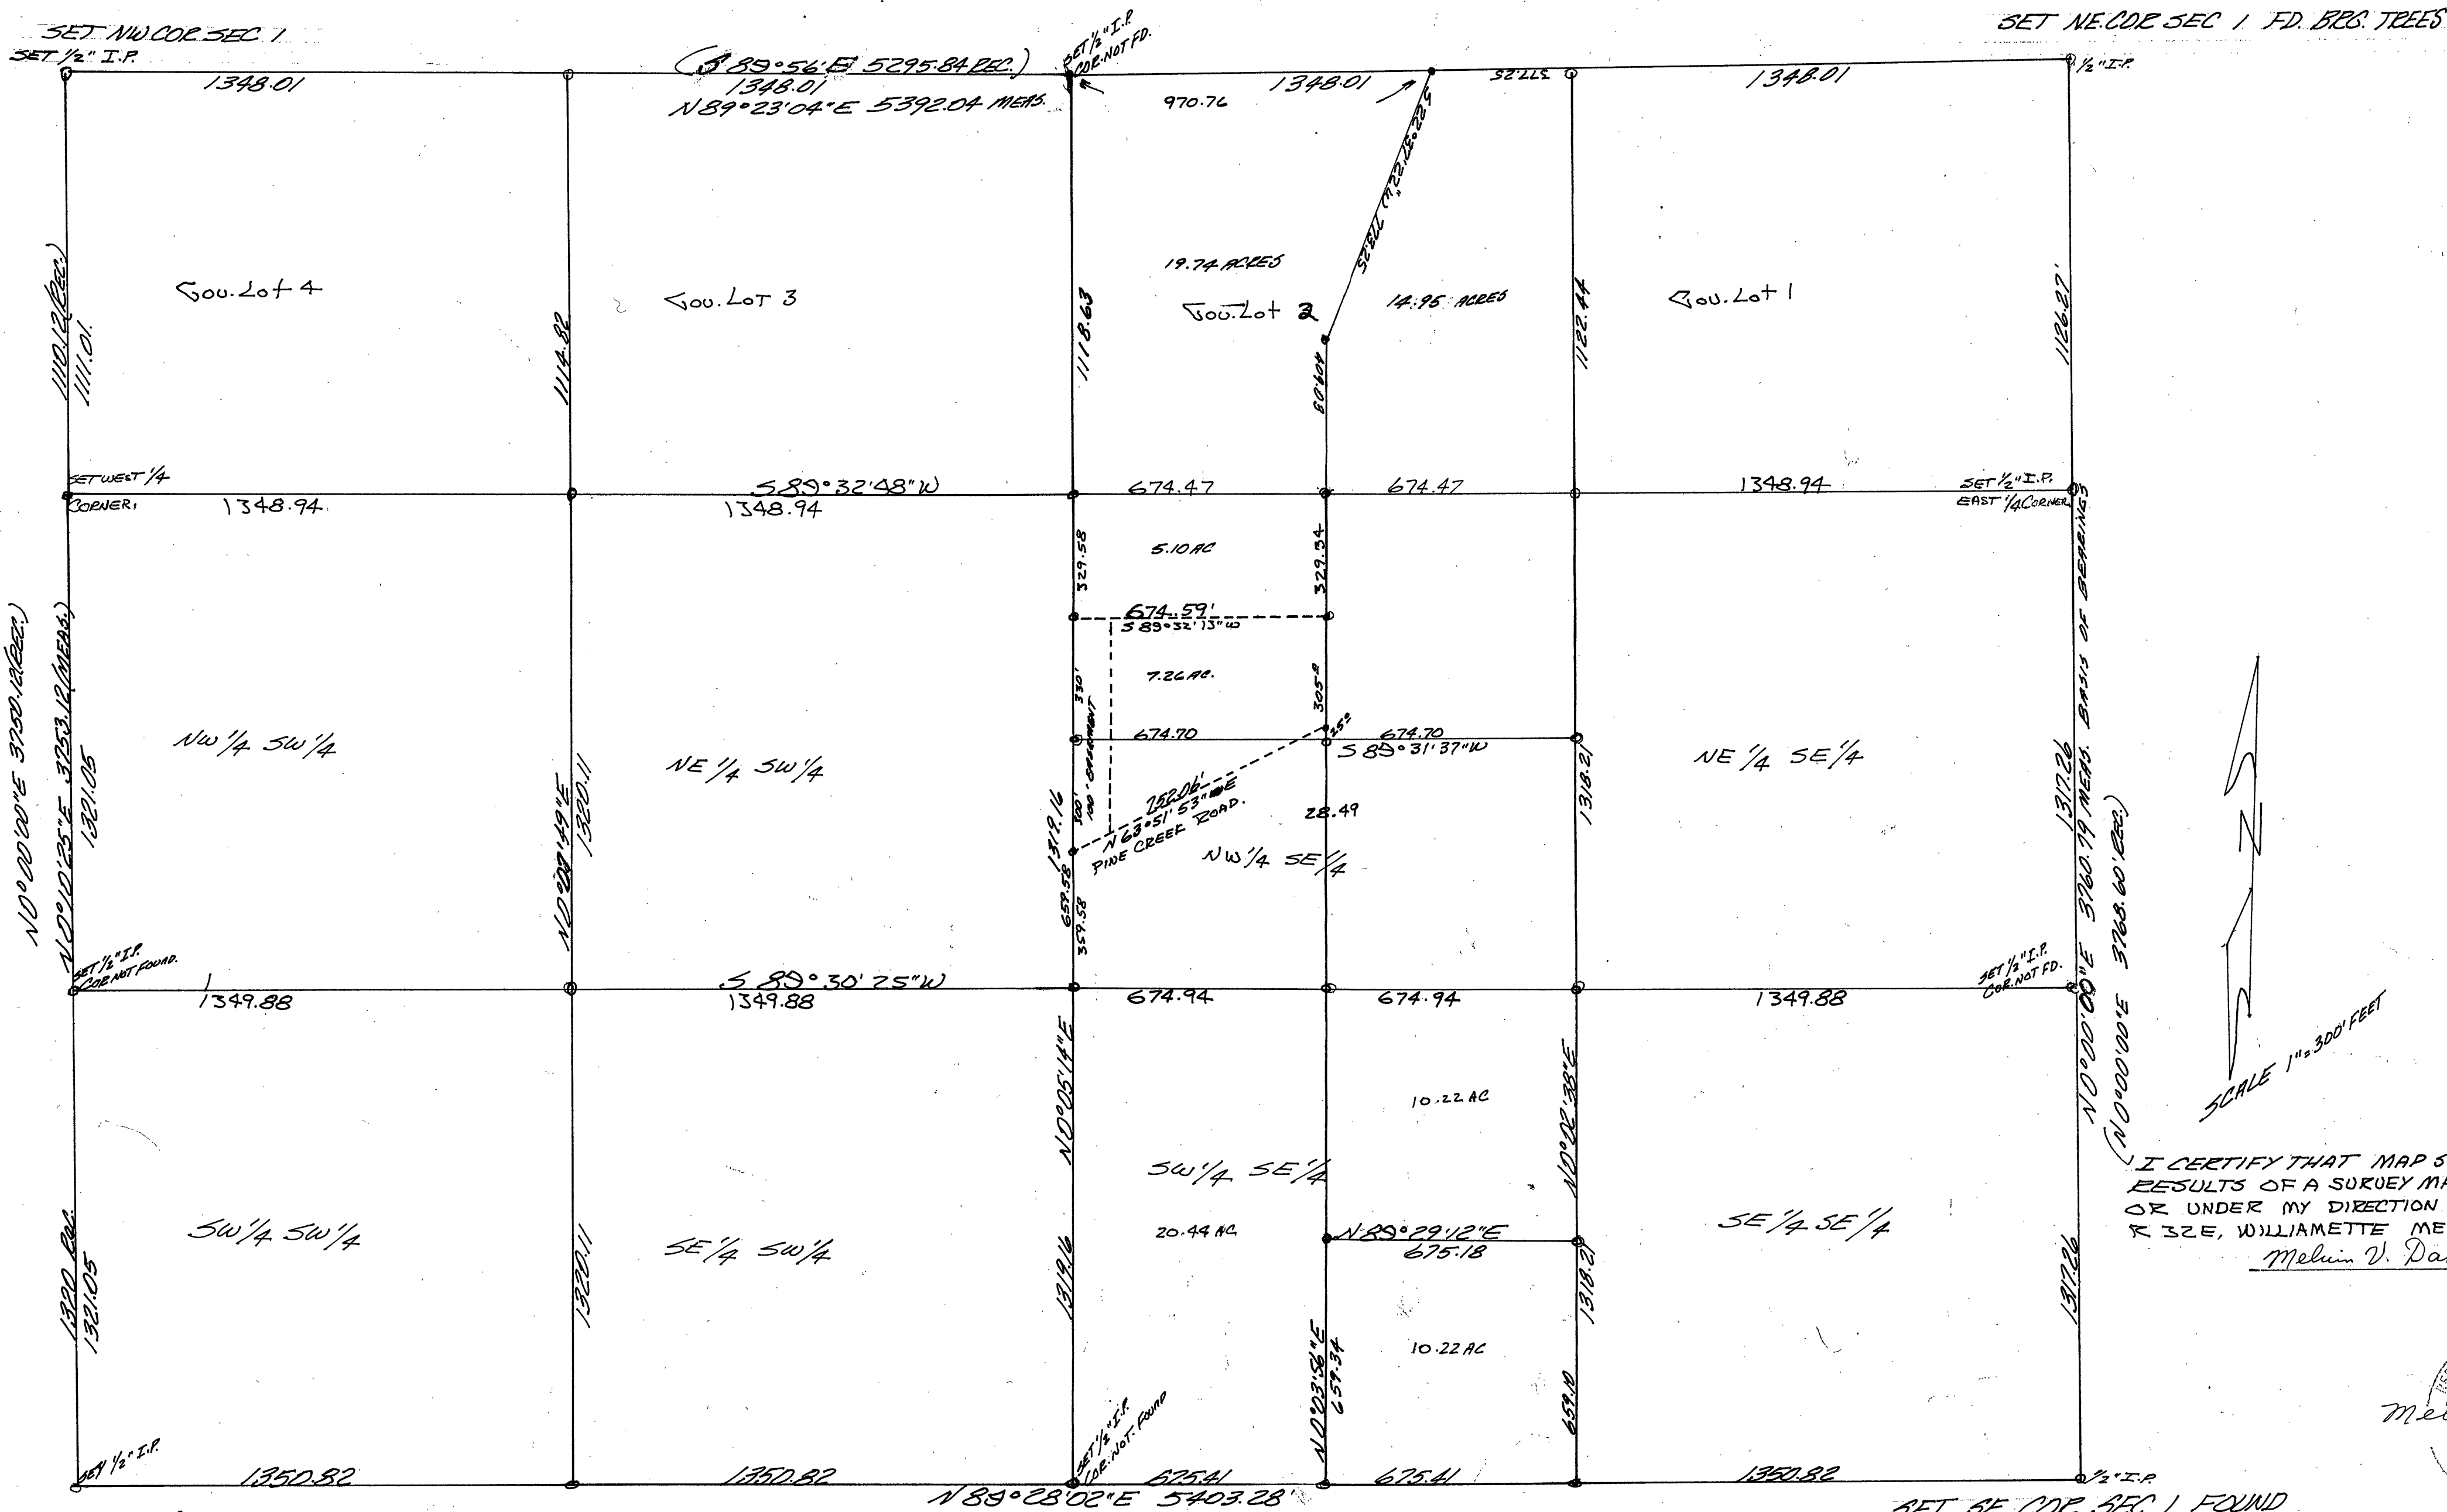

SCALE 1" = 300' FEET

I CERTIFY THAT MAP SHOWS THE RESULTS OF A SURVEY MADE BY ME OR UNDER MY DIRECTION IN SEC. 1, T. 14S, R. 32E, WILLAMETTE MERIDIAN, OREGON.

Melvin V. Davenport

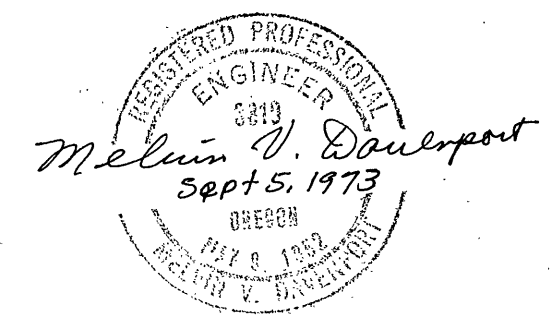

RECEIVED AND FILED

NOV 7 1974

JOHN LIVEIRA, County Clerk
By *[Signature]* Deputy

MAP OF SURVEY NO. 356

O = DENOTES CORNER SET 1/2" I.P.
DRAWN BY DON COURTEIGHT
PIN SET ARE 1/2" X 18" I.P.