


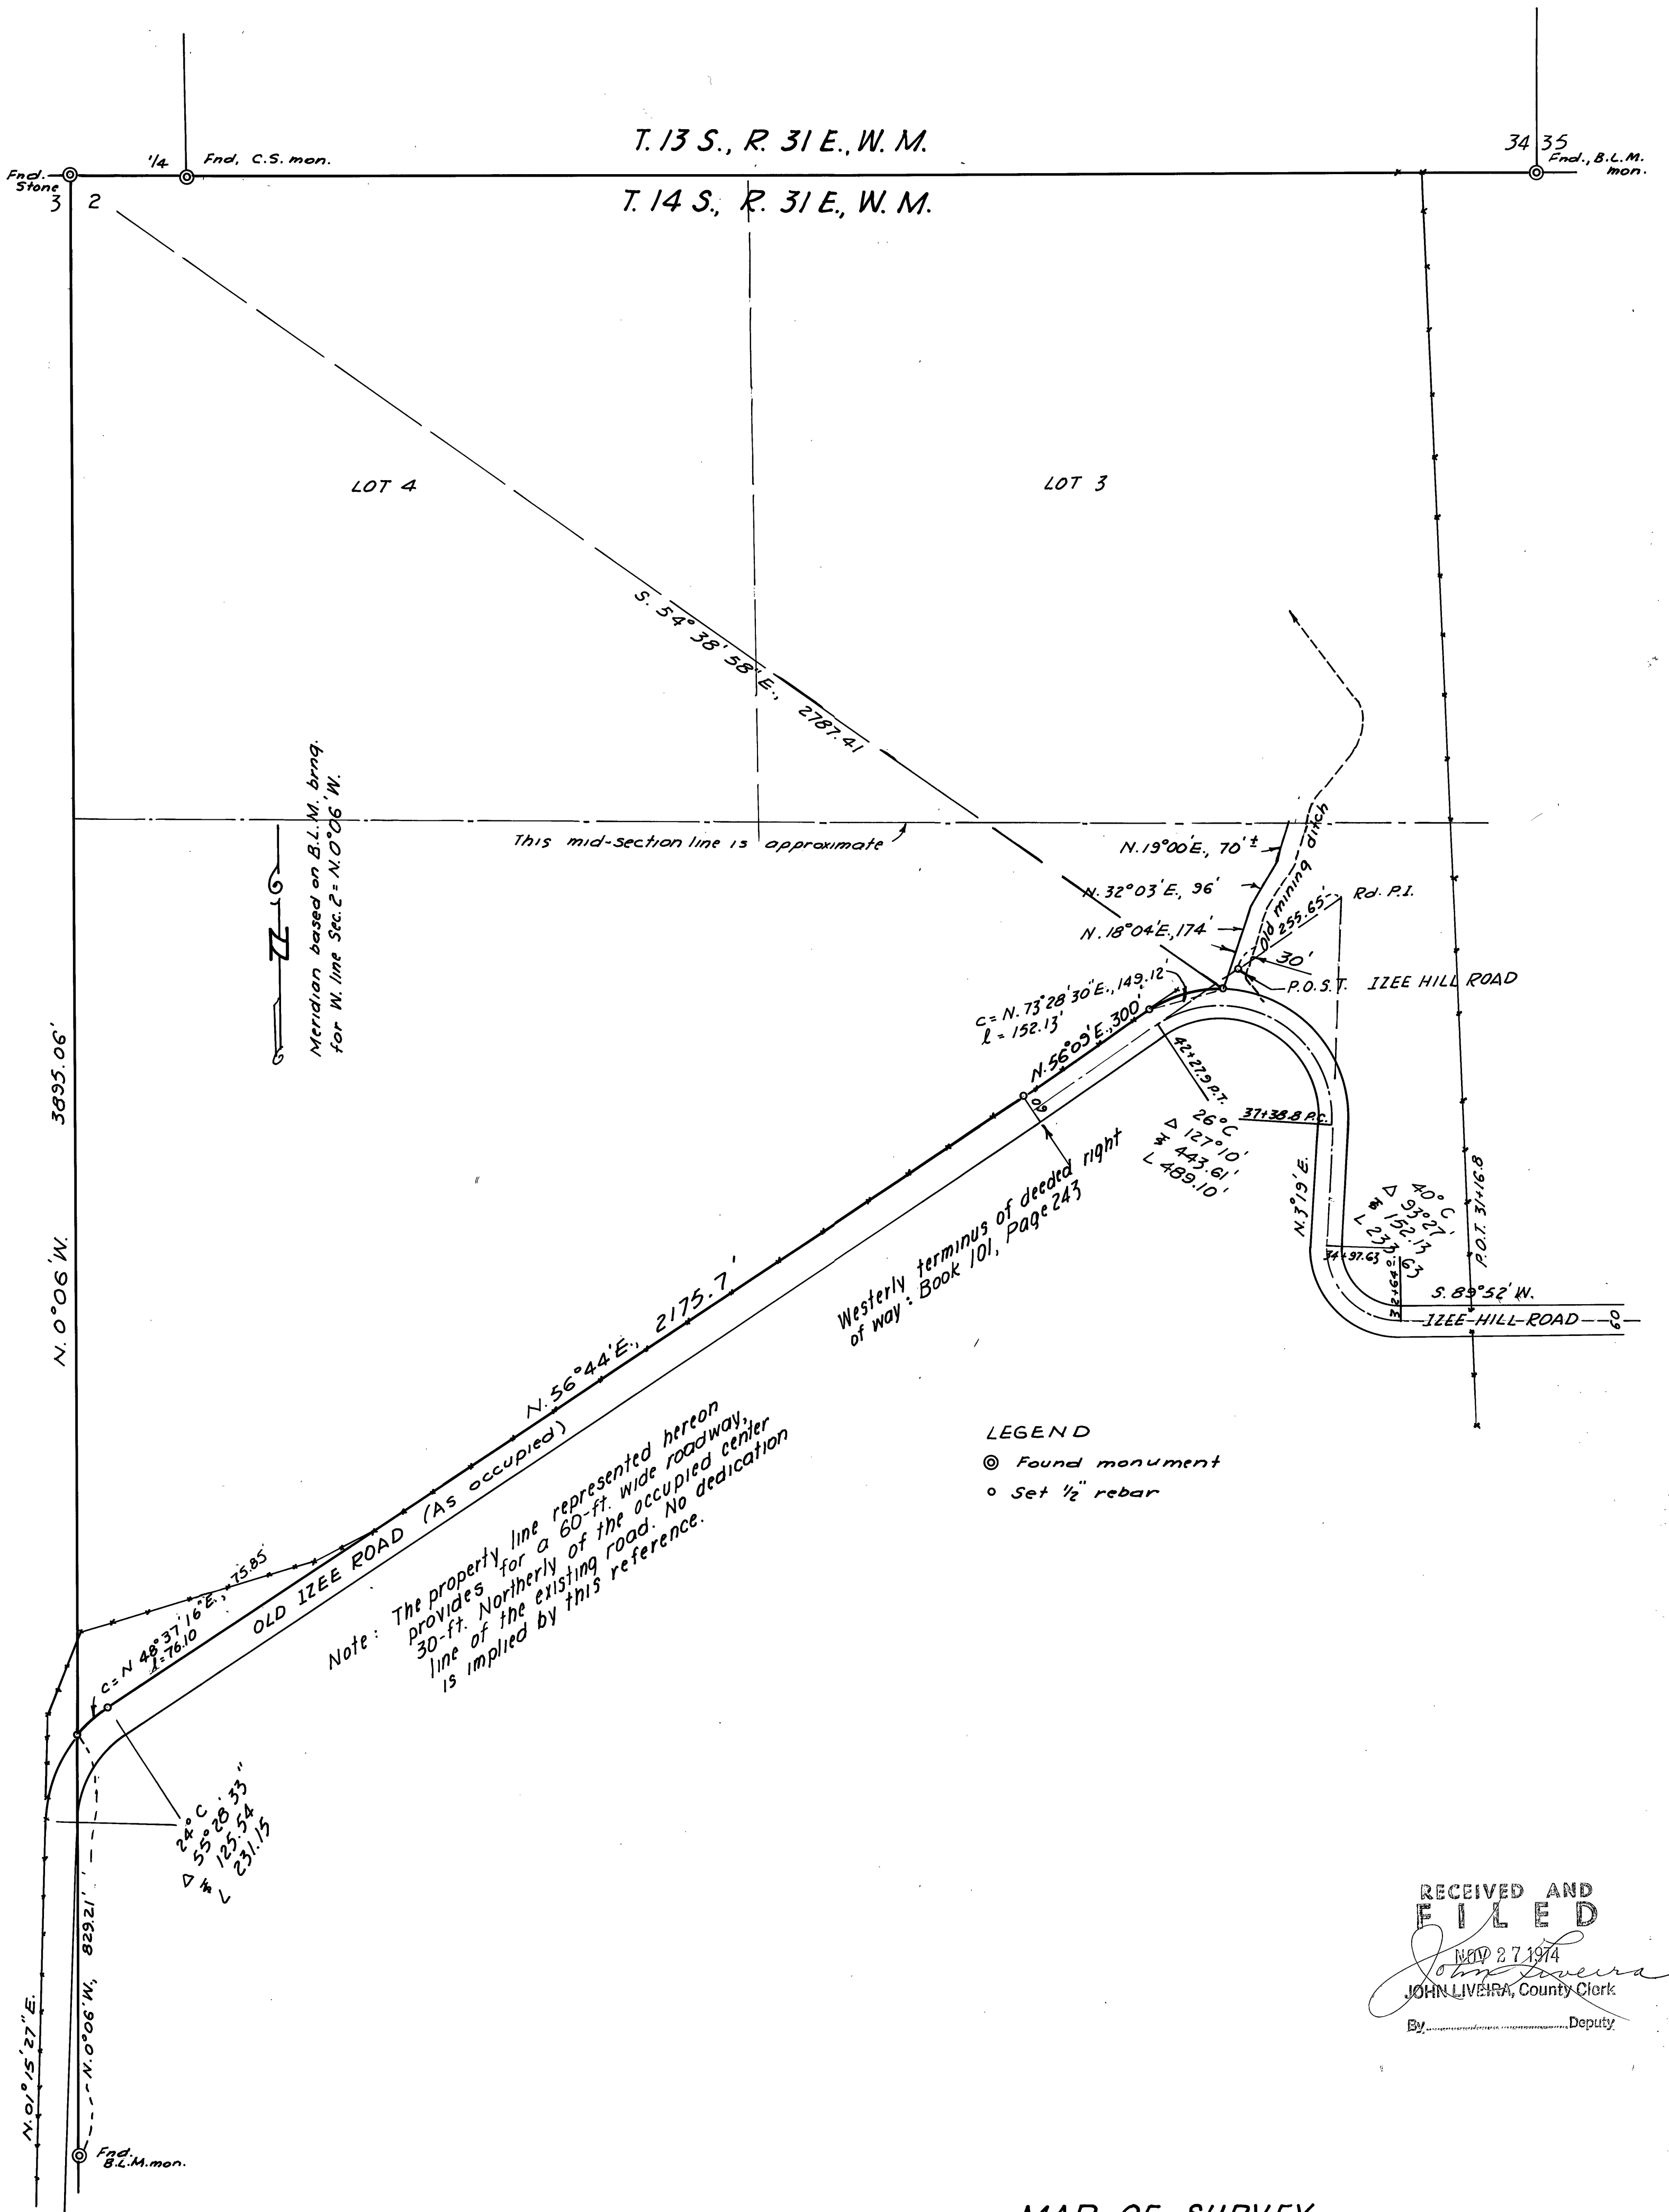

MAP OF SURVEY

FOR HILLERY STOUT

Nov. 6th 18, 1974 Scale 1"=200'

MAP OF SURVEY NO. 357

RECEIVED AND
FILED

NOV 27 1974

JOHN LIVERA, County Clerk

By Deputy

