


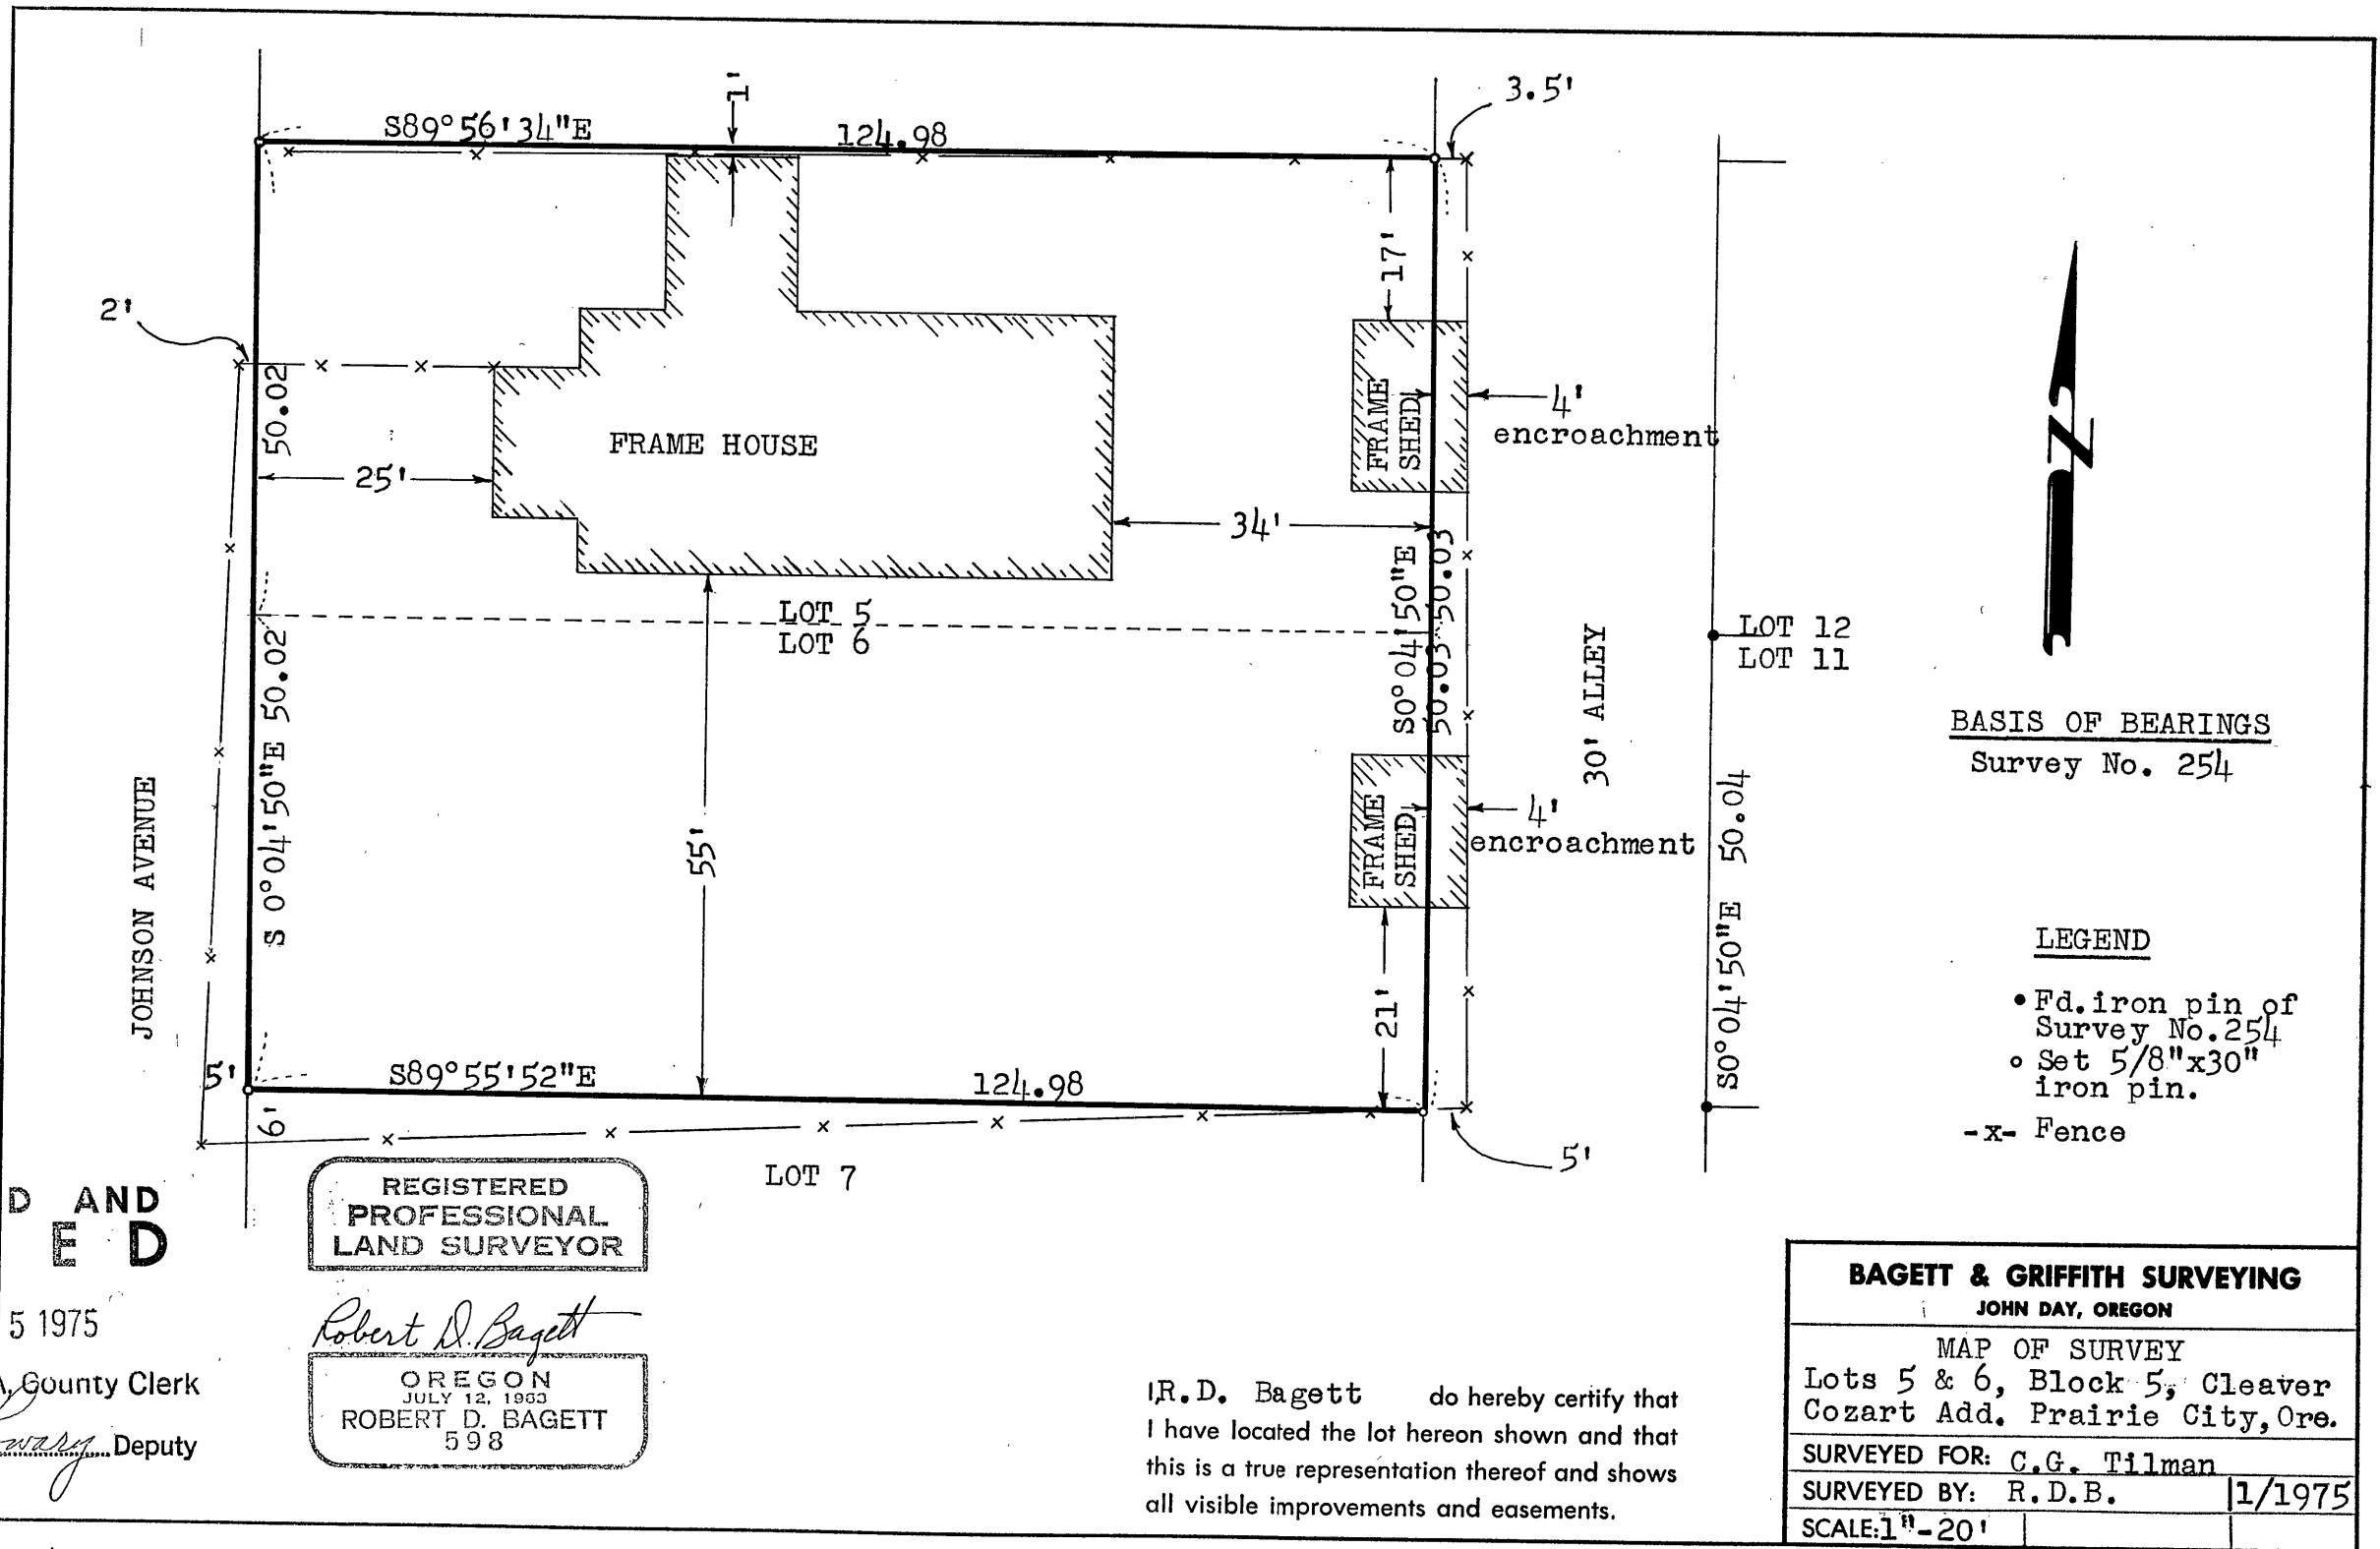

RECEIVED AND
FILED

FEB - 5 1975

JOHN LIVEIRA, County Clerk

By *Betty Lowery* Deputy

REGISTERED
PROFESSIONAL
LAND SURVEYOR

Robert D. Bagett

OREGON
JULY 12, 1963
ROBERT D. BAGETT
598

I, R.D. Bagett do hereby certify that
I have located the lot hereon shown and that
this is a true representation thereof and shows
all visible improvements and easements.

BAGETT & GRIFFITH SURVEYING		
JOHN DAY, OREGON		
MAP OF SURVEY Lots 5 & 6, Block 5, Cleaver Cozart Add. Prairie City, Ore.		
SURVEYED FOR: C.G. Tilman		
SURVEYED BY: R.D.B.		1/1975
SCALE: 1" = 20'		

MAP OF SURVEY NO. 250