


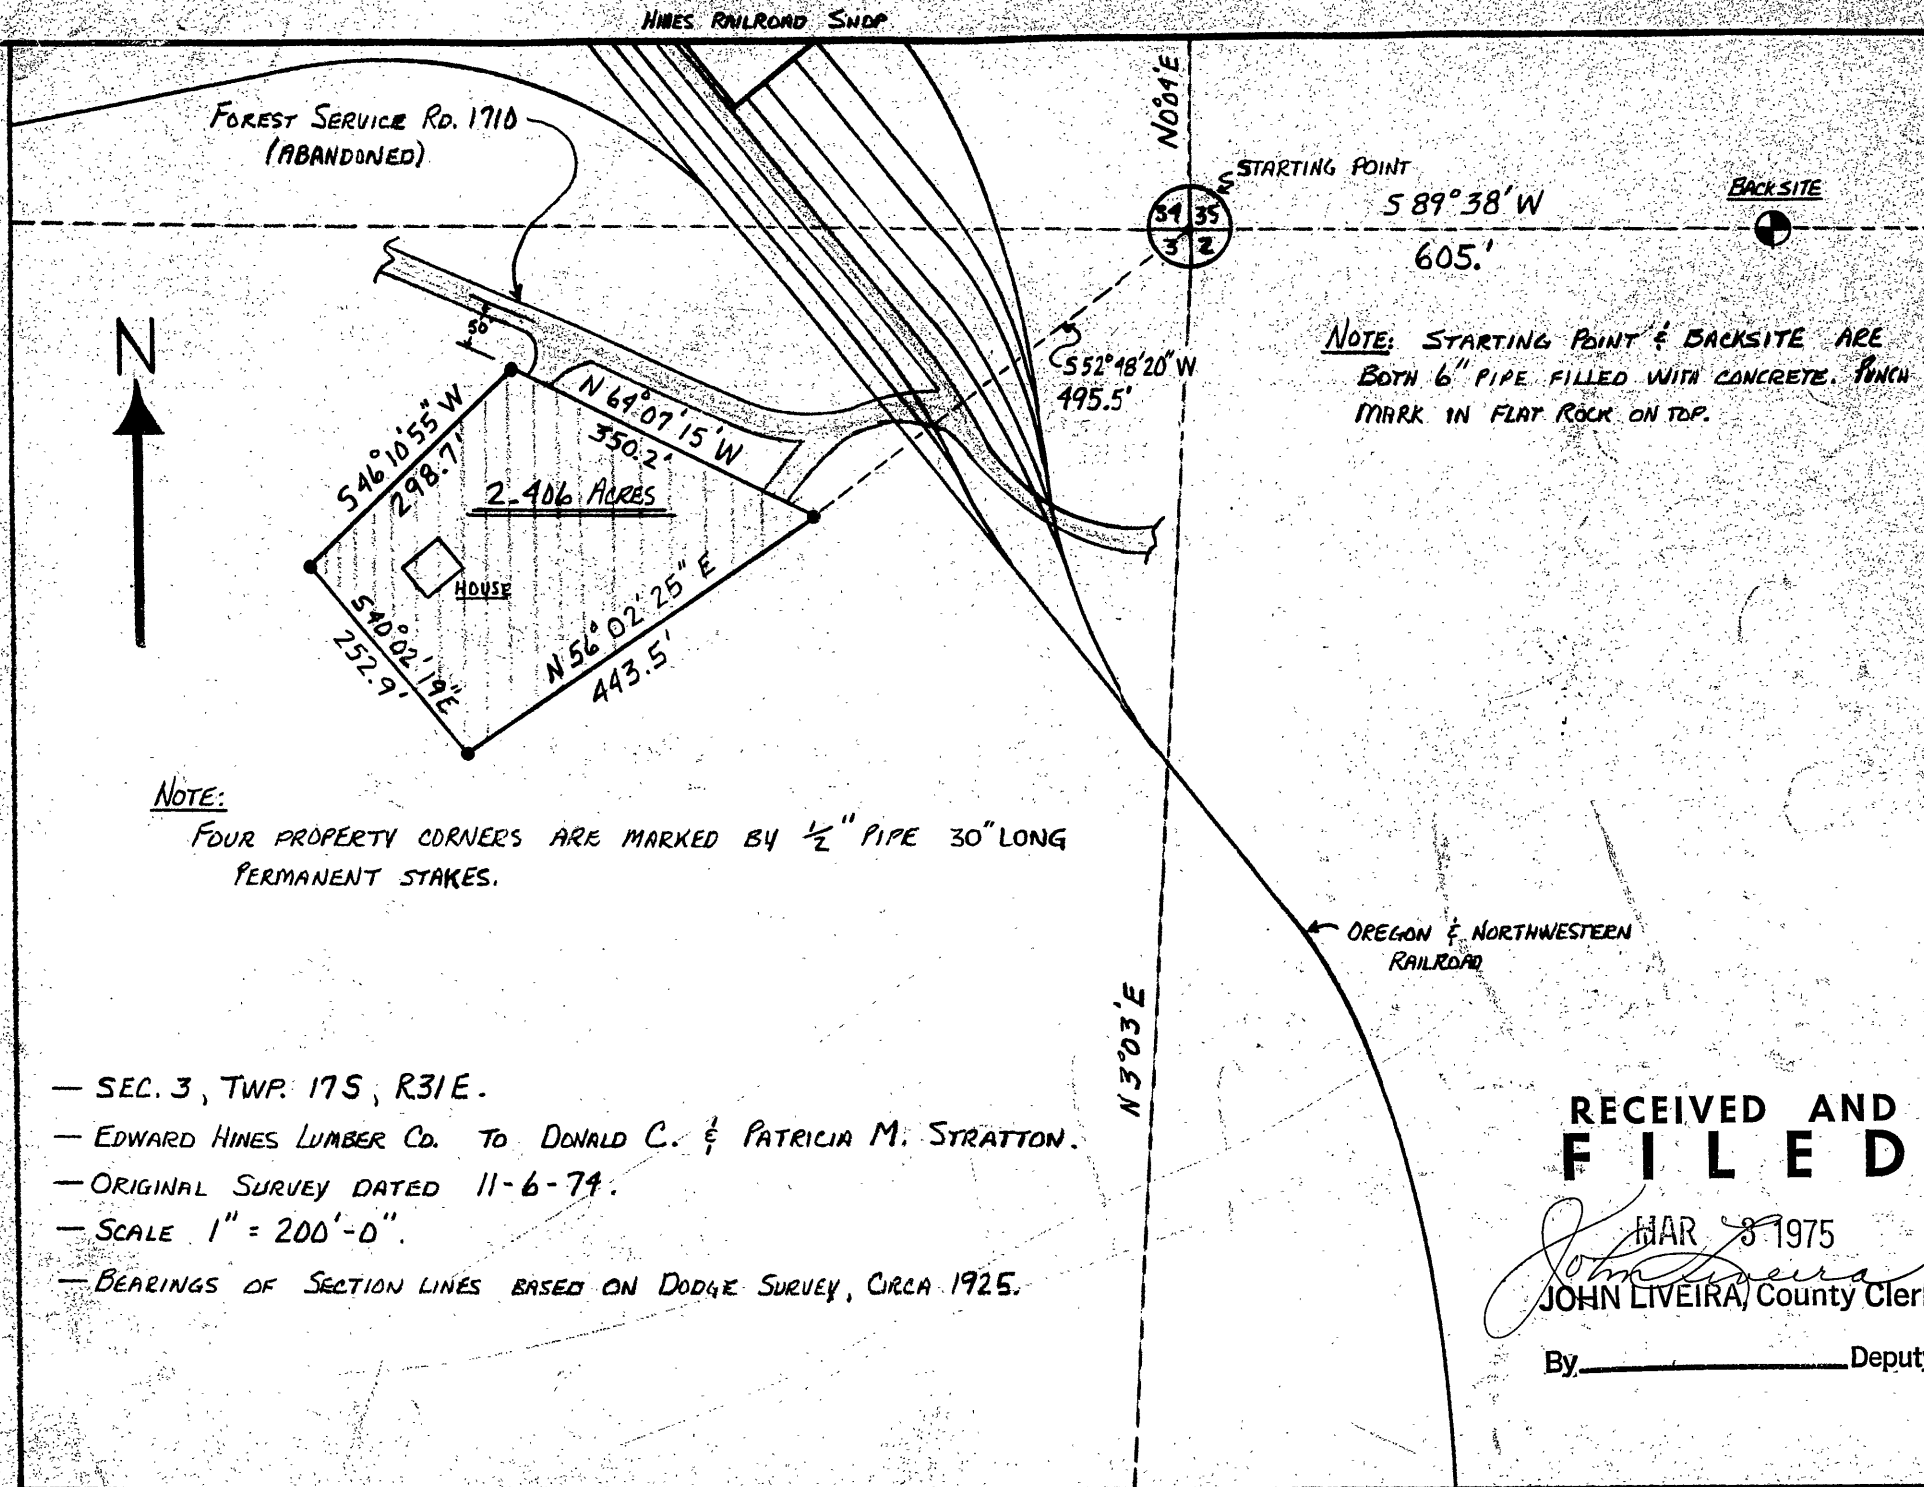

EDWARD HINES LUMBER CO.
HINES, OREGON 97738

SCALE 1" = 200'-0"	DWN. BY BEC
DATE 19 FEB 75	SH. 1 OF 1
SENECA	PROPERTY SALE

RECEIVED AND
FILED

MAR 8 1975
JOHN LIVEIRA, County Clerk

By _____ Deputy



MAP OF SURVEY 30