


26	25
35	36

Solar Observation

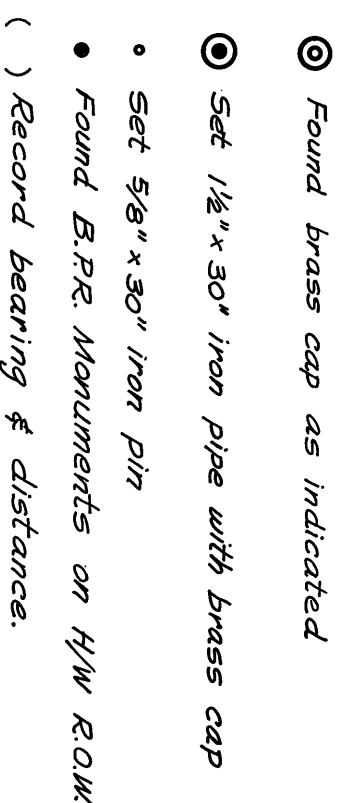

RECEIVED AND
FILED

JOHN LIVEIRA, County Clerk
By Debra D. D'Amico Deputy

Robert D. Baggett
OREGON
JULY 12, 1963
ROBERT D. BAGGETT
598

5 89° 17' 18" W 2631.86
(5 89° 57' W 40 Chs)

BAGETT, GRIFFITH & ASSOCIATES
John Day, Oregon

Ed. 2" iron pipe with brass cap
marked cor. No. 1 John Long Placer.
1.44 ft. North of Twp. Line. Accepted
monument for eastings as E 1/6 cor
as it was intended to be 1/16 cor

SURVEYED BY	R. D. B. ~ D. I. G	3 ~ 1972
Scale: 1" = 400'	Drawn by: J. W. Z.	3 ~ 1972