


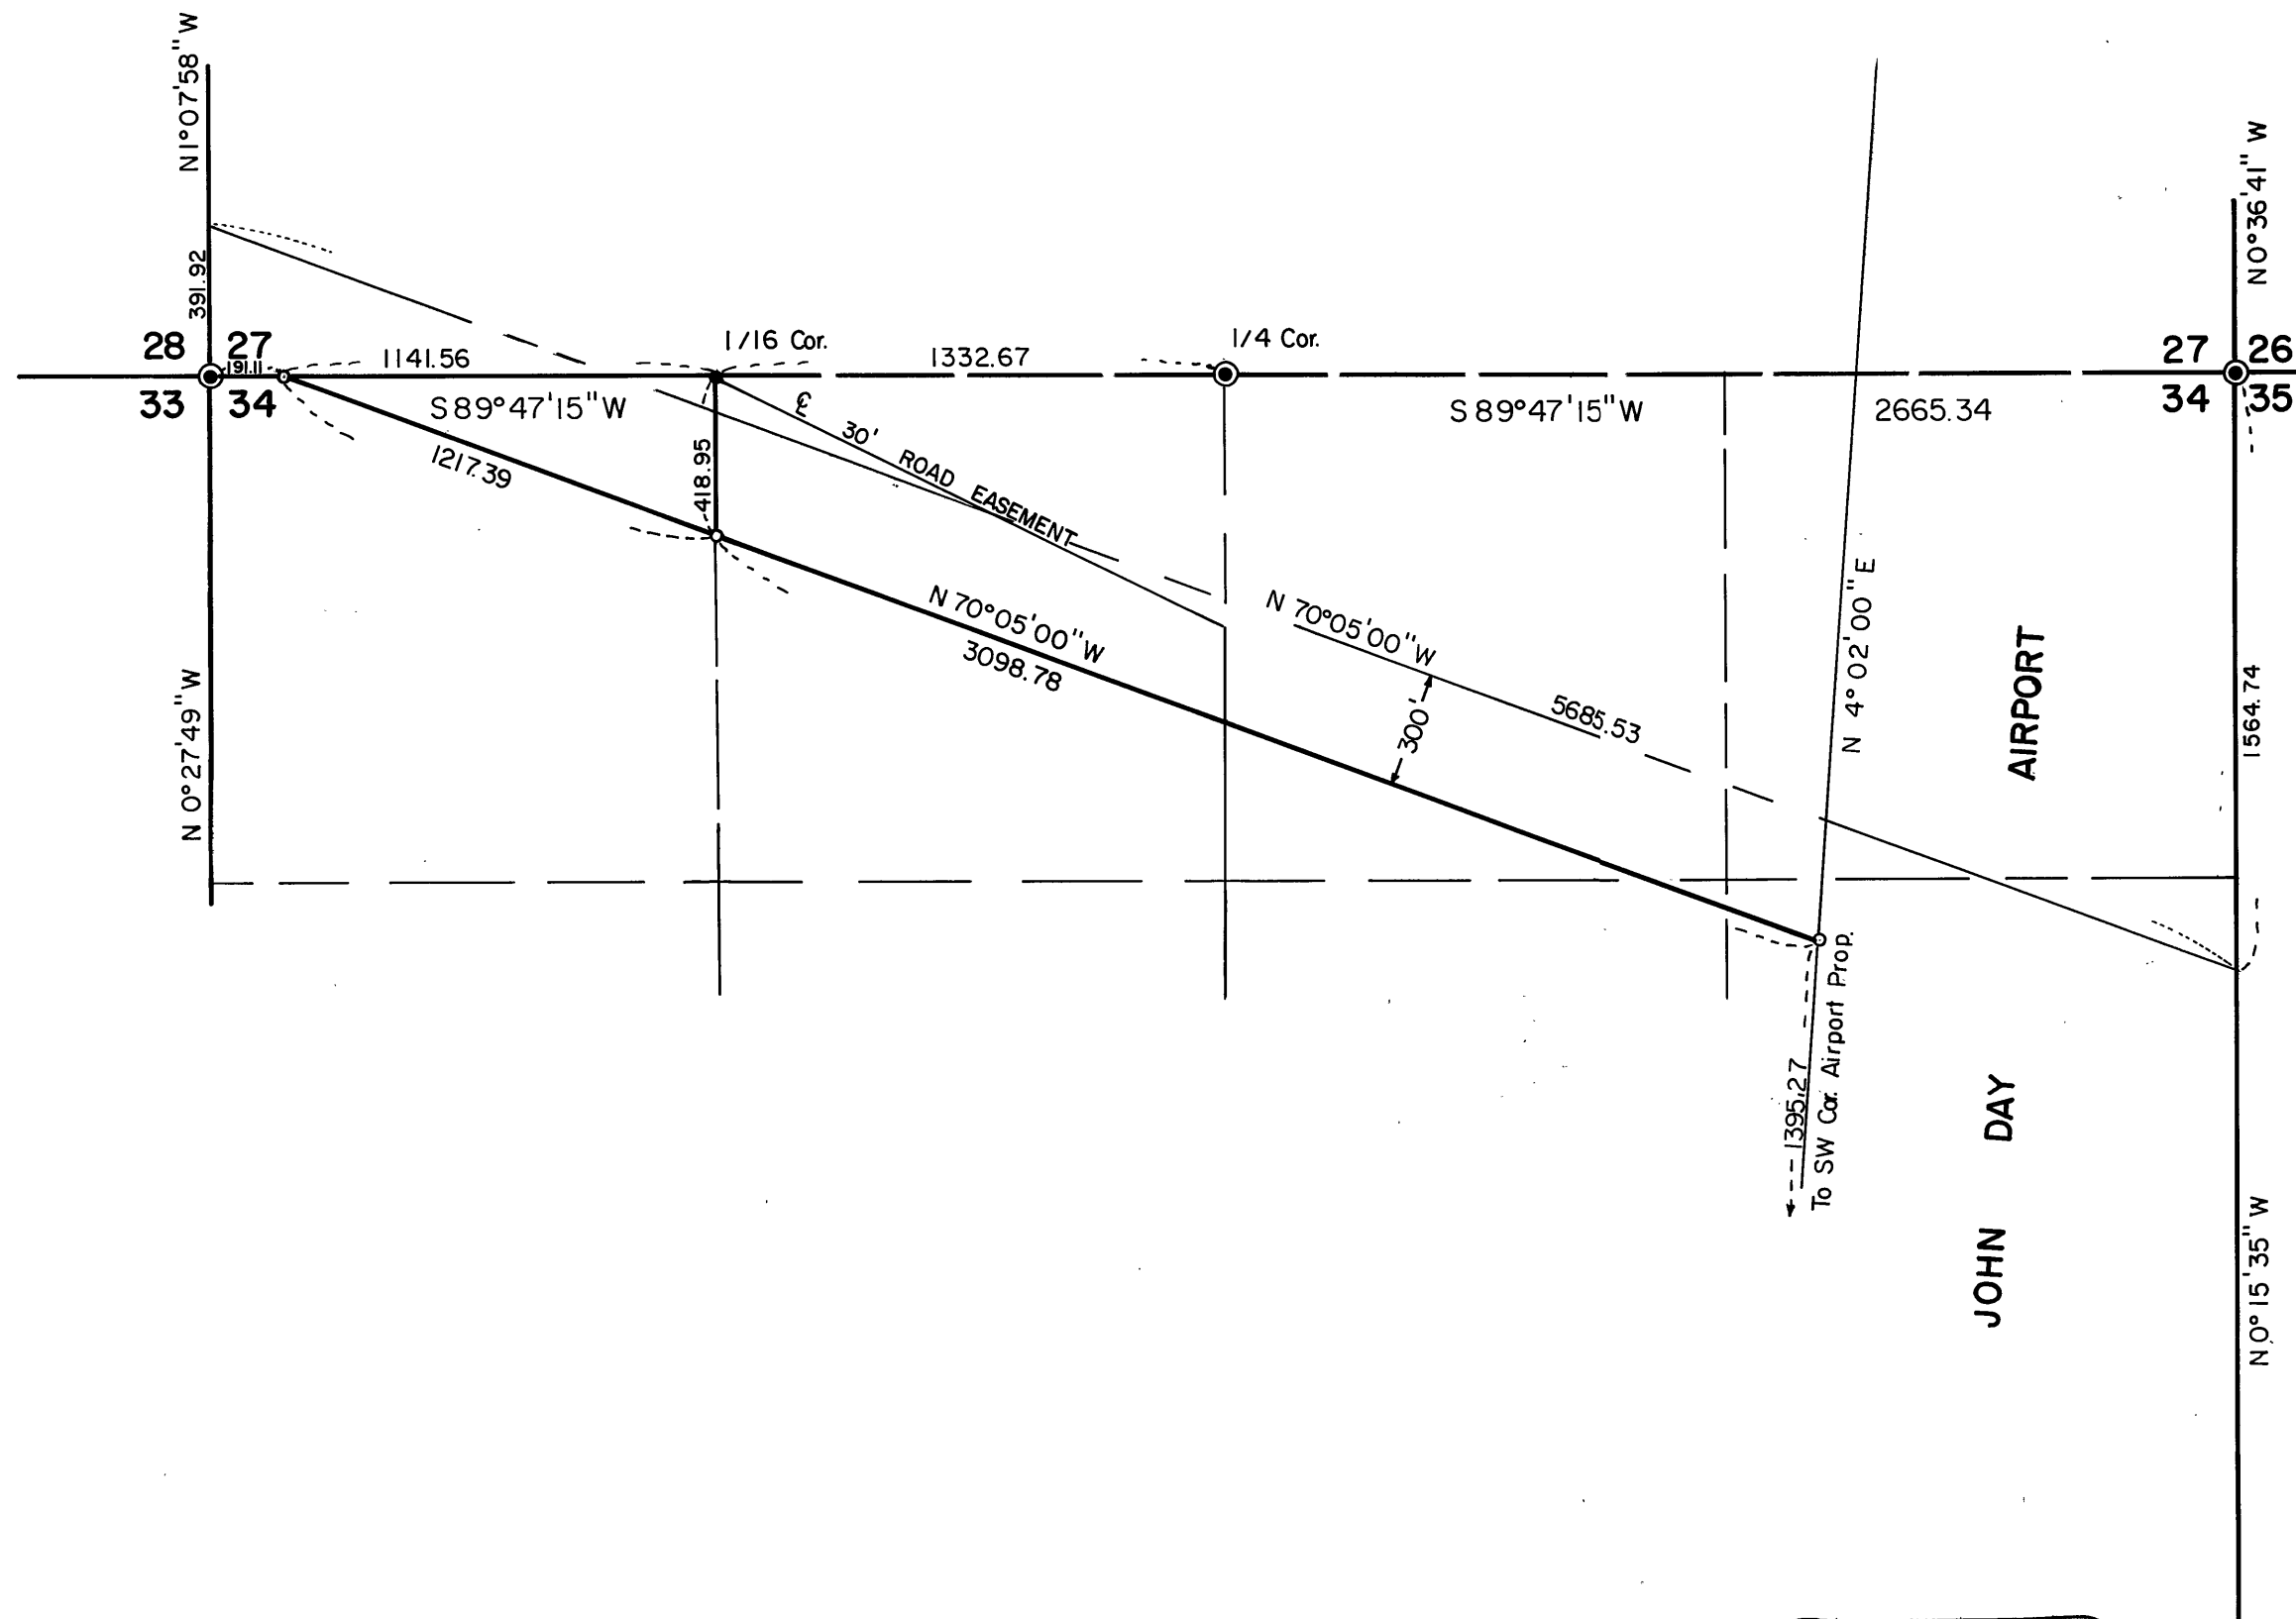

BASIS OF BEARINGS
SURVEY NO. 324

REFERENCE DATA
SURVEY NO. 324

LEGEND

- Fd. Brass Cap Monument
- Fd. 5/8" x 30" iron pin
- Set 5/8" x 30" iron pin

**RECEIVED AND
FILED**

APR 10 1975

JOHN LIVEIRA, County Clerk

By *Betty Lowery* Deputy

REGISTERED
PROFESSIONAL
LAND SURVEYOR

Robert D. Bagett

OREGON
JULY 12, 1963
ROBERT D. BAGETT
598

BAGETT, GRIFFITH & ASSOCIATES

John Day, Oregon

Map of Survey

SOUTH BOUNDARY AIRPORT PROPERTY

SECTION 34, T.13S., R.31E., W.M.

GRANT COUNTY, OREGON

SURVEYED FOR	AERONAUTICS DIVISION STATE OF OREGON	
SURVEYED BY	R.D.B. & R.B.C.	4/1/75
Scale: 1" = 500'	Drawn by: R.B.C.	4/2/75