


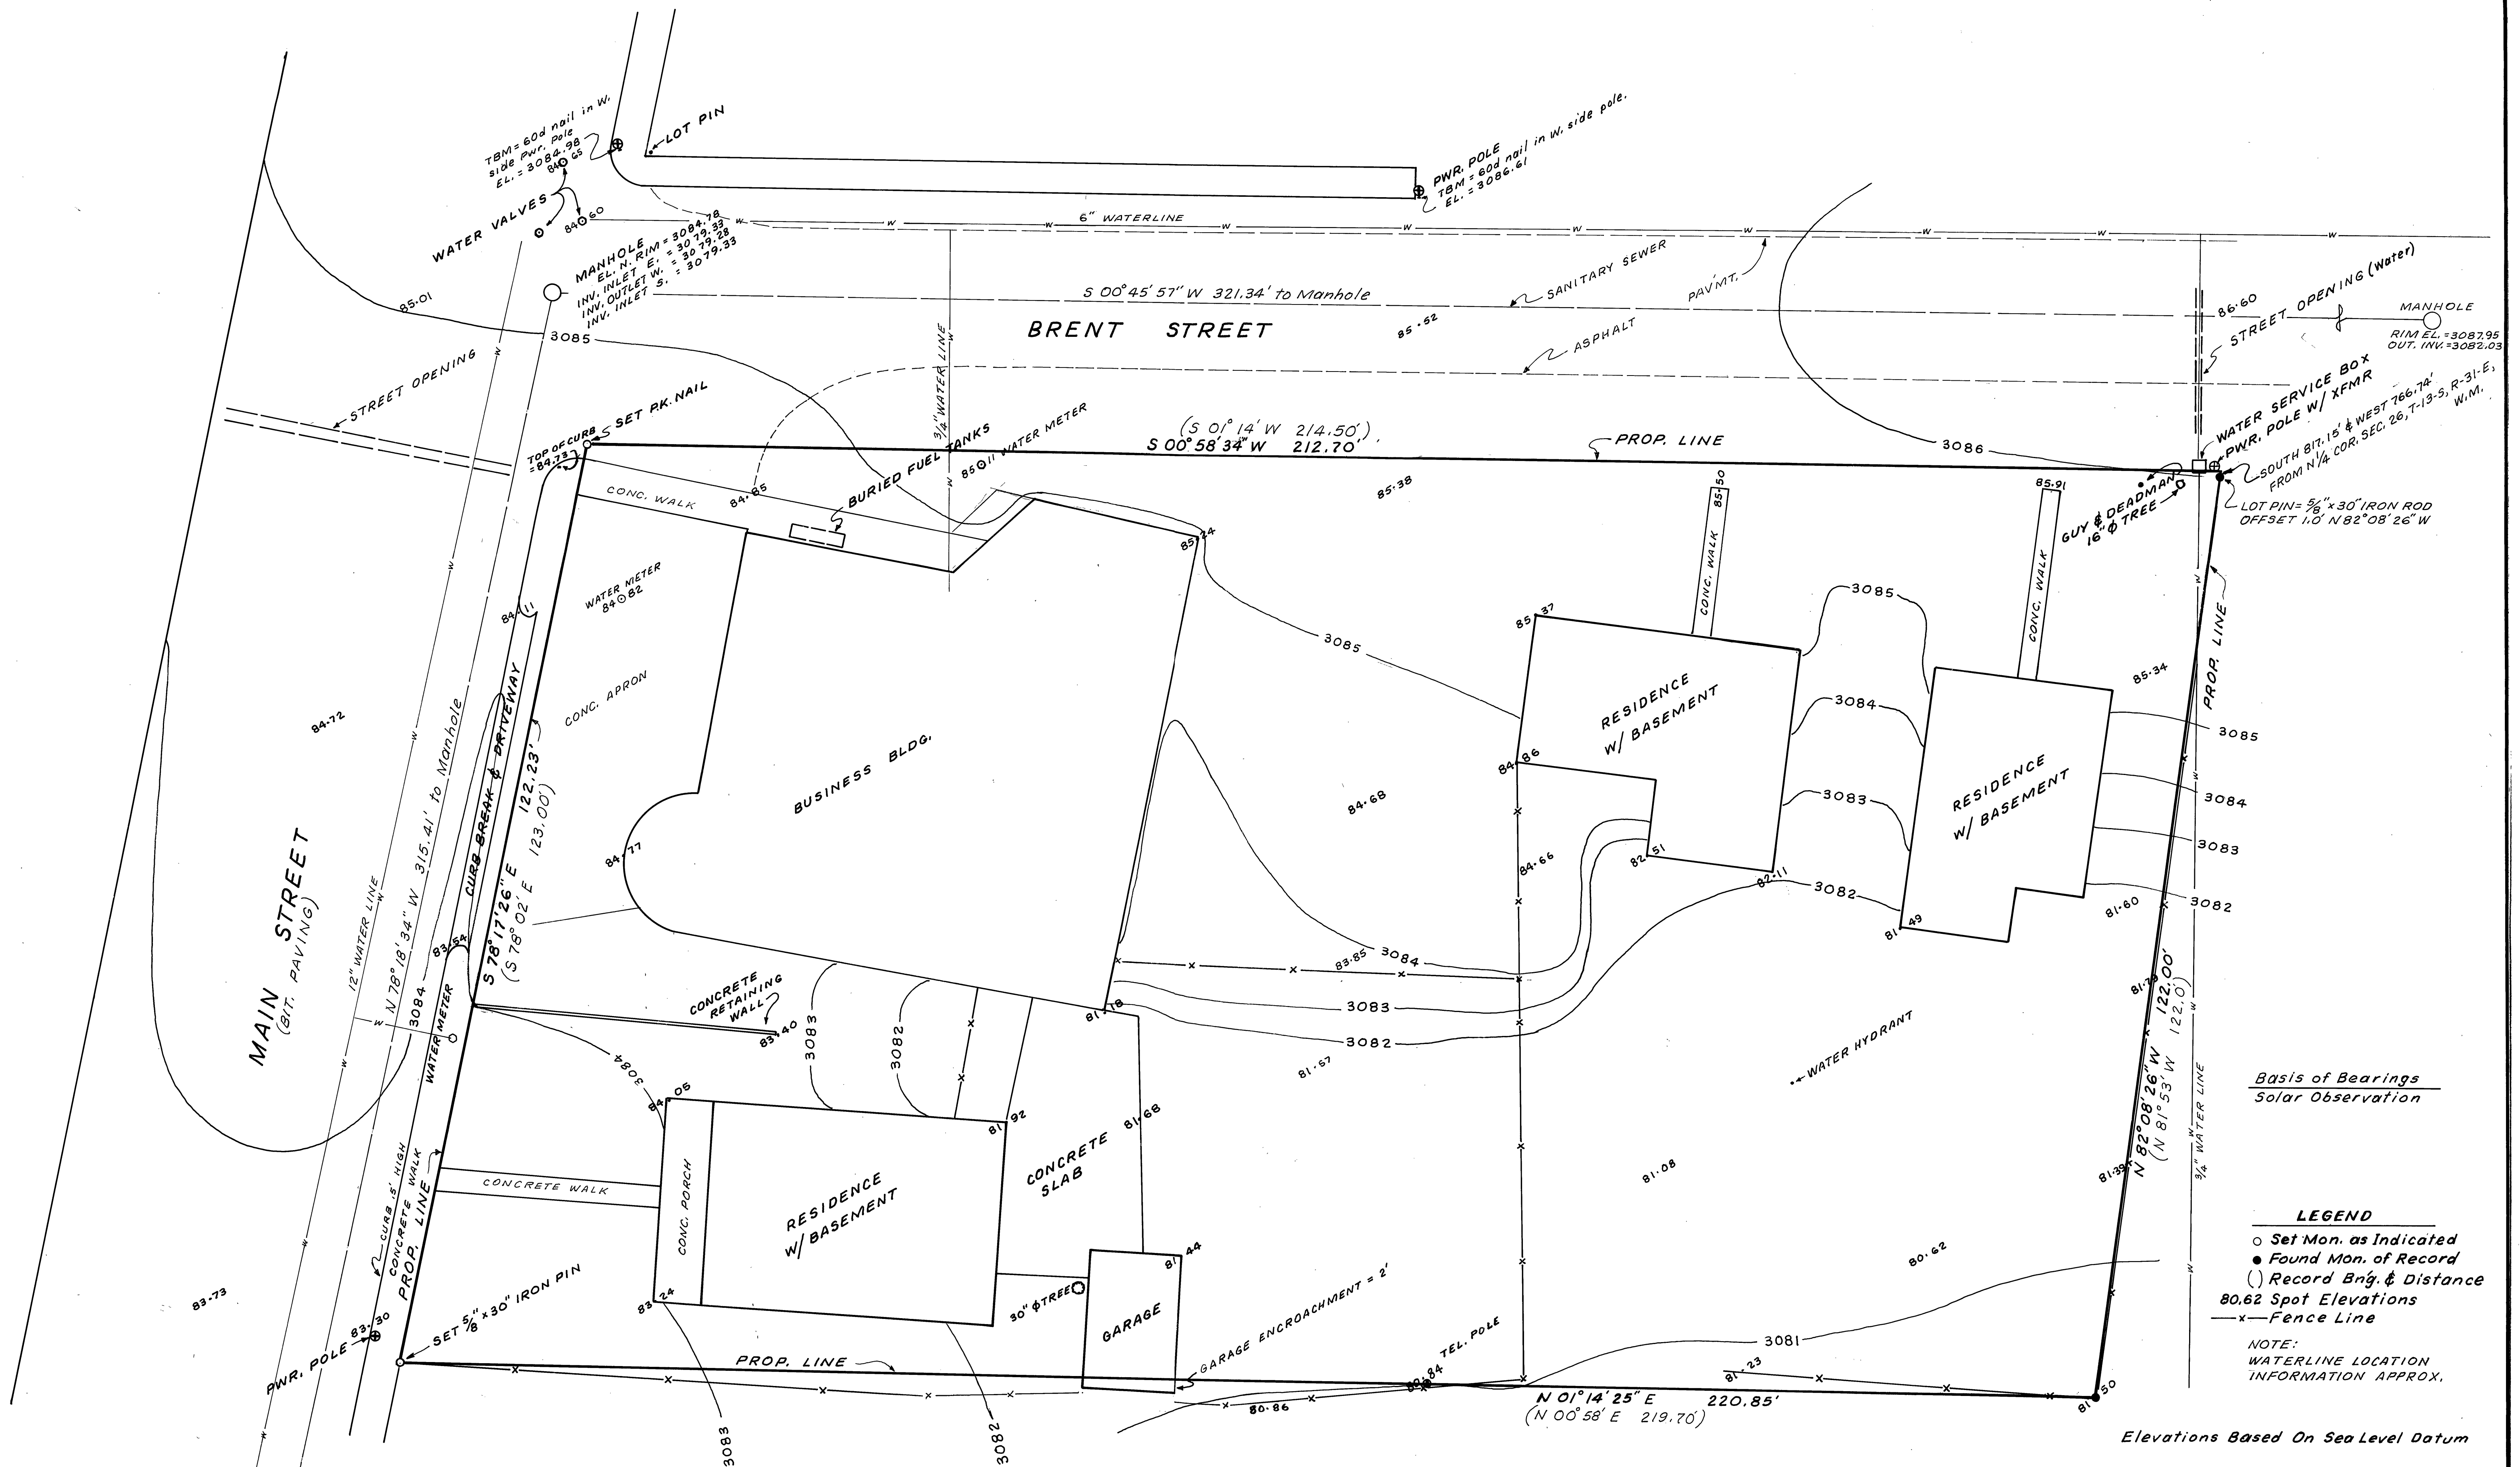

Basis of Bearings
Solar Observation

LEGEND

- Set Mon. as Indicated
- Found Mon. of Record
- () Record Bng. & Distance
- 80.62 Spot Elevations
- x- Fence Line

NOTE:
WATERLINE LOCATION
INFORMATION APPROX.

Elevations Based On Sea Level Datum

RECEIVED AND
FILED

JUL 28 1975
JOHN LIVEIRA, County Clerk

By _____ Deputy

REGISTERED
PROFESSIONAL
LAND SURVEYOR

Robert D. Bagett

OREGON
JULY 12, 1963
ROBERT D. BAGETT
598

BAGETT, GRIFFITH & ASSOCIATES
John Day, Oregon
Map of Survey

LOT 1, BLOCK J
City of John Day -

GRANT COUNTY, OREGON

SURVEYED FOR FIRST NATIONAL BANK

SURVEYED BY R.D.B., T.L.C., S.R.C. JUNE '75

Scale: 1" = 10' Drawn by: T.L.C. JUNE '75

MAP OF SURVEY NO. 370