


PLAT OF SURVEY
OF A TRACT OF LAND IN
DIXIE MEADOWS GOLD MINES
M.S. 513 SEC 23 T11S R33E W.M.
GRANT CO. OREGON
DIXIE MEADOWS GOLD MINES LTD.

BASIS OF BEARING:
BEARING BASED UPON THE PLAT
OF THE CLAIM OF "DIXIE MEADOWS
GOLD MINING CO." SURVEYED IN
1903 BY JOSEPH REESE.

30 JUNE 1975
SCALE 1" = 100'



○: SET 5/8" I.R. WITH
YELLOW PLASTIC CAP
MARKED "P.C." ON TOP

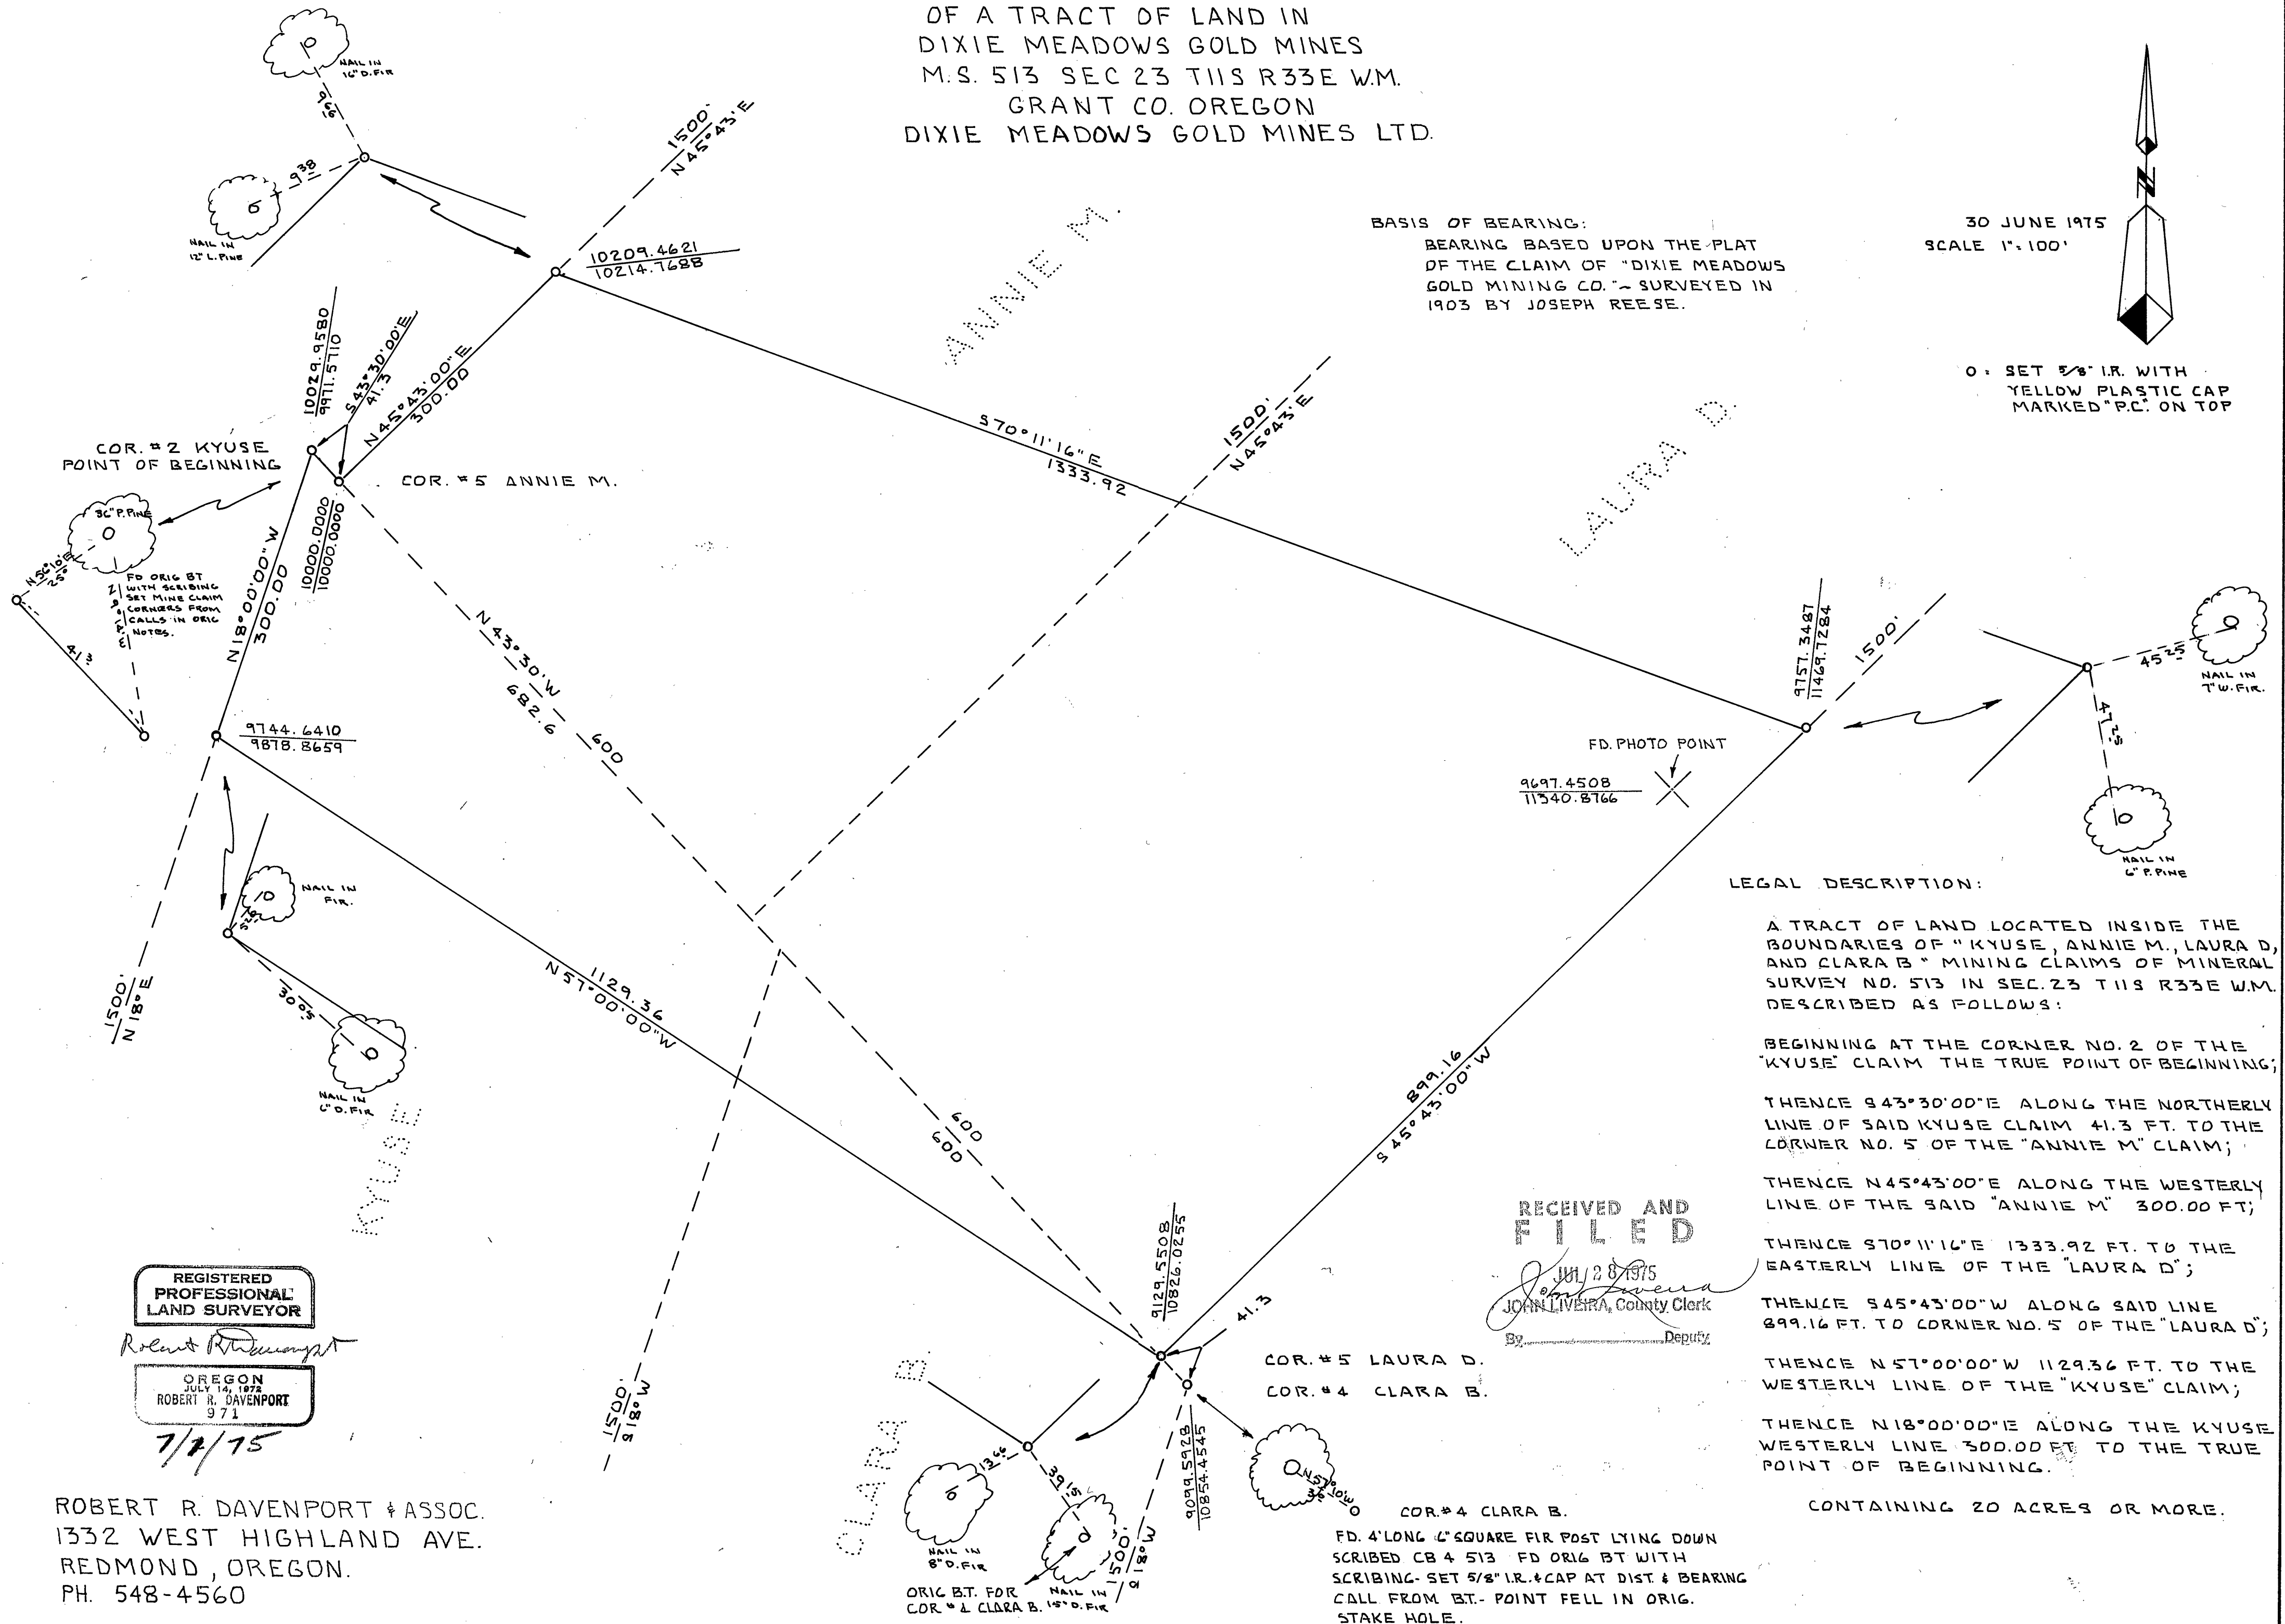

LEGAL DESCRIPTION:

A TRACT OF LAND LOCATED INSIDE THE
BOUNDARIES OF "KYUSE, ANNIE M., LAURA D,
AND CLARA B." MINING CLAIMS OF MINERAL
SURVEY NO. 513 IN SEC. 23 T11S R33E W.M.
DESCRIBED AS FOLLOWS:

BEGINNING AT THE CORNER NO. 2 OF THE
"KYUSE" CLAIM THE TRUE POINT OF BEGINNING;

THENCE S43°30'00"E ALONG THE NORTHERLY
LINE OF SAID KYUSE CLAIM 41.3 FT. TO THE
CORNER NO. 5 OF THE "ANNIE M" CLAIM;

THENCE N45°43'00"E ALONG THE WESTERLY
LINE OF THE SAID "ANNIE M" 300.00 FT;

THENCE S70°11'16"E 1333.92 FT. TO THE
EASTERLY LINE OF THE "LAURA D";

THENCE S45°43'00"W ALONG SAID LINE
899.16 FT. TO CORNER NO. 5 OF THE "LAURA D";

THENCE N57°00'00"W 1129.36 FT. TO THE
WESTERLY LINE OF THE "KYUSE" CLAIM;

THENCE N18°00'00"E ALONG THE KYUSE
WESTERLY LINE 300.00 FT TO THE TRUE
POINT OF BEGINNING.

CONTAINING 20 ACRES OR MORE.

RECEIVED AND
FILED

JUL 28 1975
JOHN LIVERA, County Clerk
By Deputy

COR. #5 LAURA D.
COR. #4 CLARA B.

COR. #4 CLARA B.

FD. 4' LONG 4" SQUARE FIR POST LYING DOWN
SCRIBED CB 4 513 FD ORIG BT WITH
SCRIBING- SET 5/8" I.R. + CAP AT DIST & BEARING
CALL FROM BT. POINT FELL IN ORIG.
STAKE HOLE.

REGISTERED
PROFESSIONAL
LAND SURVEYOR

Robert R. Davenport

OREGON
JULY 14, 1972
ROBERT R. DAVENPORT
971

7/2/75

ROBERT R. DAVENPORT & ASSOC.
1332 WEST HIGHLAND AVE.
REDMOND, OREGON.
PH. 548-4560