


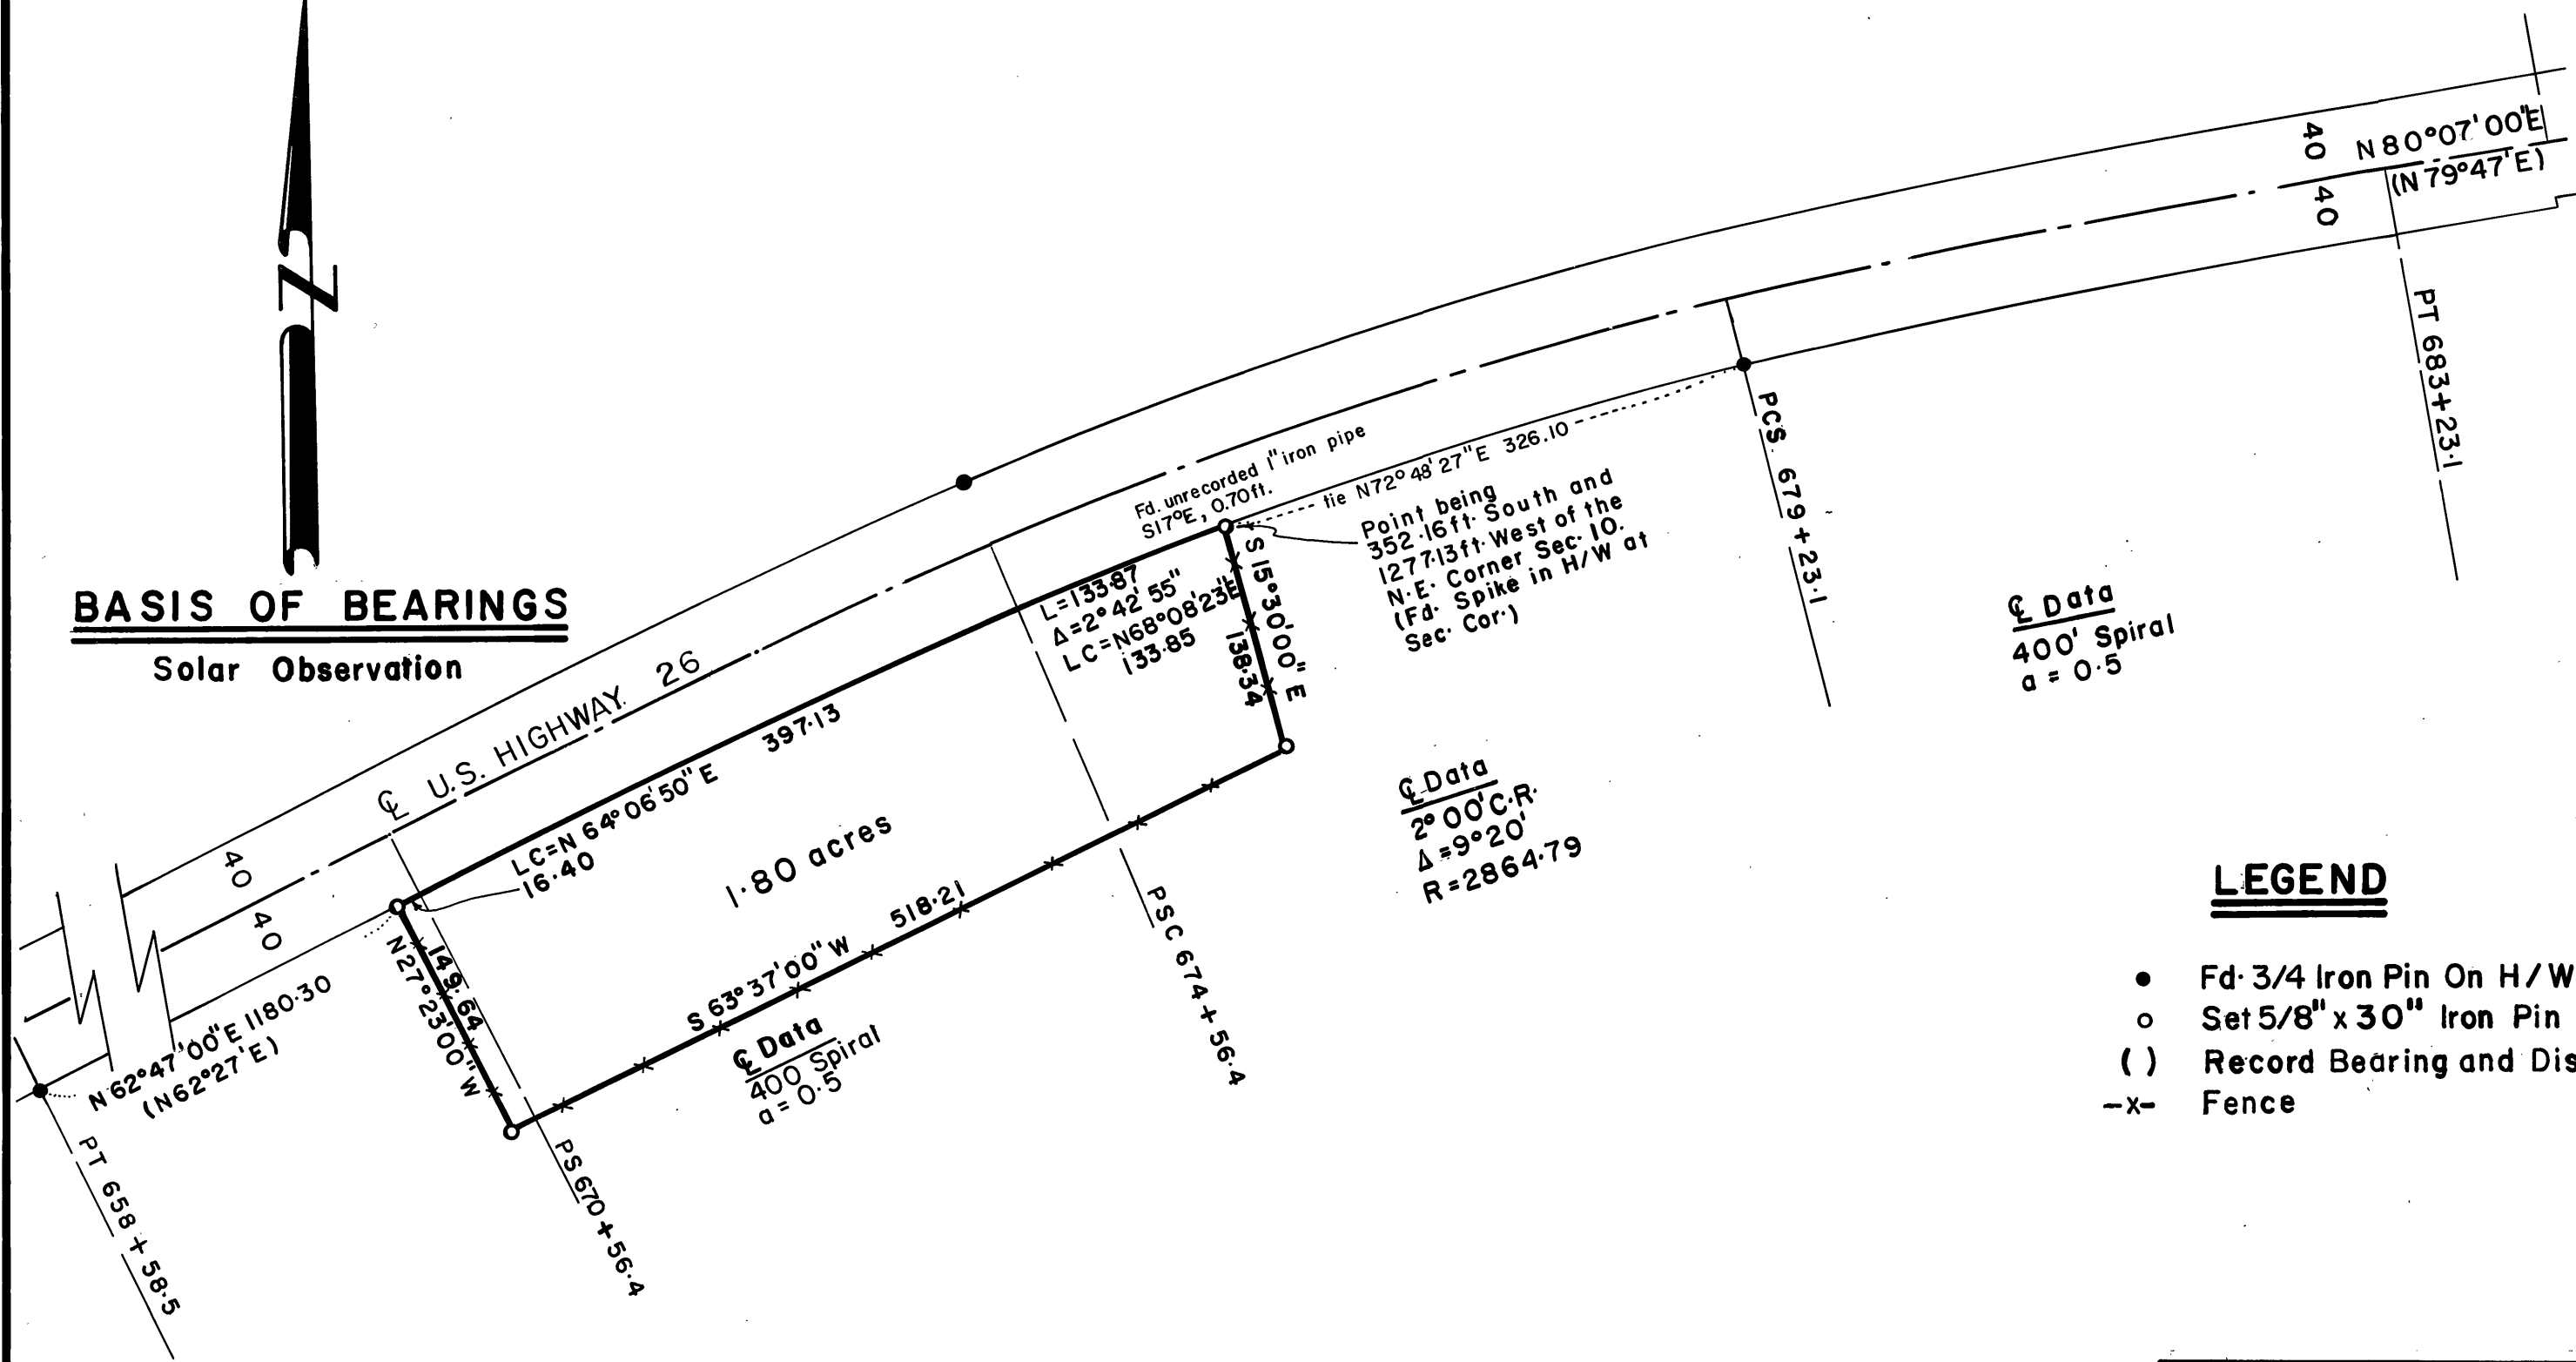

BASIS OF BEARINGS

Solar Observation



LEGEND

- Fd. 3/4 Iron Pin On H/W R. O. W.
- Set 5/8" x 30" Iron Pin
- () Record Bearing and Distance
- x- Fence

RECEIVED AND
FILED
NOV 10 1975
John Loefer
JUN LIVERMORE County Clerk

REGISTERED
PROFESSIONAL
LAND SURVEYOR

Robert D. Baggett

OREGON
JULY 12, 1953
ROBERT D. BAGGETT
598

BAGETT, GRIFFITH & ASSOCIATES

John Day, Oregon

Map of Survey

A TRACT OF LAND SITUATED IN THE
NE 1/4 OF SEC. 10, T.13S, R.33E., W.M.

GRANT COUNTY, OREGON

SURVEYED FOR	MILTON GOFF	
SURVEYED BY	R. D. B. - W. G.	10-1975
Scale: 1" = 100'	Drawn by: W. G.	10-1975

SURVEY NO. 383