Sec. Cor. Position determined from Orig. BT. in sec. 11
Set G.C.S. BRASS CAP
Scribed New BTs.
A 12" Pine brs. N50°E 41.1 ft. mkd. T14S R32E S1 CSBT.
A 6" Juniper brs. S43°E 4.6 ft. mkd. T14S R32E S12 CSBT.
A 9" Juniper brs. S55°W 25.6 ft. mkd. T14S R32E S11 CSBT.
A 10" Pine brs. N28°W 42.6 ft. mkd. T14S R32E S2 CSBT.

QLD BT
A 22" Pine stump brs. S20°W 38.3 ft. mkd. 11 T14 R32 BT.

At N1/4 cor.
No orig. cor. evidence fd.
Set G.C.S. BRASS CAP at proportionate dist.
Scribed New BTs.
A 10" Pine brs. N34°E 12.6 ft. mkd. 1/4 S1 CSBT.
A 9" Pine brs. S84°W 14.5 ft. mkd. 1/4 S12 CSBT.
From 1/4 cor.
A 1/2" iron pipe brs. N49°48'E., 6.0 ft.

Sec. cor. position determined from record distance from 2 BTs (also fd. 1/2" X 12" iron pipe at this position)
Set G.C.S. BRASS CAP
From which old BTs.
A 24" Pine brs. N84°E 54.8 ft. mkd. S6 T14 33 in partially healed blaze.
A 34" Pine snag brs. S25°E 30.4 ft. mkd. S7 T14 R33 BT.
Scribed New BTs.
A 13" Pine brs. S66°E 65.0 ft. mkd. T14S R33E S7 CSBT.
A 14" Pine brs. S59°W 48.9 ft. mkd. T14S R32E S12 CSBT.
A 15" Pine brs. N8° W 67.8 ft. mkd. T14S R32E S1 CSBT.

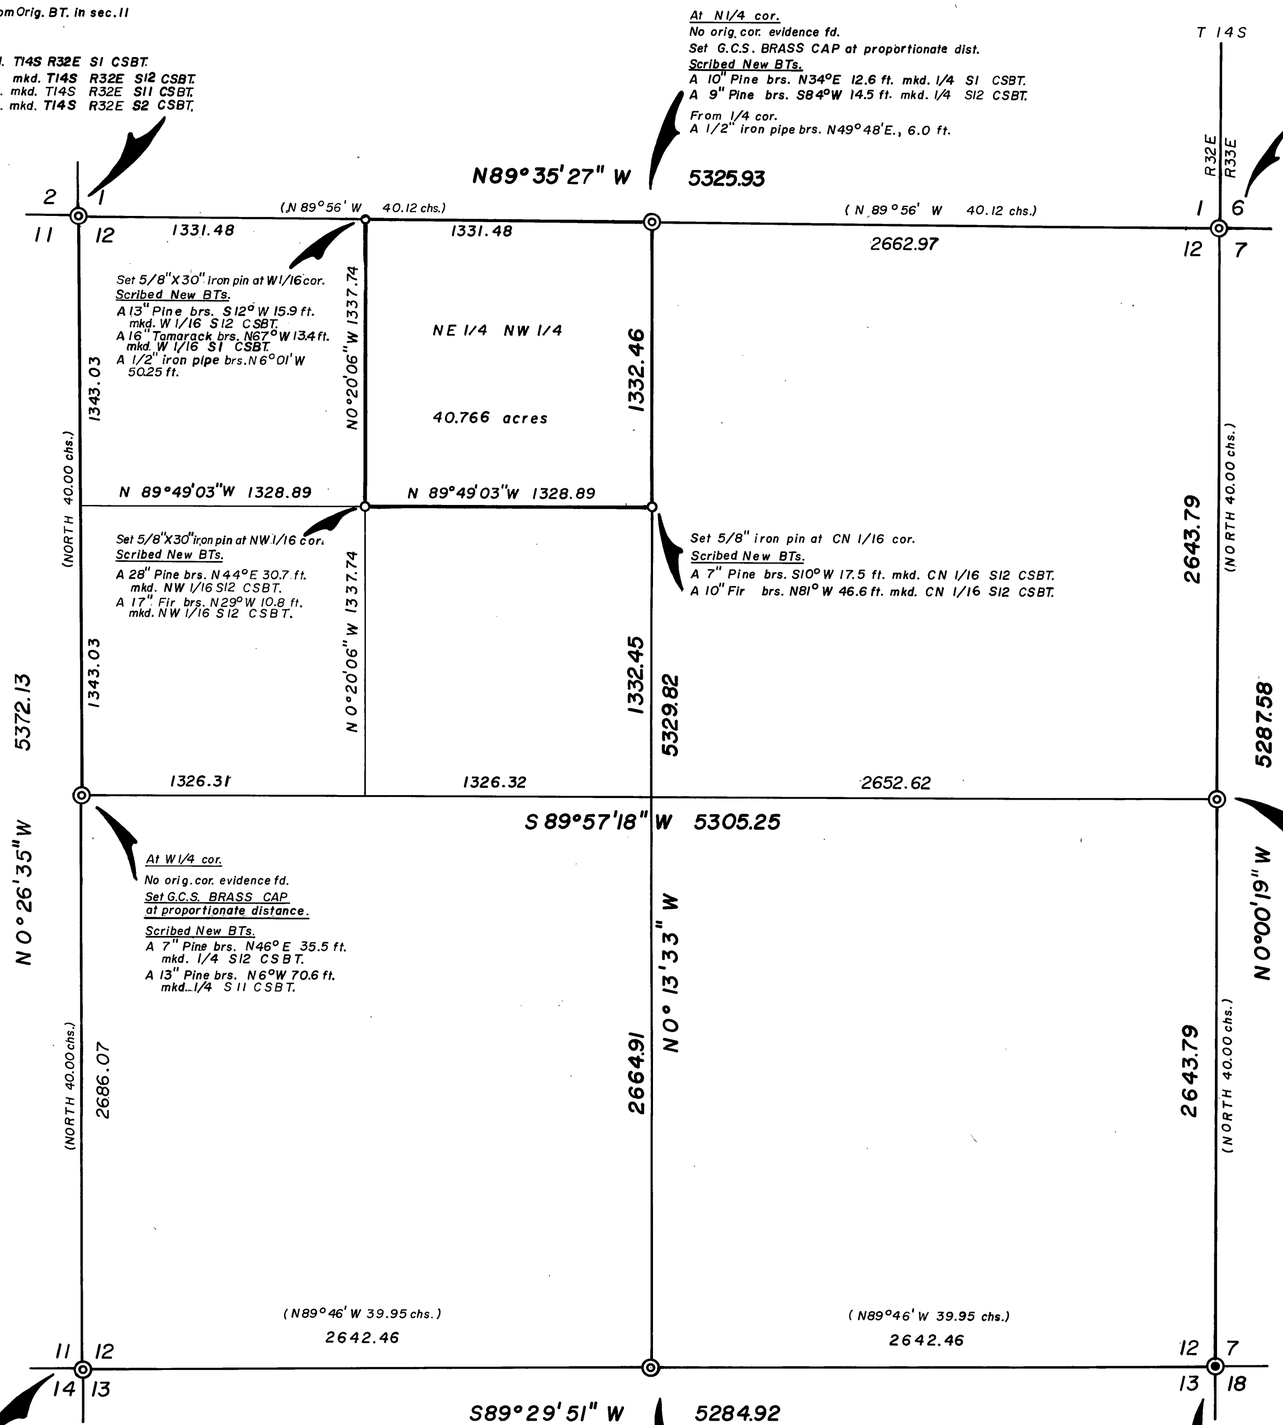

Sec. cor. position determined by using E-W blazeline for northing control and record dist. of 158.4 ft. (2.40 chs.) E. of creek, as called for in orig. notes
Set G.C.S. Brass Cap
Scribed New BTs.
A 7" Pine brs. N56°E 101.0 ft. mkd. T14S R32E S12 CSBT.
A 18" Pine brs. S19°W 41.2 ft. mkd. T14S R32E S14 CSBT.
A 14" Fir brs. N21°W 39.0 ft. mkd. T14S R32E S11 CSBT.

At S1/4 cor.
No evidence of orig. 1/4 cor. fd.
Set G.C.S. BRASS CAP at proportionate dist.
Scribed New BTs.
A 8" Fir brs. S14°W 28.2 ft. mkd. 1/4 S13 CSBT.
A 18" Pine brs. S87°E 29.2 ft. mkd. 1/4 S13 CSBT.

Fd. Orig. Cor. Tree; A 34" Pine blazed on 4 sides from which G.L.O. Brass Cap brs. N30°E 2 ft. marked as sec. cor. & dated 1939.
A 22" Pine stump brs. N38°E 36.3 ft. mkd. T14S R33E S7 BT (1939 survey).
A 28" Pine brs. N 25° W 9.2 ft. mkd. S12 T14S R32E BT (1939 survey).

I find no record of the G.L.O. Brass Cap and the 1939 BTs.
I did not find any of the orig. BTs.

RECEIVED AND FILED
NOV 10 1975
JOHN LIVEIRA, County Clerk
By _____ Deputy

N

BASIS OF BEARINGS

Solar Observation

LEGEND

- ◉ Fd. Orig. Corner
- ◎ Fd. acceptable cor. evidence, set G.C.S. Brass Cap
- o Set 5/8" X 30" iron pin
- ( ) Record Bearing Distance

REGISTERED PROFESSIONAL LAND SURVEYOR
Robert D. Bagett
OREGON
JULY 12, 1963
ROBERT D. BAGETT
598

NOTE:
SEE SEC. COR. REMONUMENTATION SHEETS RECORDED WITH THIS PLAT FOR DESCRIPTION OF EACH MONUMENT SET AND BEARING TREES TAKEN.

BAGETT, GRIFFITH & ASSOCIATES
John Day, Oregon

Map of Survey
SUBDIVISION AND LINES OF
NE1/4 NW1/4 SEC. 12 T.14S. R.32E.
W.M.
GRANT COUNTY, OREGON

SURVEYED FOR	VERL BROUGH	
SURVEYED BY	R. D. B. & W. G.	OCT. 1975
Scale: 1"= 500'	Drawn by: W. G.	OCT. 1975

MAP OF SURVEY NO. 384