


BASIS OF BEARINGS
 RECORD BEARING CENTER SEC. LINE
 SECTION 21, T13S, R30E, W.M.
 (SEE MAP OF SURVEY NO. 164)

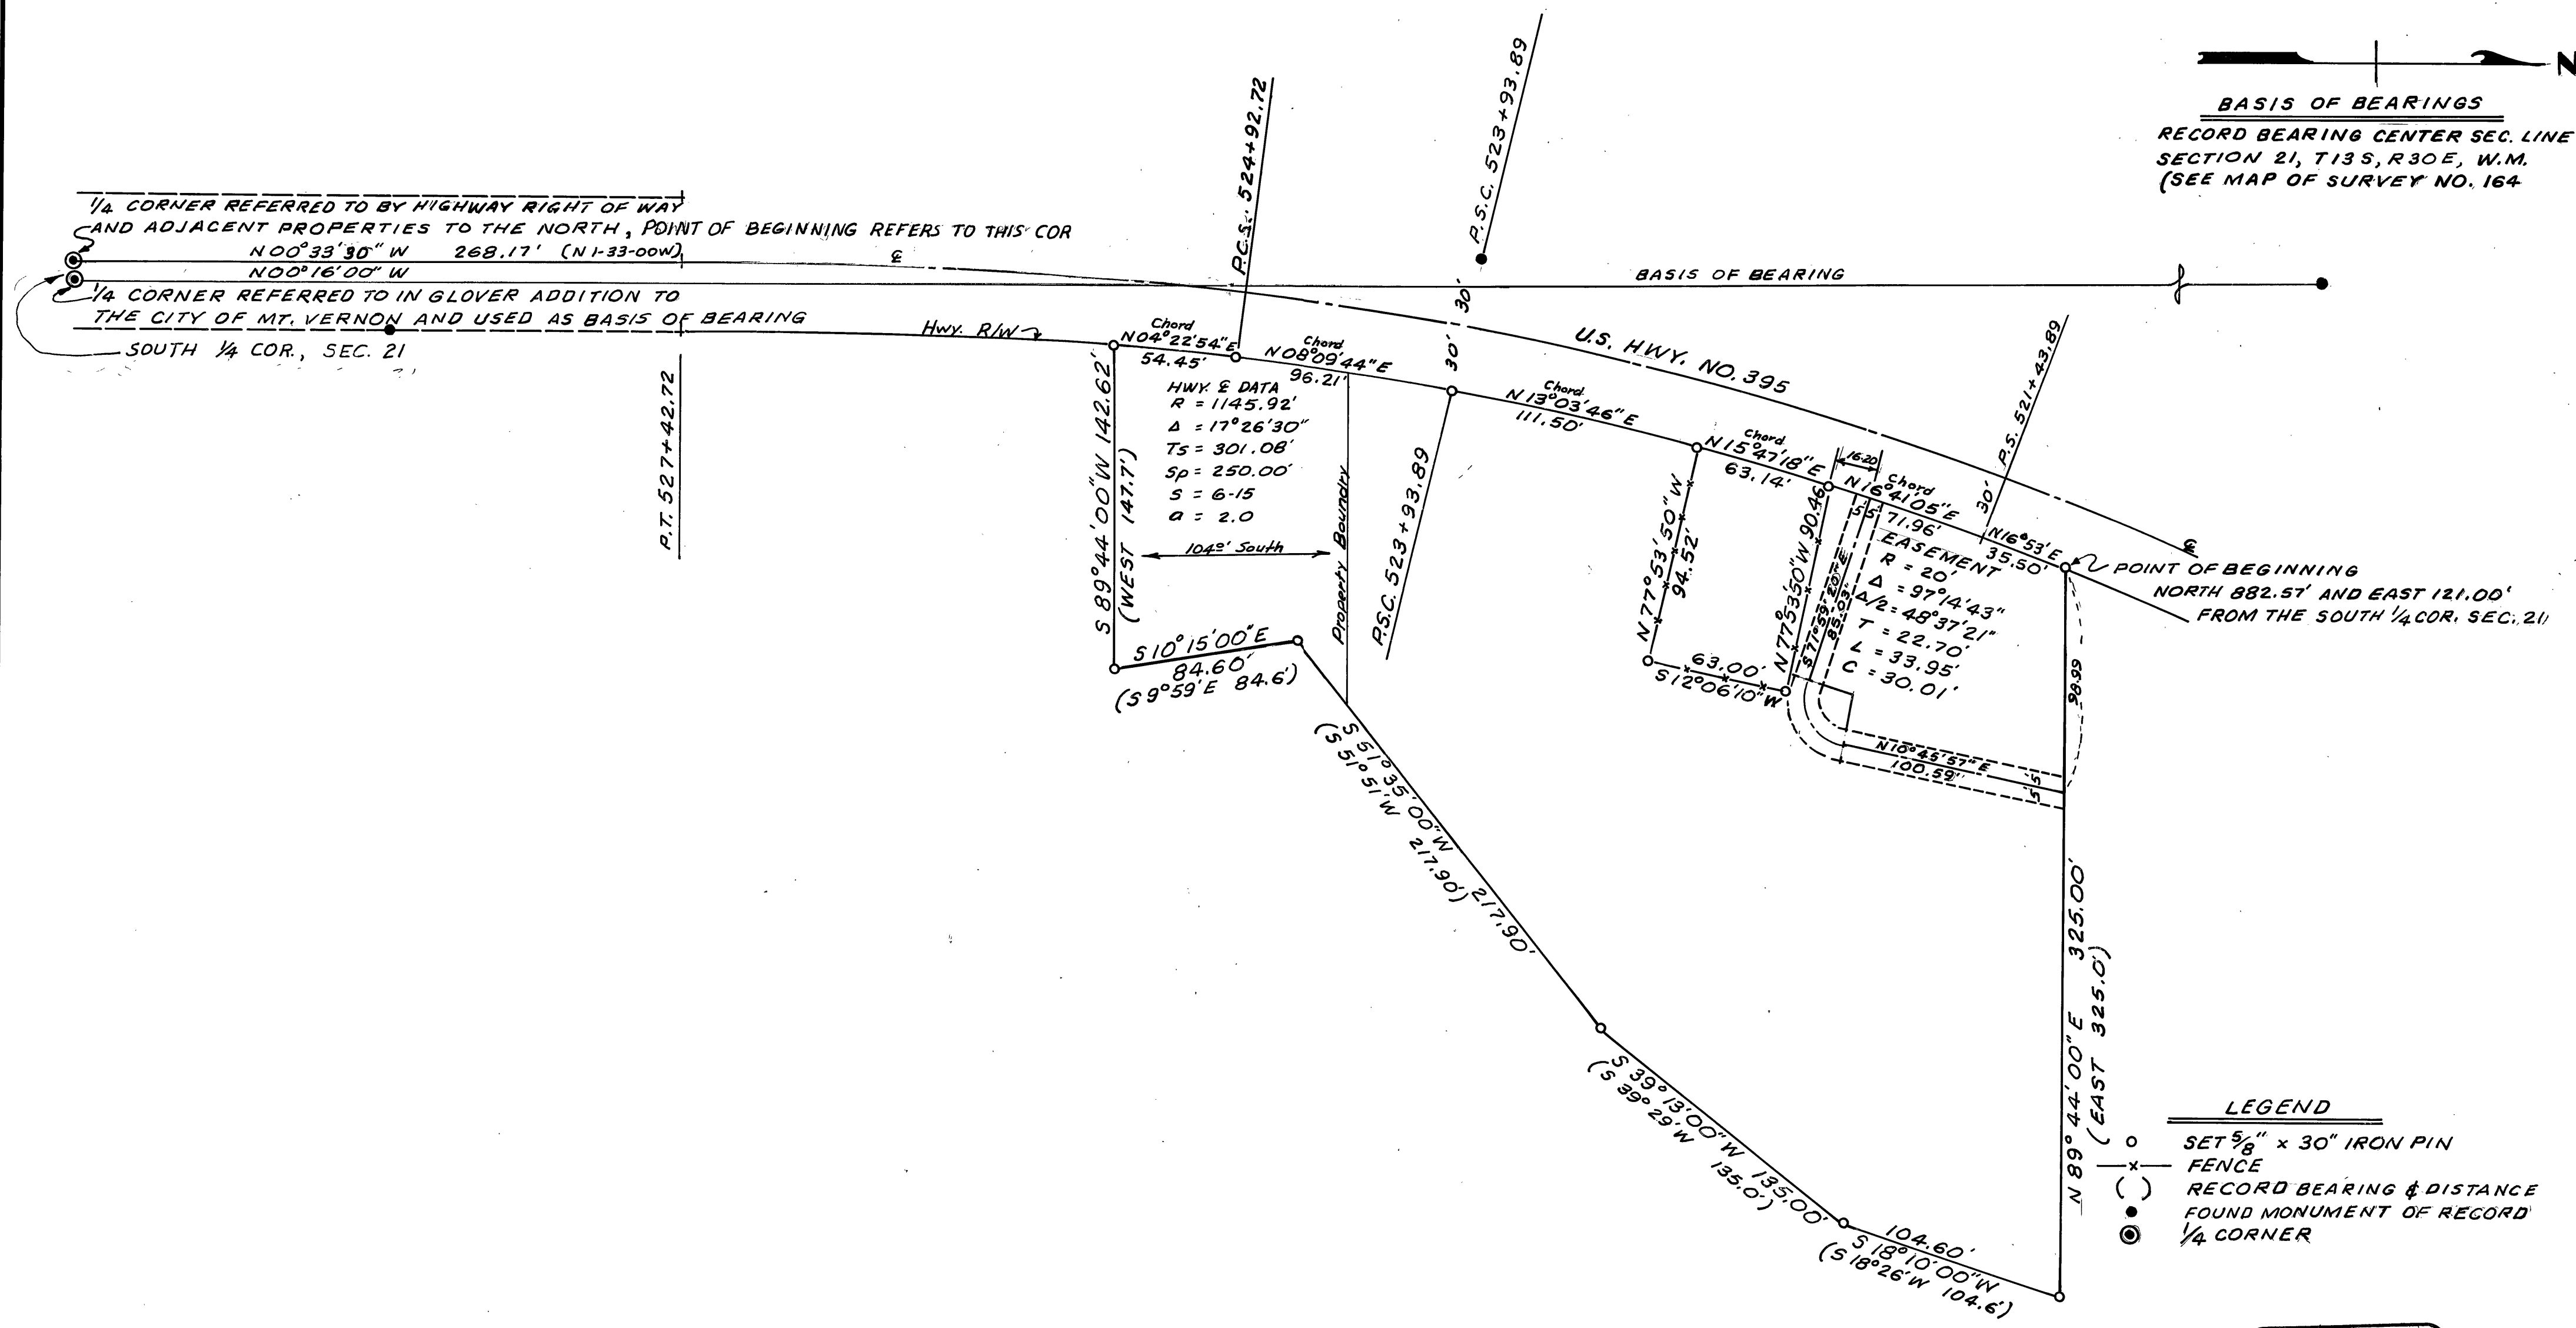

LEGEND

- SET 5/8" x 30" IRON PIN
- FENCE
- () RECORD BEARING & DISTANCE
- FOUND MONUMENT OF RECORD 1/4 CORNER

REGISTERED
 PROFESSIONAL
 LAND SURVEYOR

OREGON
 JULY 12, 1989
 DOUGLAS M. FERGUSON
 848

RECEIVED AND
 FILED

DEC 10 1975
 JOHN LIVERA, County Clerk
 By _____ Deputy

OREGON EAST ENGINEERING INC. MT. VERNON, OREGON		
MAP OF SURVEY NORDENGREN PROPERTY LOCATED IN SECTION 21, T13S, R30E, W.M.		
FOR	DAVID NORDENGREN	
SURVEYED BY	D.M. FERGUSON	
DRAWN BY T.L.C.	OCT. 12, 1975	SCALE: 1" = 50'

MAP OF SURVEY NO. 386