


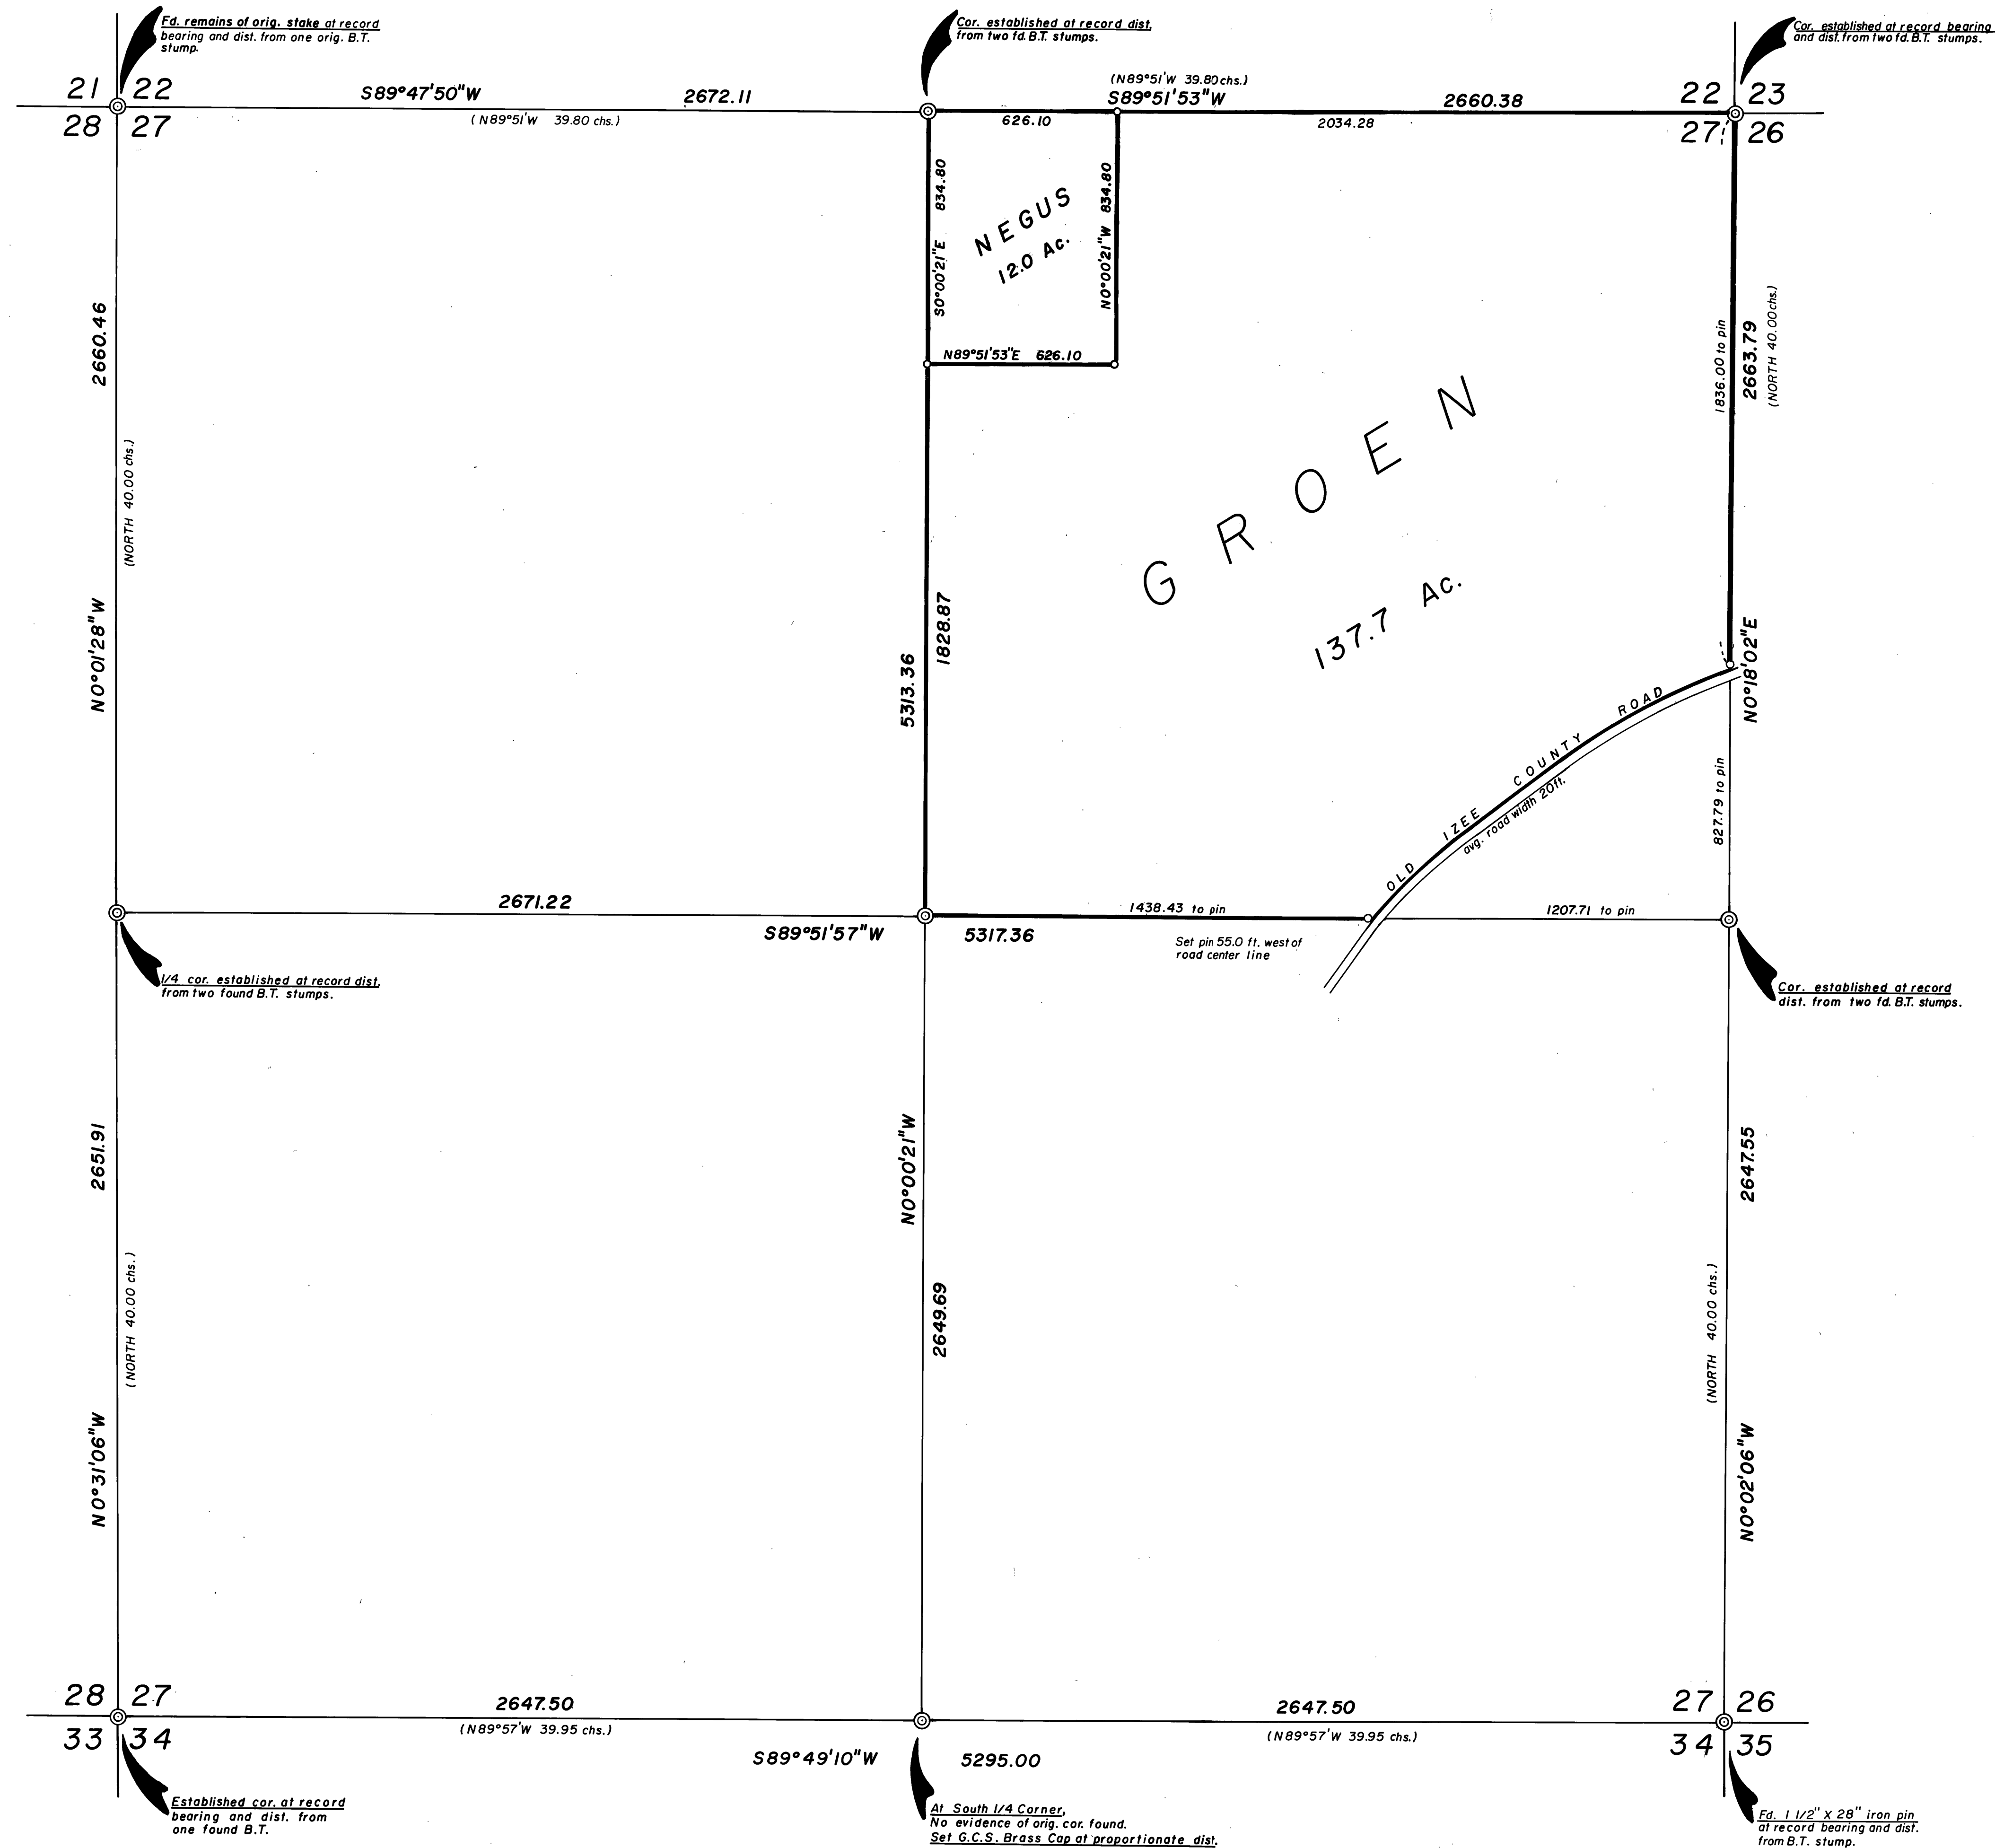

BASIS OF BEARINGS
SOLAR OBSERVATION

- LEGEND**
- ⊙ Set Grant County Surveyor Brass Cap
 - Set 5/8" x 30" iron pin
 - () Record Bearing and Distance

NOTE:
See sec. cor. remonumentation sheets recorded with this plat for description of each monument set and bearing tree taken.

RECEIVED A.
F. *John Rivera*

REGISTERED
PROFESSIONAL
LAND SURVEYOR

Robert D. Baggett
OREGON
JULY 12, 1988
ROBERT D. BAGGETT
598

BAGETT, GRIFFITH & ASSOCIATES		
John Day, Oregon		
Map of Survey		
SUBDIVISION OF SEC. 27		
T.15S., R.30E.,		
W.M.		
GRANT COUNTY, OREGON		
SURVEYED FOR	VERN GROEN & TOM NEGUS	
SURVEYED BY	R.D.B. & W.G.	12-75
Scale: 1"= 300'	Drawn by: W. G.	12-75