


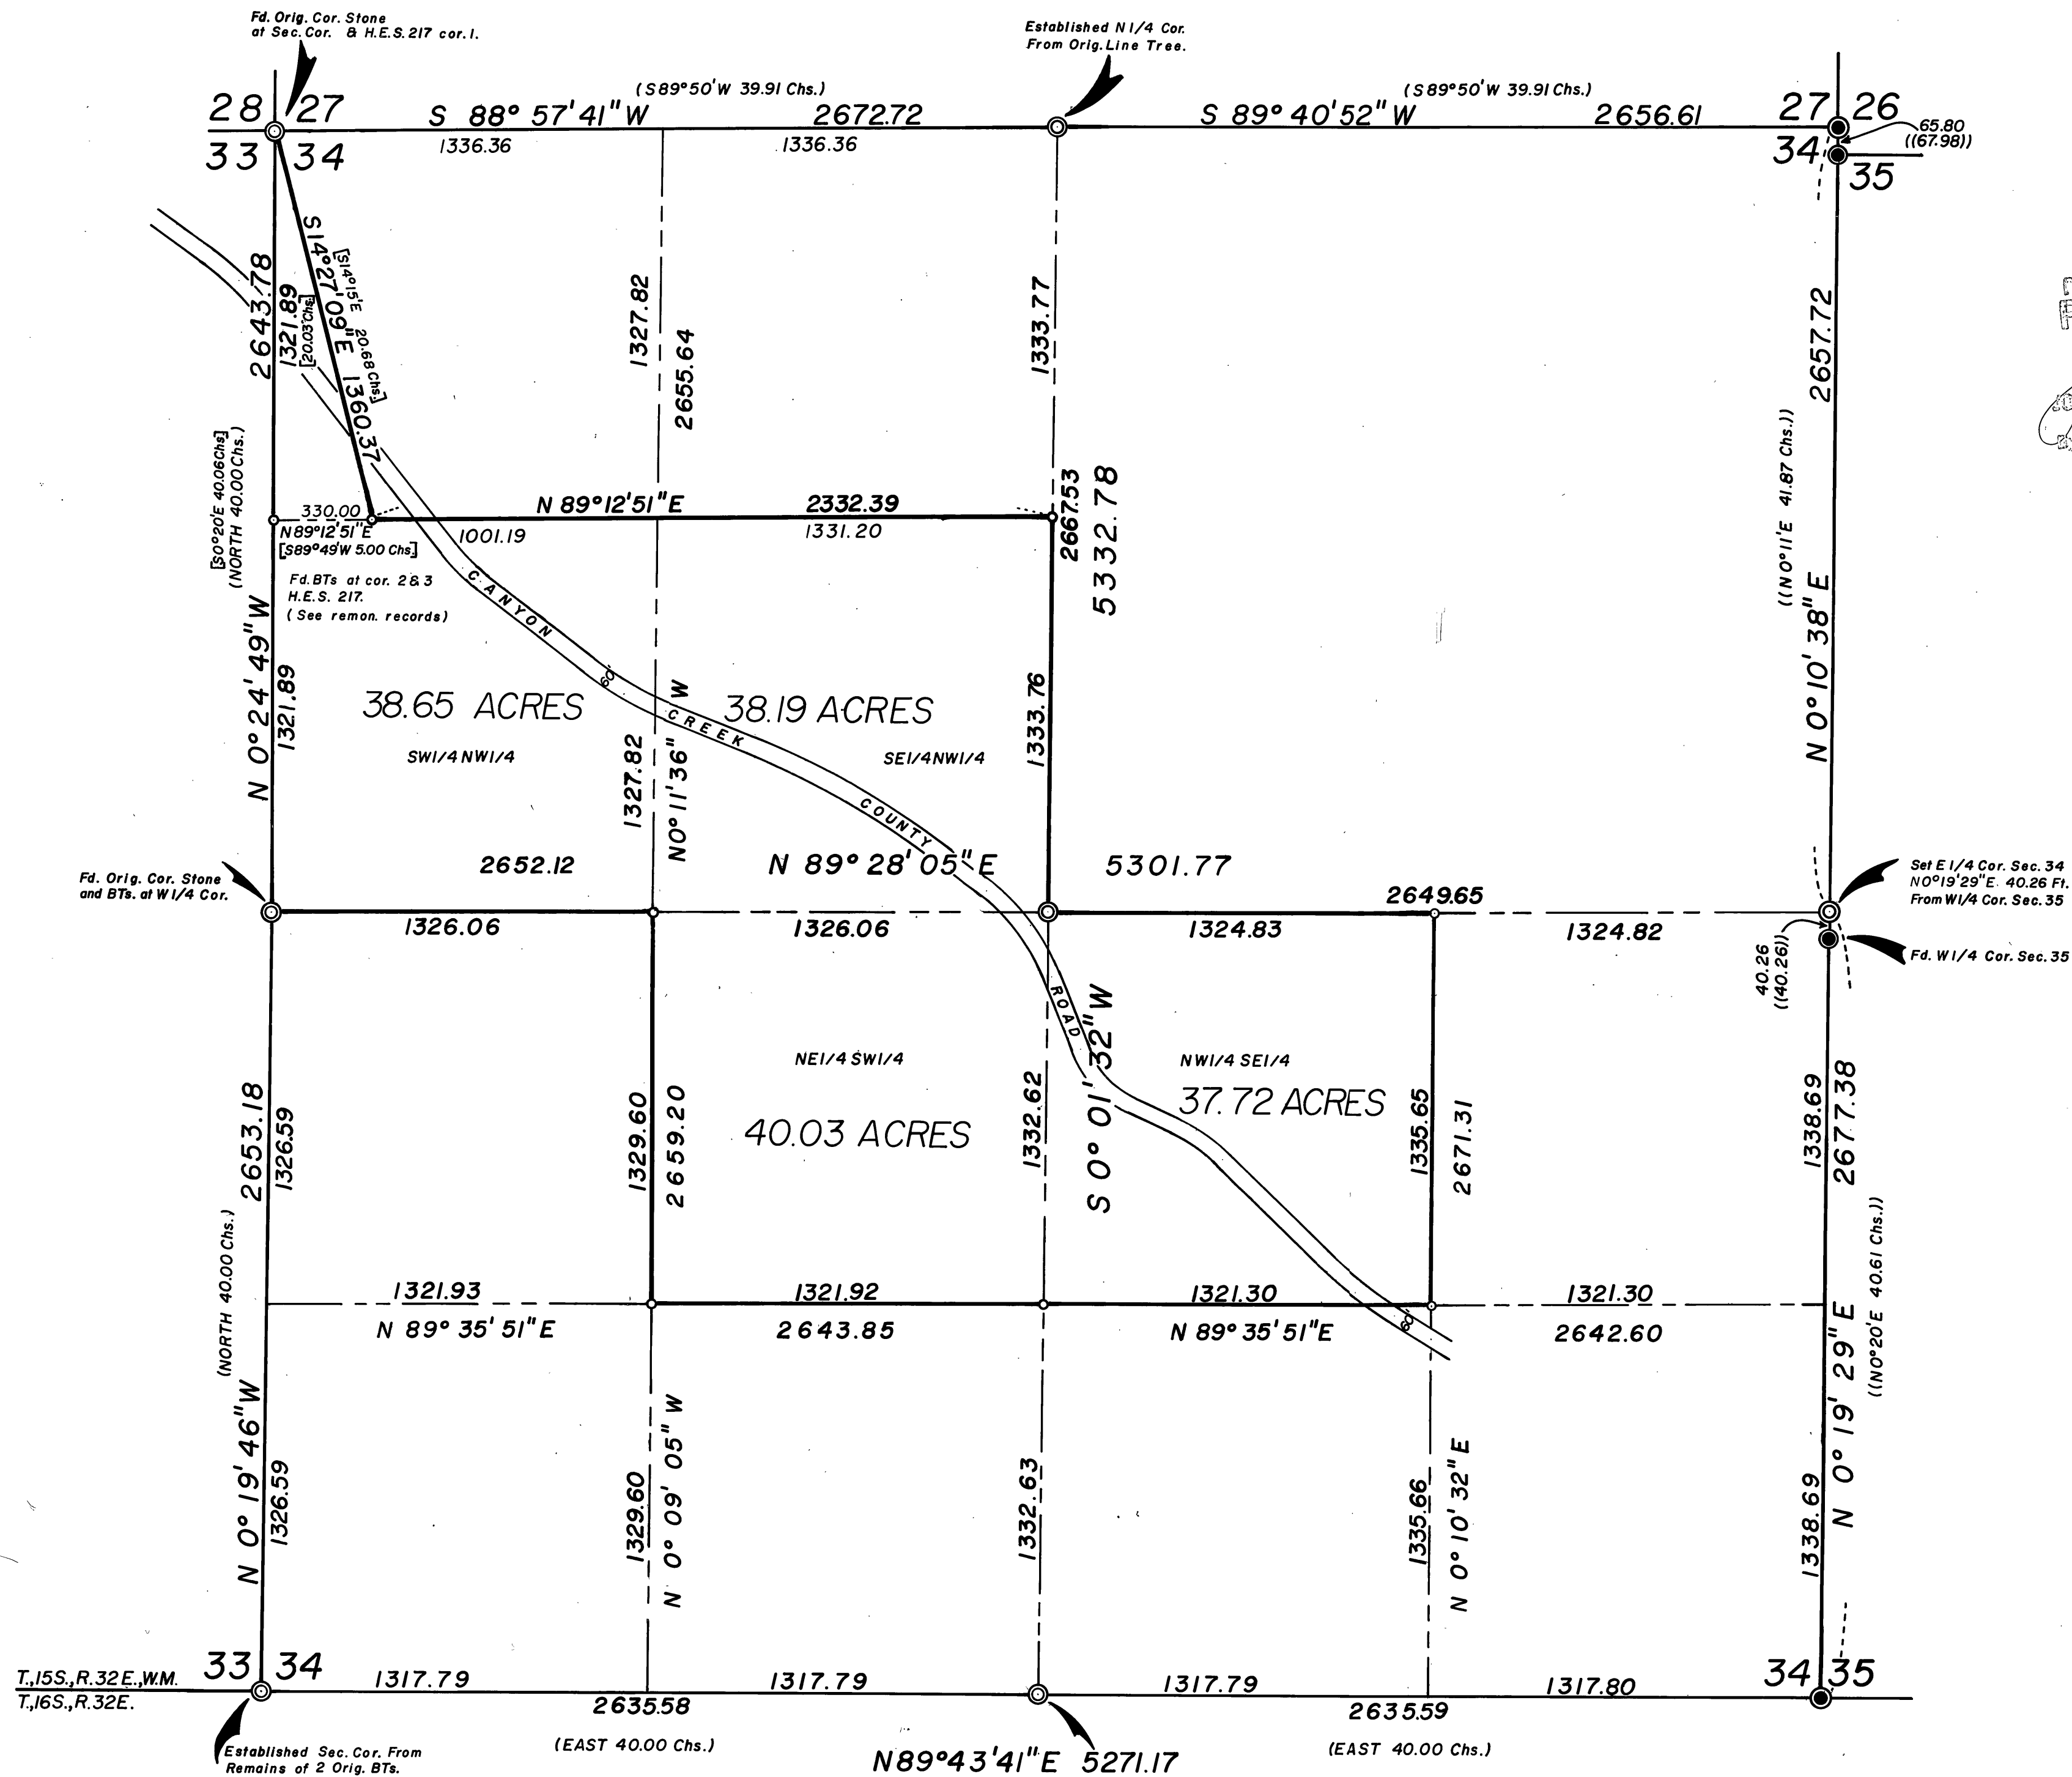

RECEIVED AND
FILED
John D. Baggett
REGISTERED PROFESSIONAL LAND SURVEYOR
JULY 12, 1983
ROBERT D. BAGGETT
598

BASIS OF BEARINGS

SOLAR OBSERVATION

REGISTERED
PROFESSIONAL
LAND SURVEYOR
Robert D. Baggett
OREGON
JULY 12, 1983
ROBERT D. BAGGETT
598

LEGEND

- SET GRANT COUNTY SURVEYOR BRASS CAP
- FD. G.L.O. BRASS CAP SET IN 1939 SURVEY BY GEO. F. RIGBY
- SET 5/8"X30" IRON PIN
- [] RECORD BEARING & DIST. H.E.S. NO. 217-1917
- () RECORD BEARING & DIST. ORIG. SURVEY-1881
- (()) RECORD BEARING & DIST.-1939 G.L.O. SURVEY

BAGETT, GRIFFITH & ASSOCIATES		
John Day, Oregon		
Map of Survey		
SUBDIVISION OF SEC. 34,		
TWP. 15 S., R. 32 E., W.M.		
GRANT COUNTY, OREGON		
SURVEYED FOR	GRACE K. WILLIAMS	
SURVEYED BY	R.D.B. & W.G.	2-76
Scale: 1"= 400'	Drawn by: W.G.	2-76