


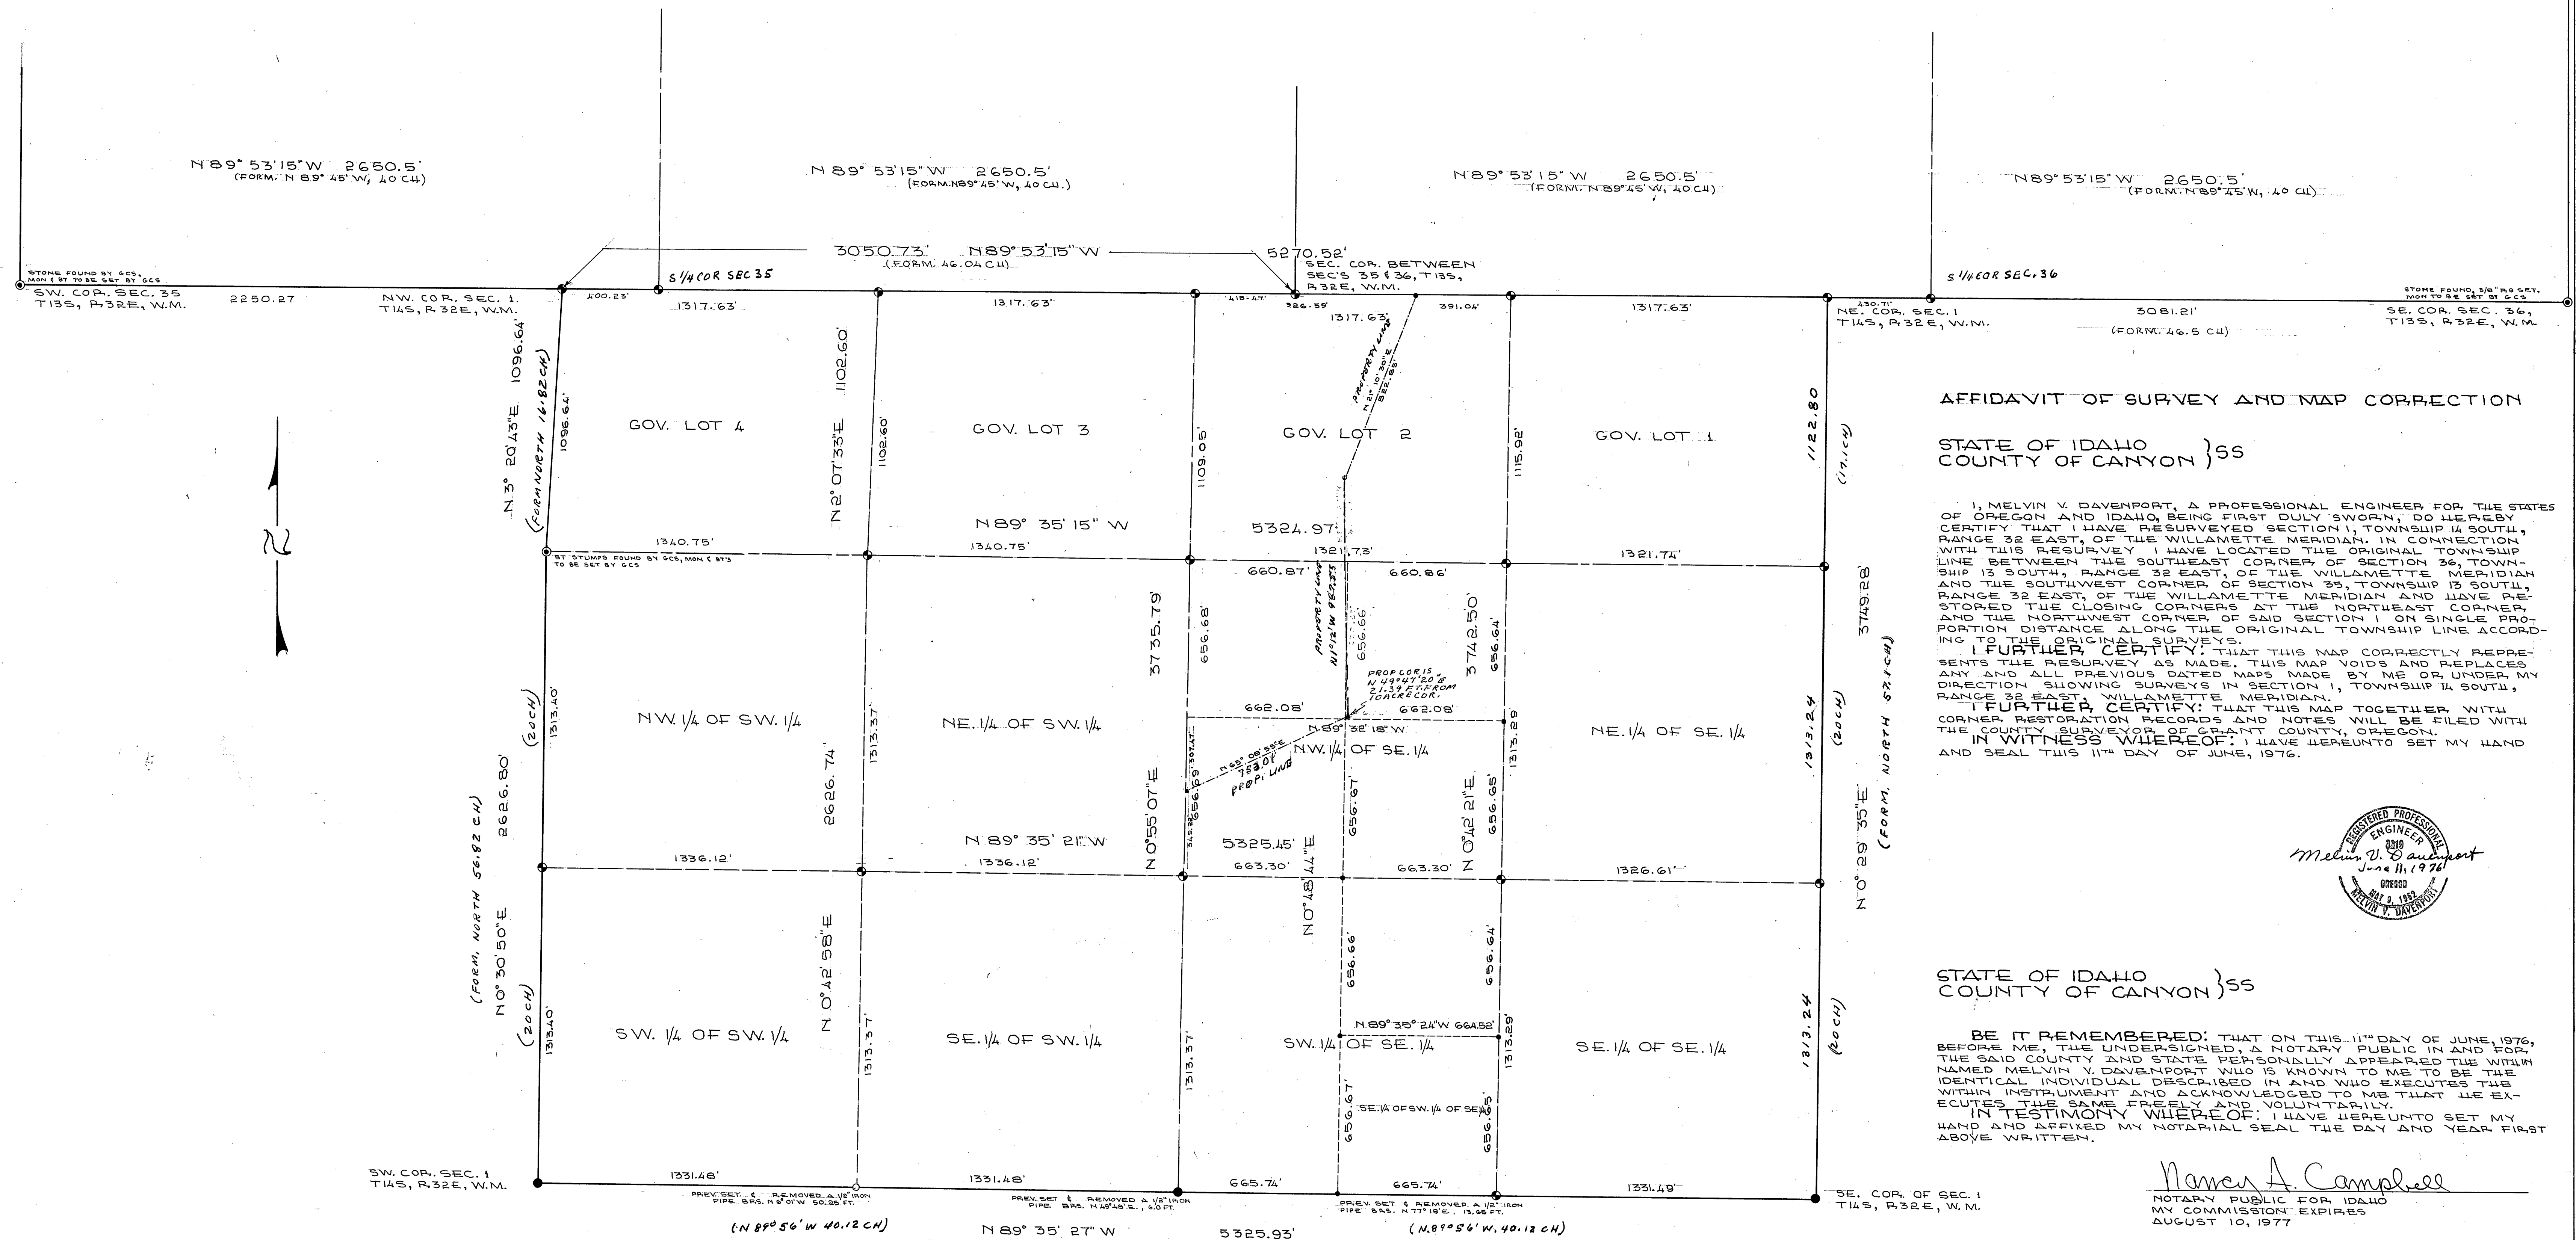

AFFIDAVIT OF SURVEY AND MAP CORRECTION

STATE OF IDAHO }
COUNTY OF CANYON } ss

I, MELVIN V. DAVENPORT, A PROFESSIONAL ENGINEER FOR THE STATES OF OREGON AND IDAHO, BEING FIRST DULY SWORN, DO HEREBY CERTIFY THAT I HAVE RESURVEYED SECTION 1, TOWNSHIP 14 SOUTH, RANGE 32 EAST, OF THE WILLAMETTE MERIDIAN. IN CONNECTION WITH THIS RESURVEY I HAVE LOCATED THE ORIGINAL TOWNSHIP LINE BETWEEN THE SOUTHEAST CORNER OF SECTION 36, TOWNSHIP 13 SOUTH, RANGE 32 EAST, OF THE WILLAMETTE MERIDIAN AND THE SOUTHWEST CORNER OF SECTION 35, TOWNSHIP 13 SOUTH, RANGE 32 EAST, OF THE WILLAMETTE MERIDIAN AND HAVE RESTORED THE CLOSING CORNERS AT THE NORTHEAST CORNER AND THE NORTHWEST CORNER OF SAID SECTION 1 ON SINGLE PROPORTION DISTANCE ALONG THE ORIGINAL TOWNSHIP LINE ACCORDING TO THE ORIGINAL SURVEYS.

I FURTHER CERTIFY THAT THIS MAP CORRECTLY REPRESENTS THE RESURVEY AS MADE. THIS MAP VOIDS AND REPLACES ANY AND ALL PREVIOUS DATED MAPS MADE BY ME OR UNDER MY DIRECTION SHOWING SURVEYS IN SECTION 1, TOWNSHIP 14 SOUTH, RANGE 32 EAST, WILLAMETTE MERIDIAN.

I FURTHER CERTIFY THAT THIS MAP TOGETHER WITH CORNER RESTORATION RECORDS AND NOTES WILL BE FILED WITH THE COUNTY SURVEYOR OF GRANT COUNTY, OREGON.

IN WITNESS WHEREOF: I HAVE HEREUNTO SET MY HAND AND SEAL THIS 11th DAY OF JUNE, 1976.

Melvin V. Davenport
June 11, 1976
Professional Engineer

STATE OF IDAHO }
COUNTY OF CANYON } ss

BE IT REMEMBERED: THAT ON THIS 11th DAY OF JUNE, 1976, BEFORE ME, THE UNDERSIGNED, A NOTARY PUBLIC IN AND FOR THE SAID COUNTY AND STATE PERSONALLY APPEARED THE WITHIN NAMED MELVIN V. DAVENPORT WHO IS KNOWN TO ME TO BE THE IDENTICAL INDIVIDUAL DESCRIBED IN AND WHO EXECUTES THE WITHIN INSTRUMENT AND ACKNOWLEDGED TO ME THAT HE EXECUTES THE SAME FREELY AND VOLUNTARILY.

IN TESTIMONY WHEREOF: I HAVE HEREUNTO SET MY HAND AND AFFIXED MY NOTARIAL SEAL THE DAY AND YEAR FIRST ABOVE WRITTEN.

Nancy A. Campbell
NOTARY PUBLIC FOR IDAHO
MY COMMISSION EXPIRES
AUGUST 10, 1977

LEGEND	
---	SEC. LINE
----	HALF SEC. LINE
-----	QUARTER SEC. LINE
-----	10 ACRE LINE
-----	PRIVATE PROP. LINE
MVD	MELVIN V. DAVENPORT
GCS	GRANT COUNTY SURVEYOR
●	MON. SET BY MVD.
○	FOUND ORIGINAL CORNER
○	MON. SET BY GCS
○	FOUND 5/8" PB SET BY GCS
○	1/2" PIPE SET BY MVD.

RECEIVED AND
FILED
JUN 11 3 0 1976
JOHN L. LIVERA, County Clerk
By _____ Deputy

NANCY A. CAMPBELL
NOTARY
PUBLIC
STATE OF IDAHO

SURVEY OF SEC. 1, T14S, R32E, W.M. GRANT COUNTY, OREGON	
FOR WES WILSON	
SCALE: 1" = 300'	DATE: 6-11-76
DRAWN BY: NAC	
DAVENPORT ENGINEERS	
P.O. BOX 131 CALDWELL, IDAHO 83605	