


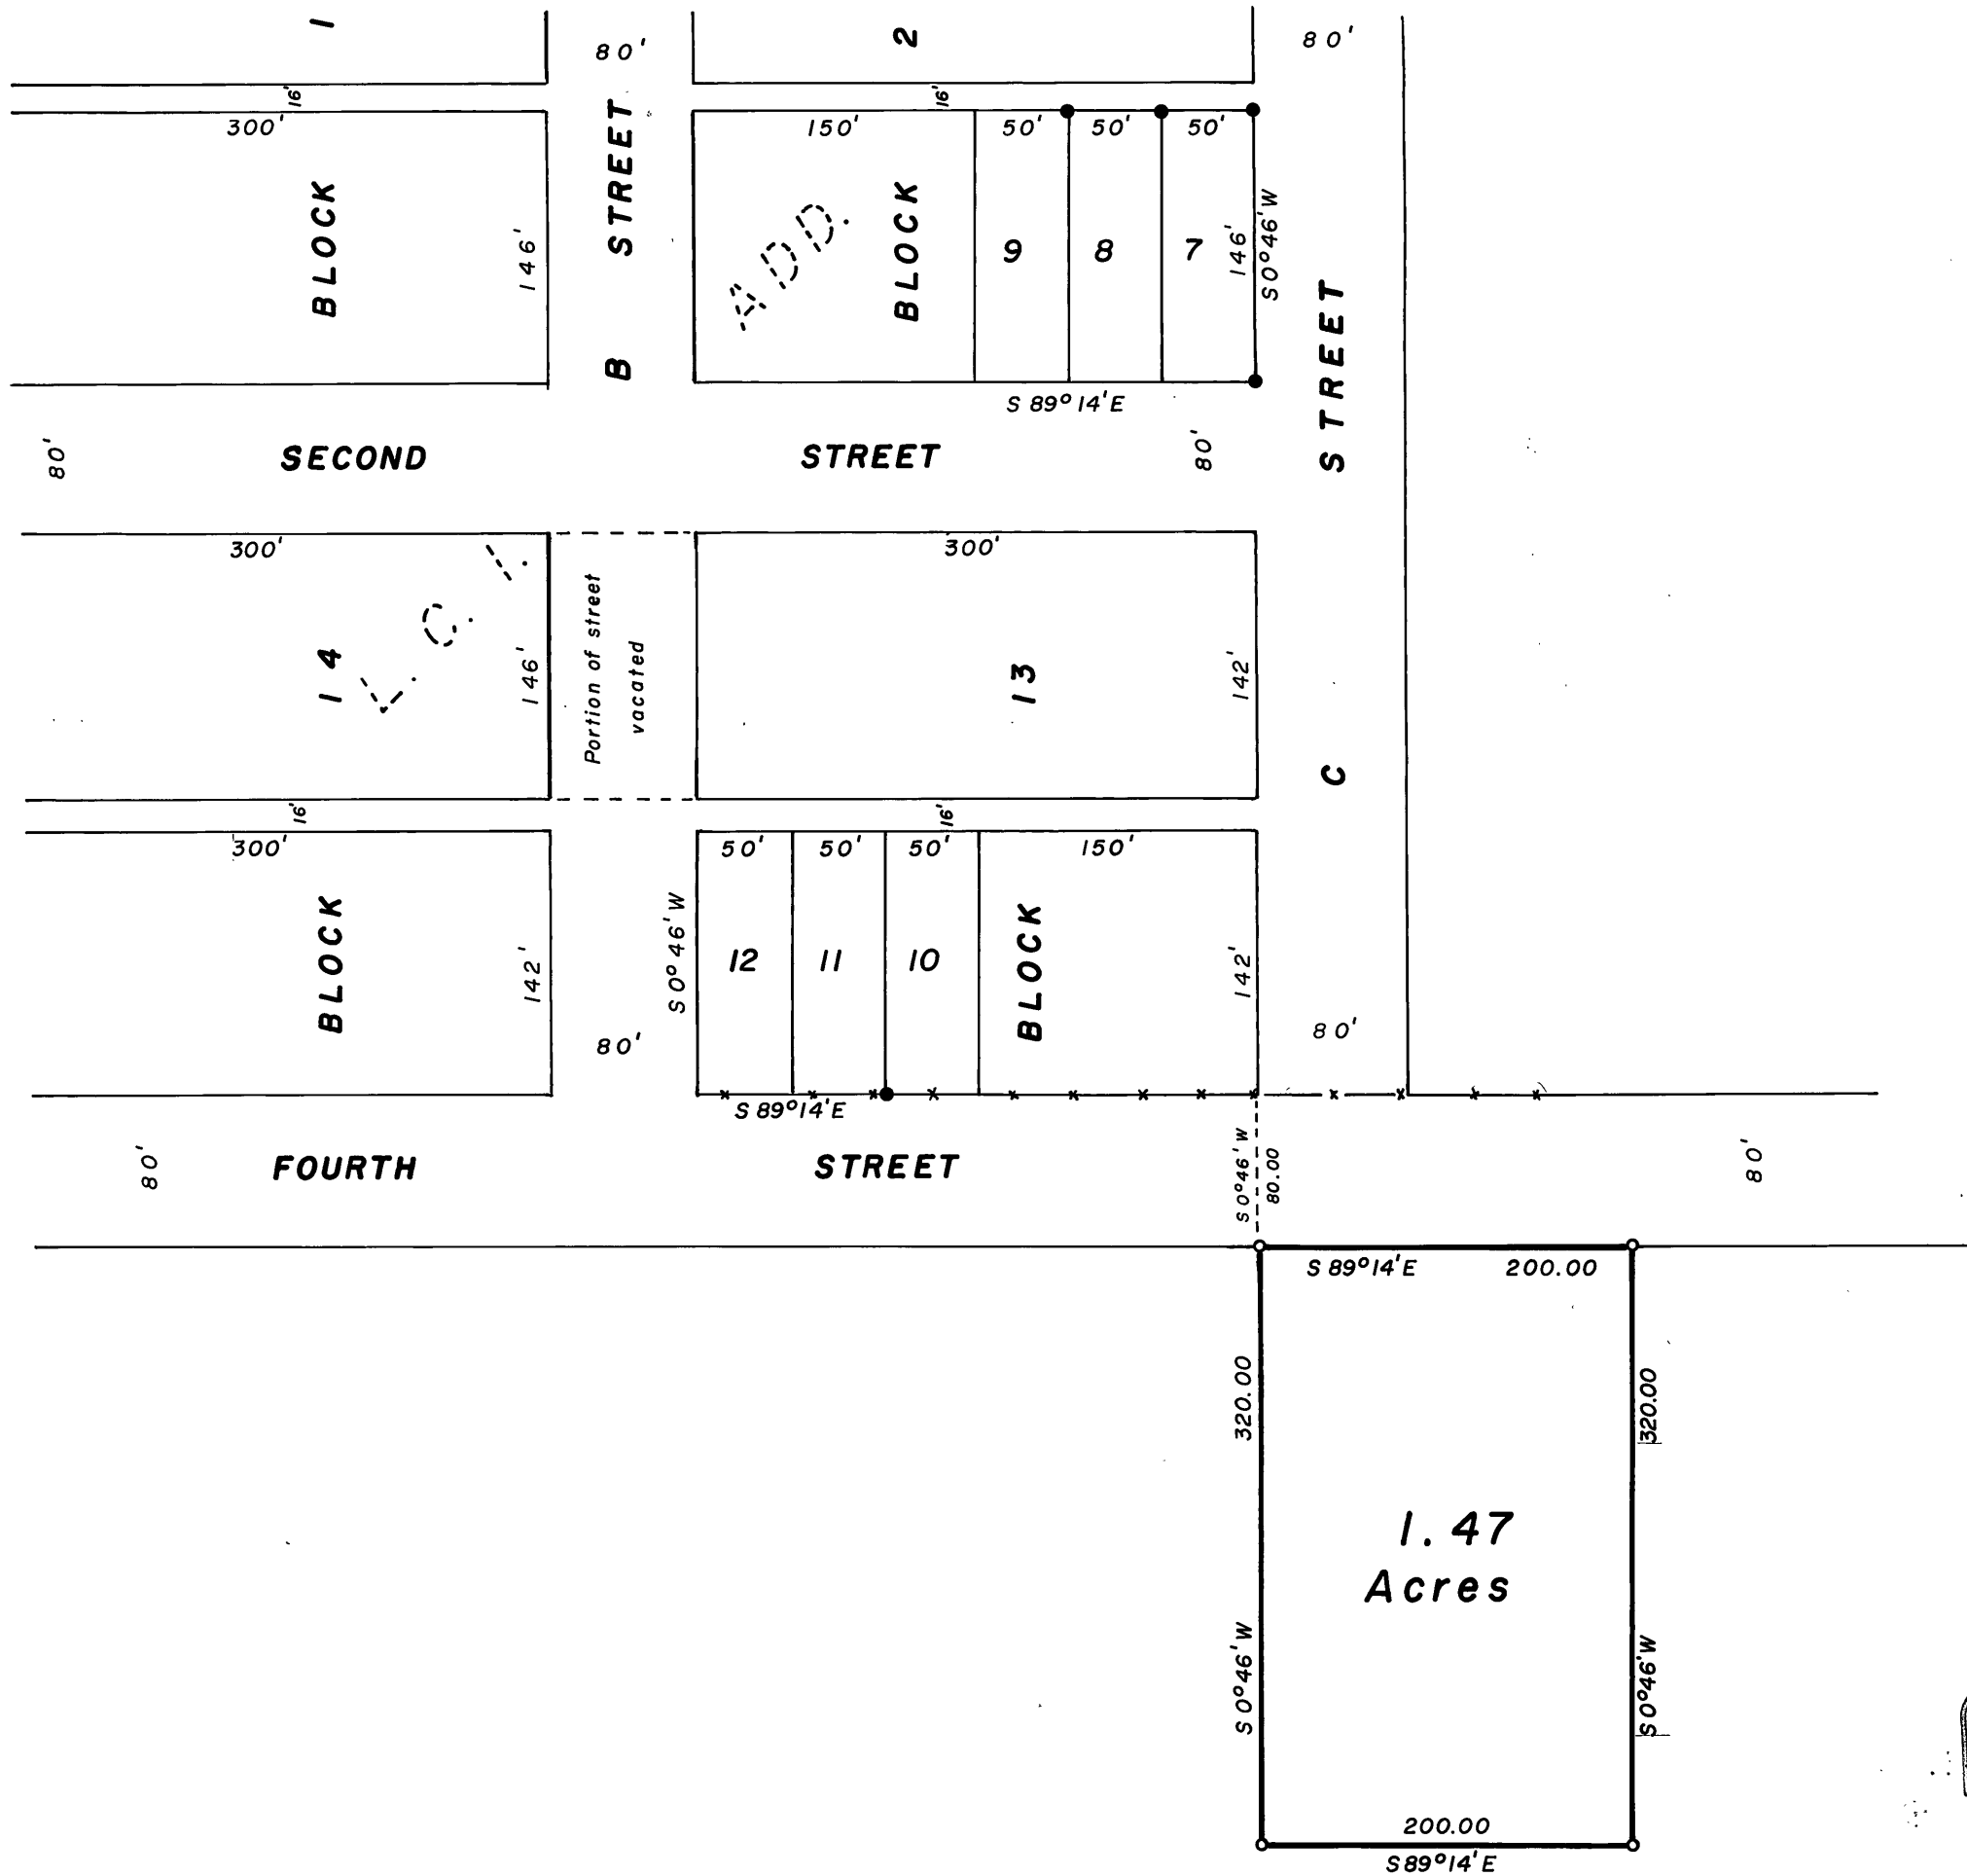

BASIS OF BEARINGS

SURVEY NO.110

LEGEND

• FD. 1/2" IRON PIPE AS SET IN SURVEY NO.110

◦ SET 5/8"X 30" IRON PIN

—x— FENCE

RECEIVED AND
FILED

JUL 30 1976
JOHN LIVEIRA, County Clerk

By _____ Deputy

REGISTERED
PROFESSIONAL
LAND SURVEYOR

Robert D. Baggett
OREGON
JULY 12, 1973
ROBERT D. BAGGETT
598

BAGETT, GRIFFITH & ASSOCIATES

John Day, Oregon

Map of Survey

A TRACT OF LAND IN THE
NW1/4 SW1/4, SEC. 10, T.10S., R.30E., W.M.

LONG CREEK

GRANT COUNTY, OREGON

SURVEYED FOR	CLIFFORD SMITH	
SURVEYED BY	R.D.B. & W.G.	7-73
Scale: 1" = 100'	Drawn by: W.G.	7-73