


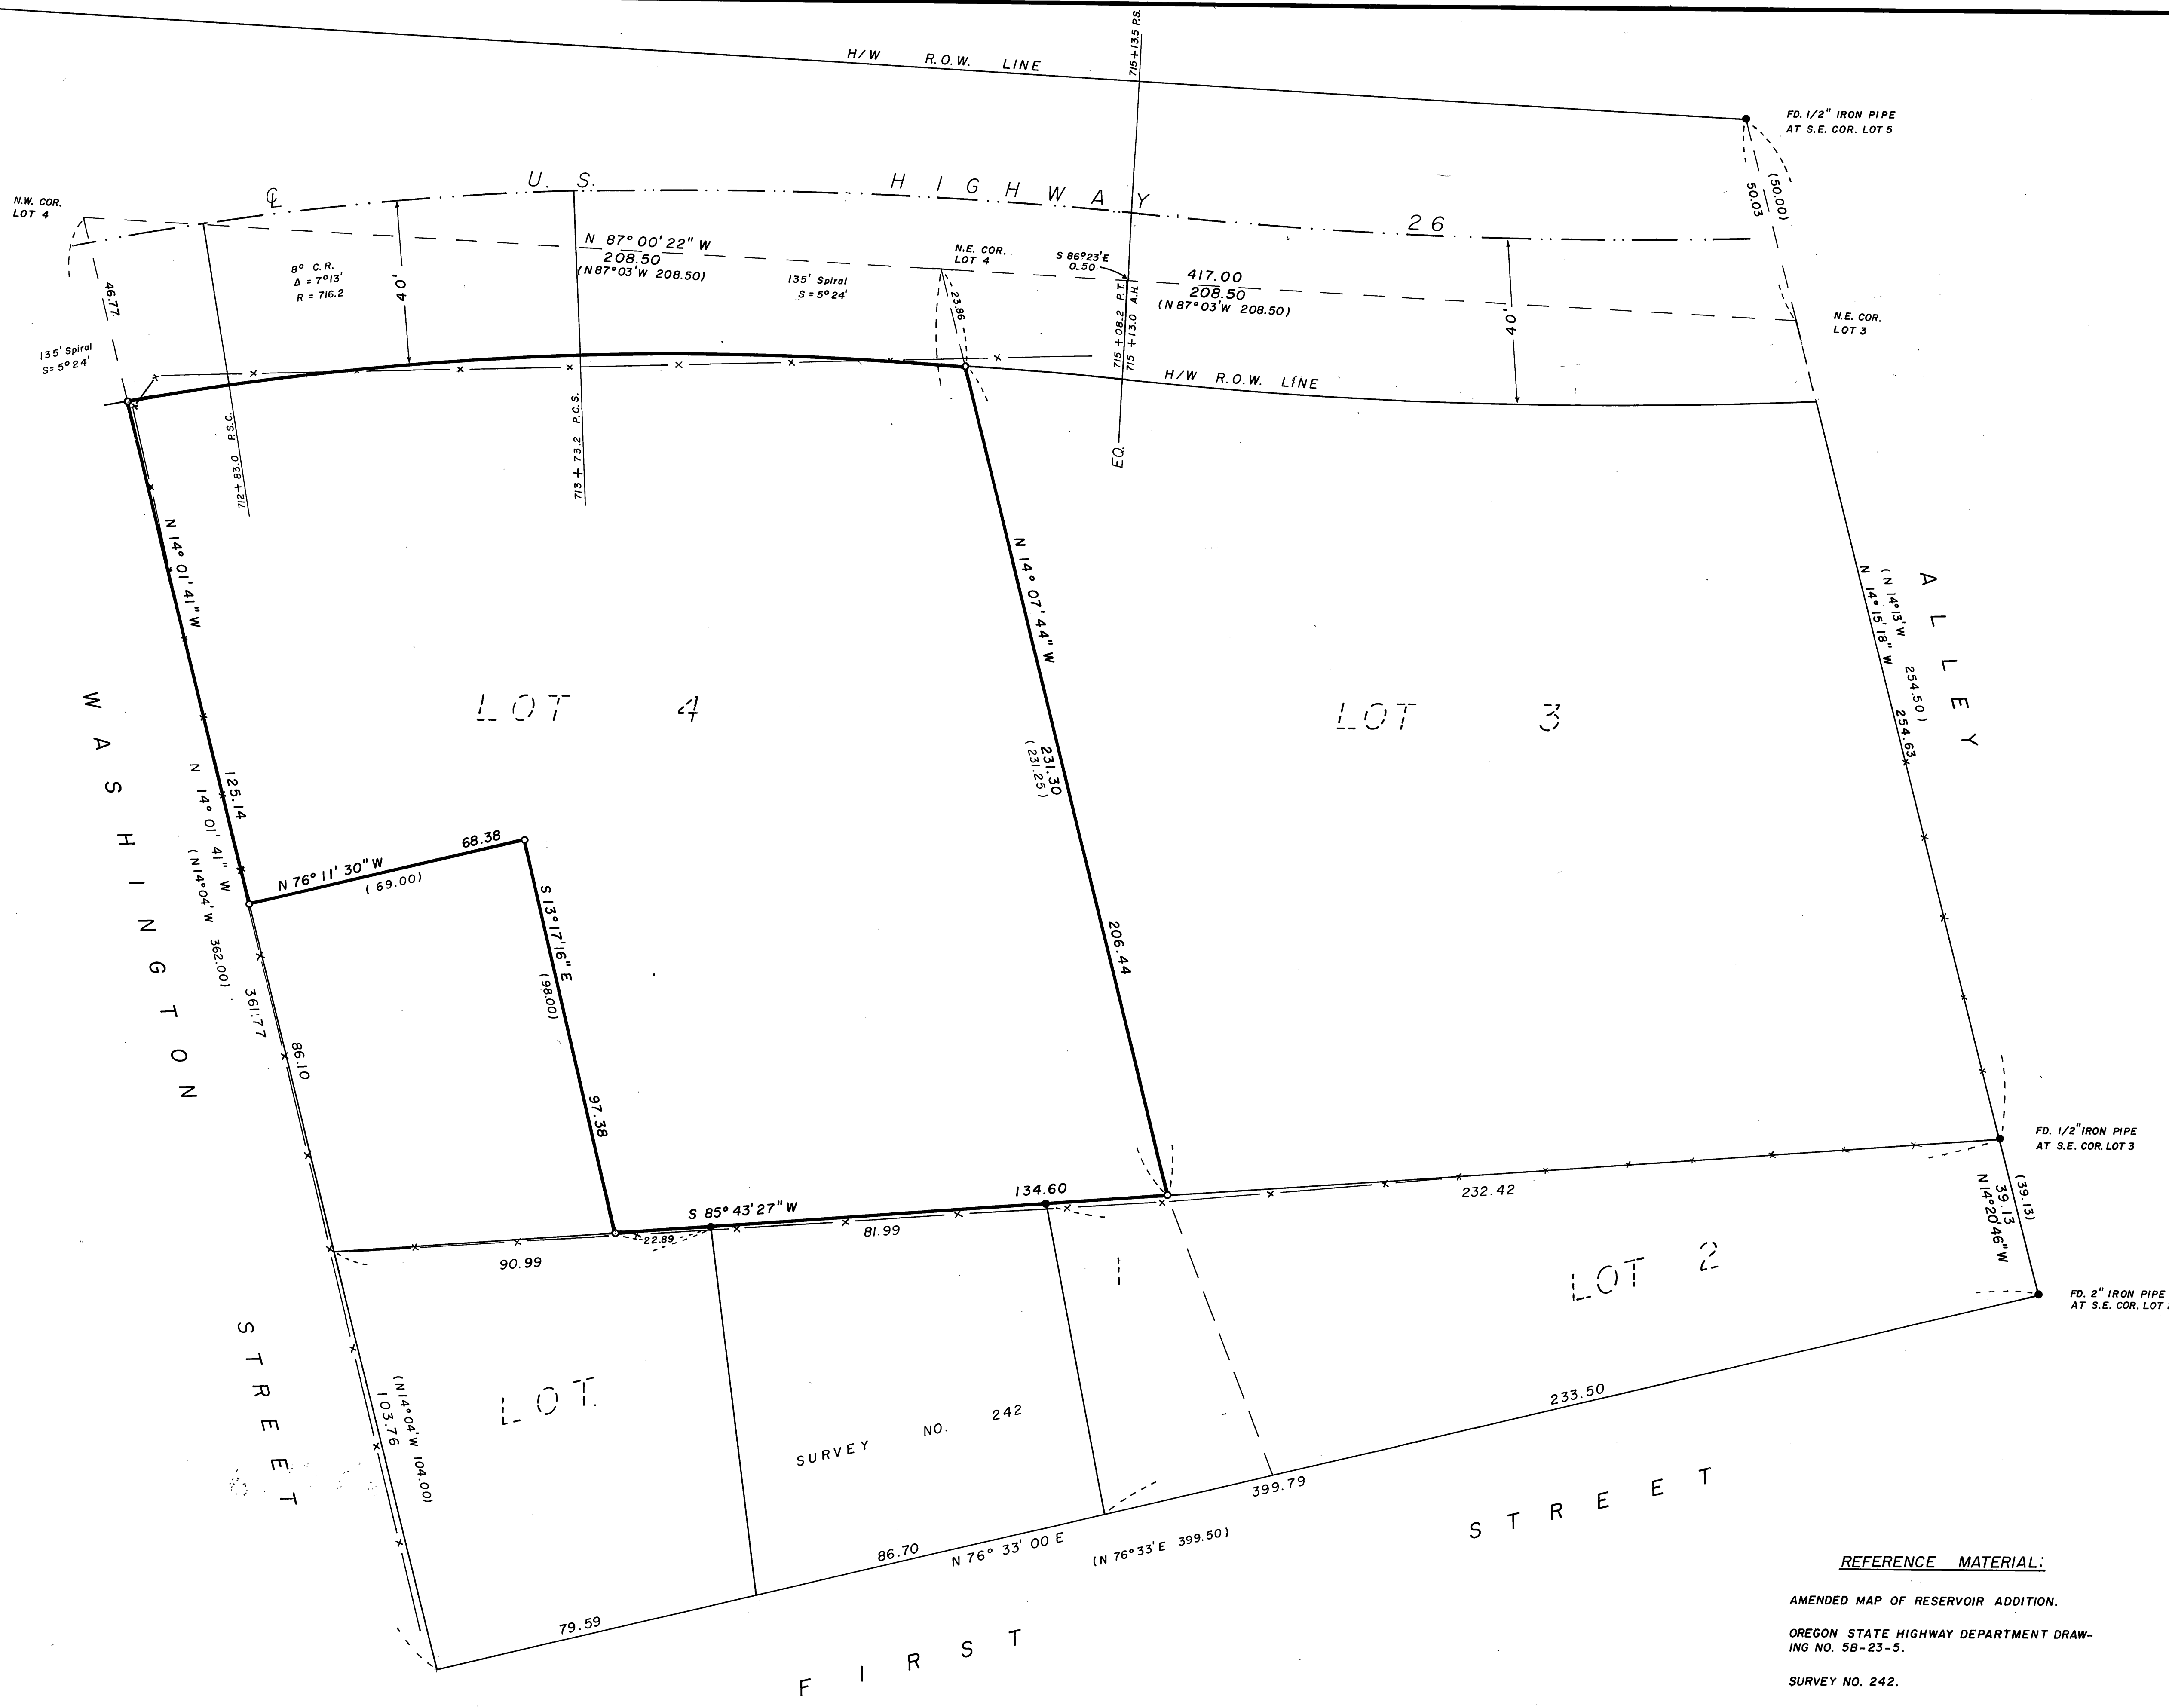

BASIS OF BEARINGS
SURVEY NO. 113

LEGEND

- SET 5/8" X 30" IRON PIN
- FD. MONUMENT OF RECORD
- x—x FENCE
- () RECORD BEARING AND DIST.

REGISTERED
PROFESSIONAL
LAND SURVEYOR
Robert D. Baggett
OREGON
JULY 15, 1983
ROBERT D. BAGGETT
598

RECEIVED AND
FILED
JUL 15 1983
JOHN LIVERA, County Clerk
CL

REFERENCE MATERIAL:

AMENDED MAP OF RESERVOIR ADDITION.
OREGON STATE HIGHWAY DEPARTMENT DRAW-
ING NO. 58-23-S.
SURVEY NO. 242.

BAGETT, GRIFFITH & ASSOCIATES			
John Day, Oregon			
Map of Survey			
LOT 4 AMENDED RESERVOIR ADD.			
PRAIRIE CITY			
GRANT COUNTY, OREGON			
SURVEYED FOR	DANIAL HARRIS		
SURVEYED BY	R.D.B. & W.G.	7-73	
Scale: 1"= 20'	Drawn by: W.G.	7-73	