
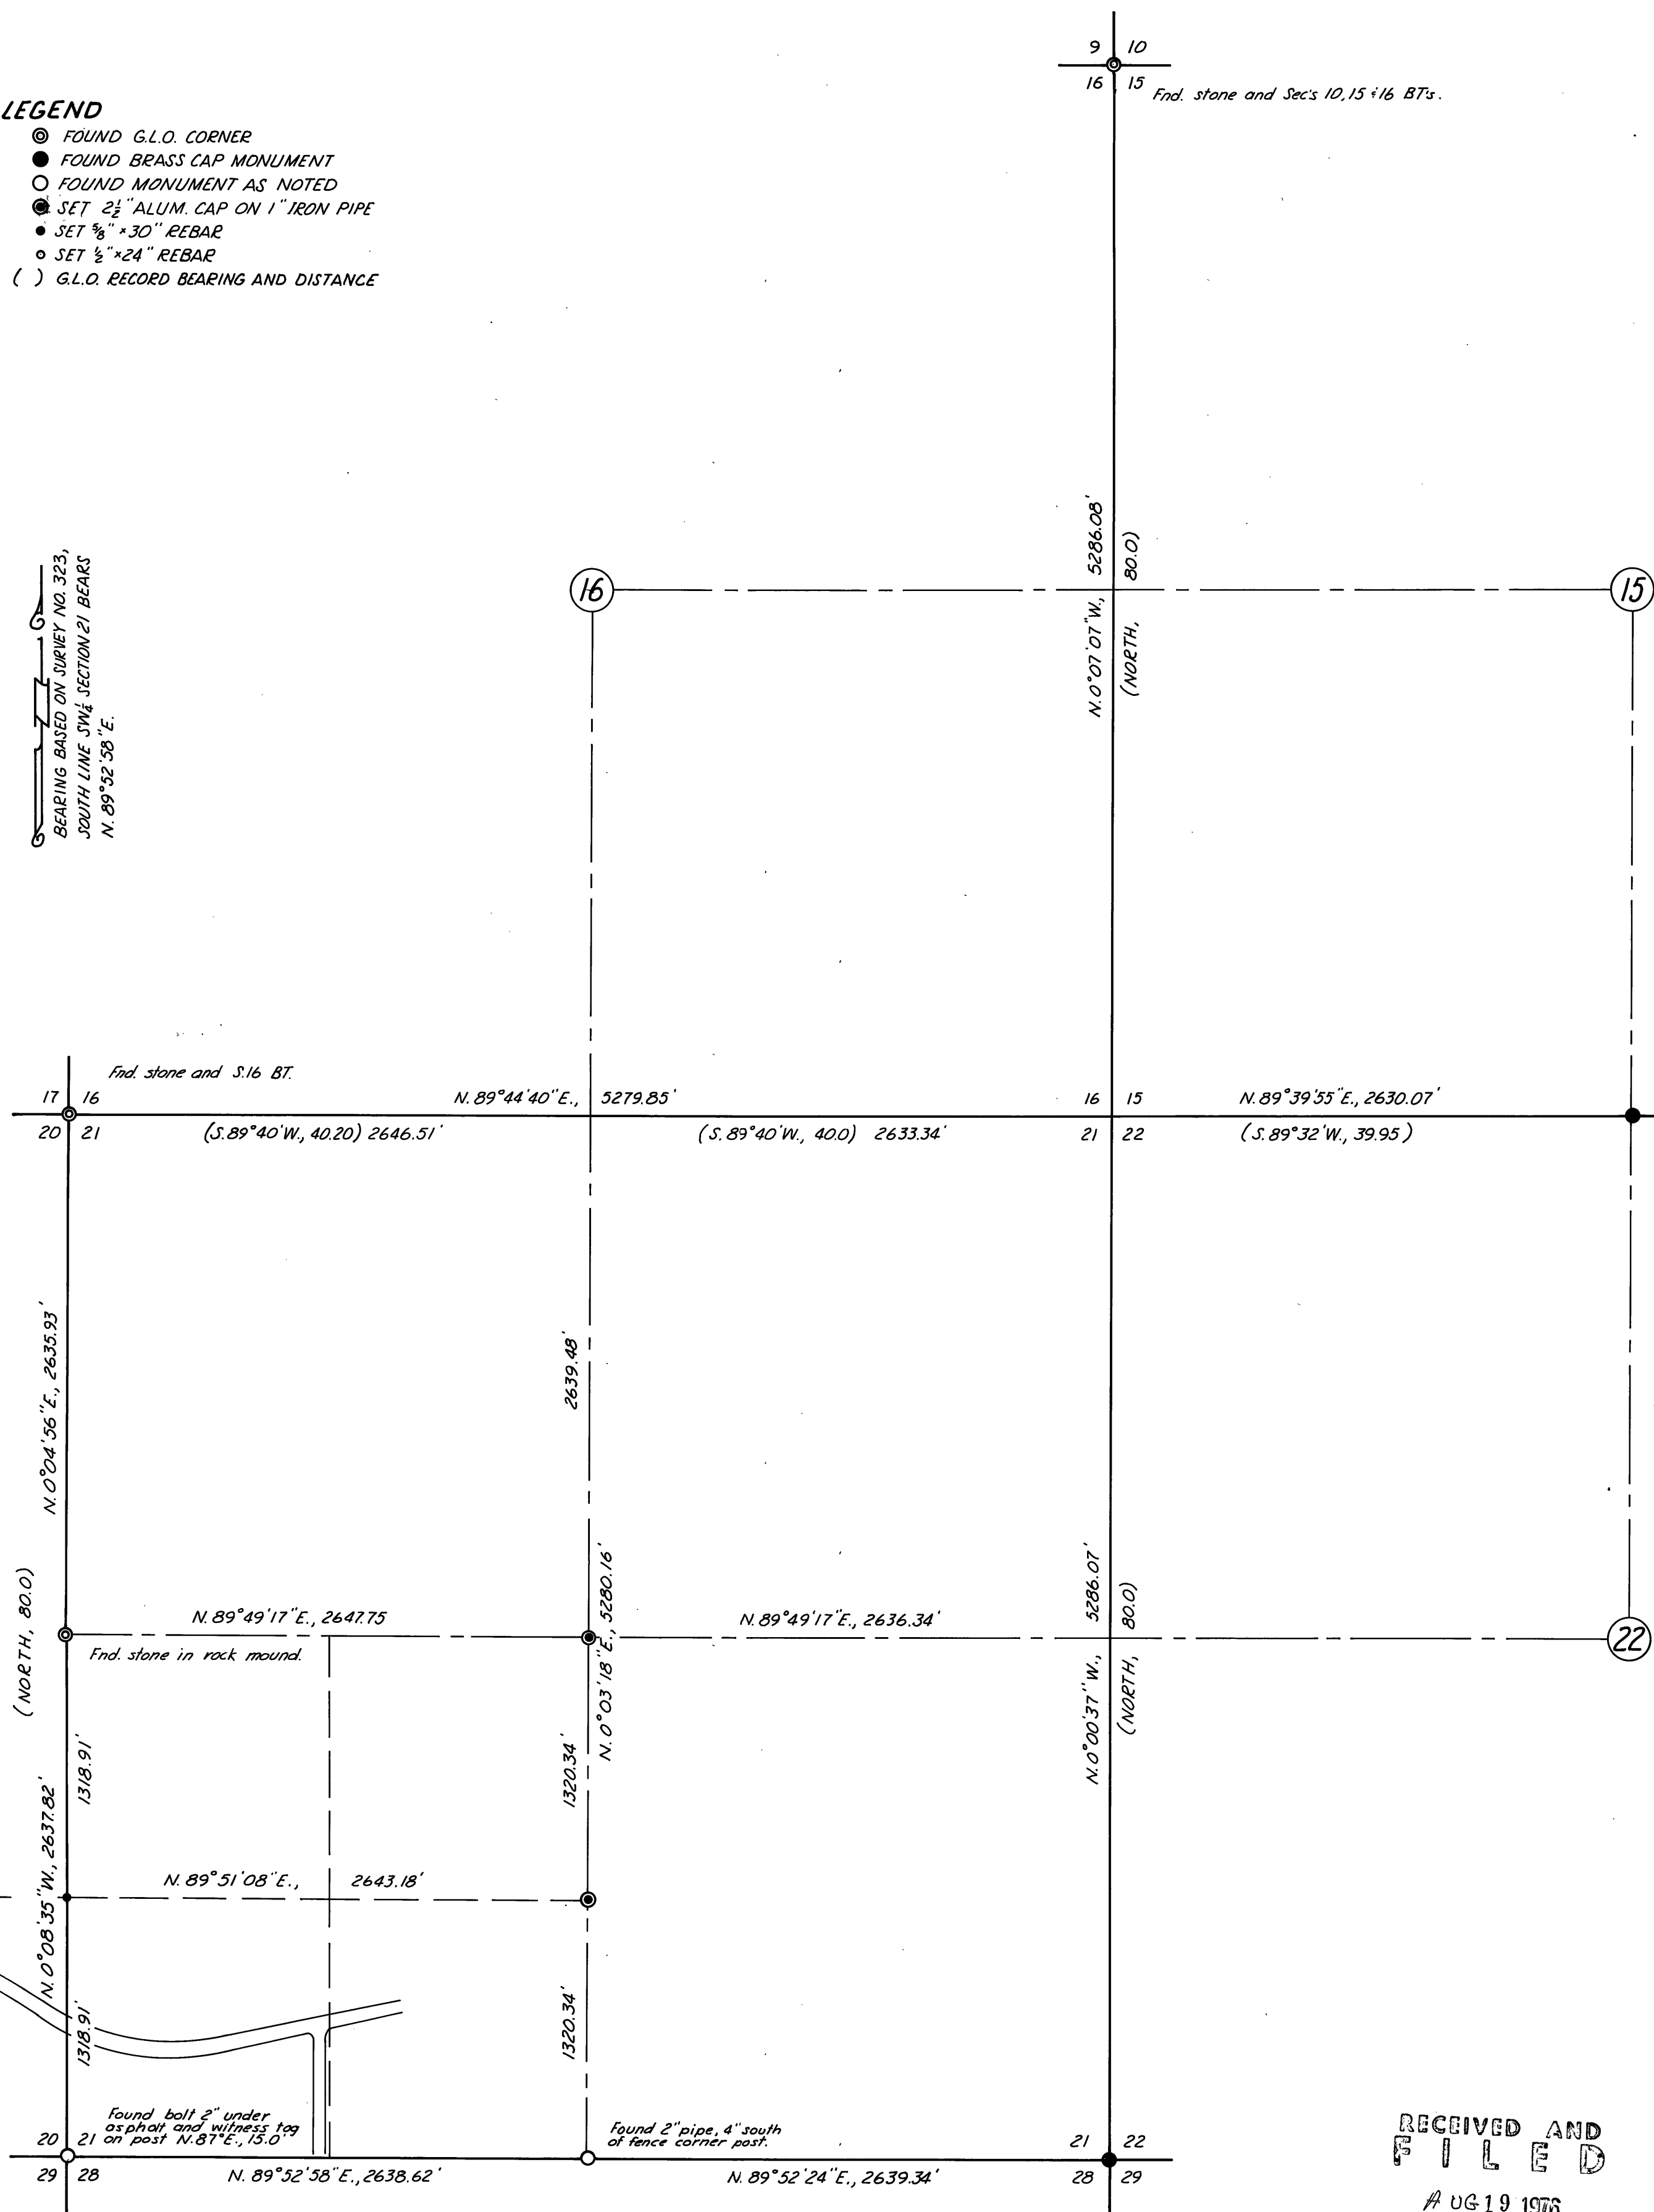


- ⊙ FOUND G.L.O. CORNER
- FOUND BRASS CAP MONUMENT
- FOUND MONUMENT AS NOTED
- ⊗ SET 2½" ALUM. CAP ON 1" IRON PIPE
 - SET ⅜" x 30" REBAR
 - SET ½" x 24" REBAR
- () G.L.O. RECORD BEARING AND DISTANCE

BEARING BASED ON SURVEY NO. 323,
SOUTH LINE SW $\frac{1}{4}$ SECTION 21 BEARS
N. 89° 52' 58" E.

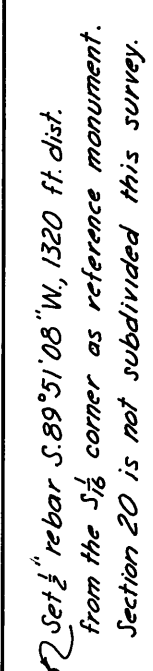

AUG 19 1976

JOHN LIVEIRA, County Clerk
By Patty Lowrey Deputy

MAP OF SURVEY
IN THE SW $\frac{1}{4}$ SECTION 21
T.11S., R.35E., W.M.

Surveyed June 2, 3, 7 & 28, 1976
July 7, 8 & 19, 1976
Scale 1" = 600 ft.
For Henry Ricco

