


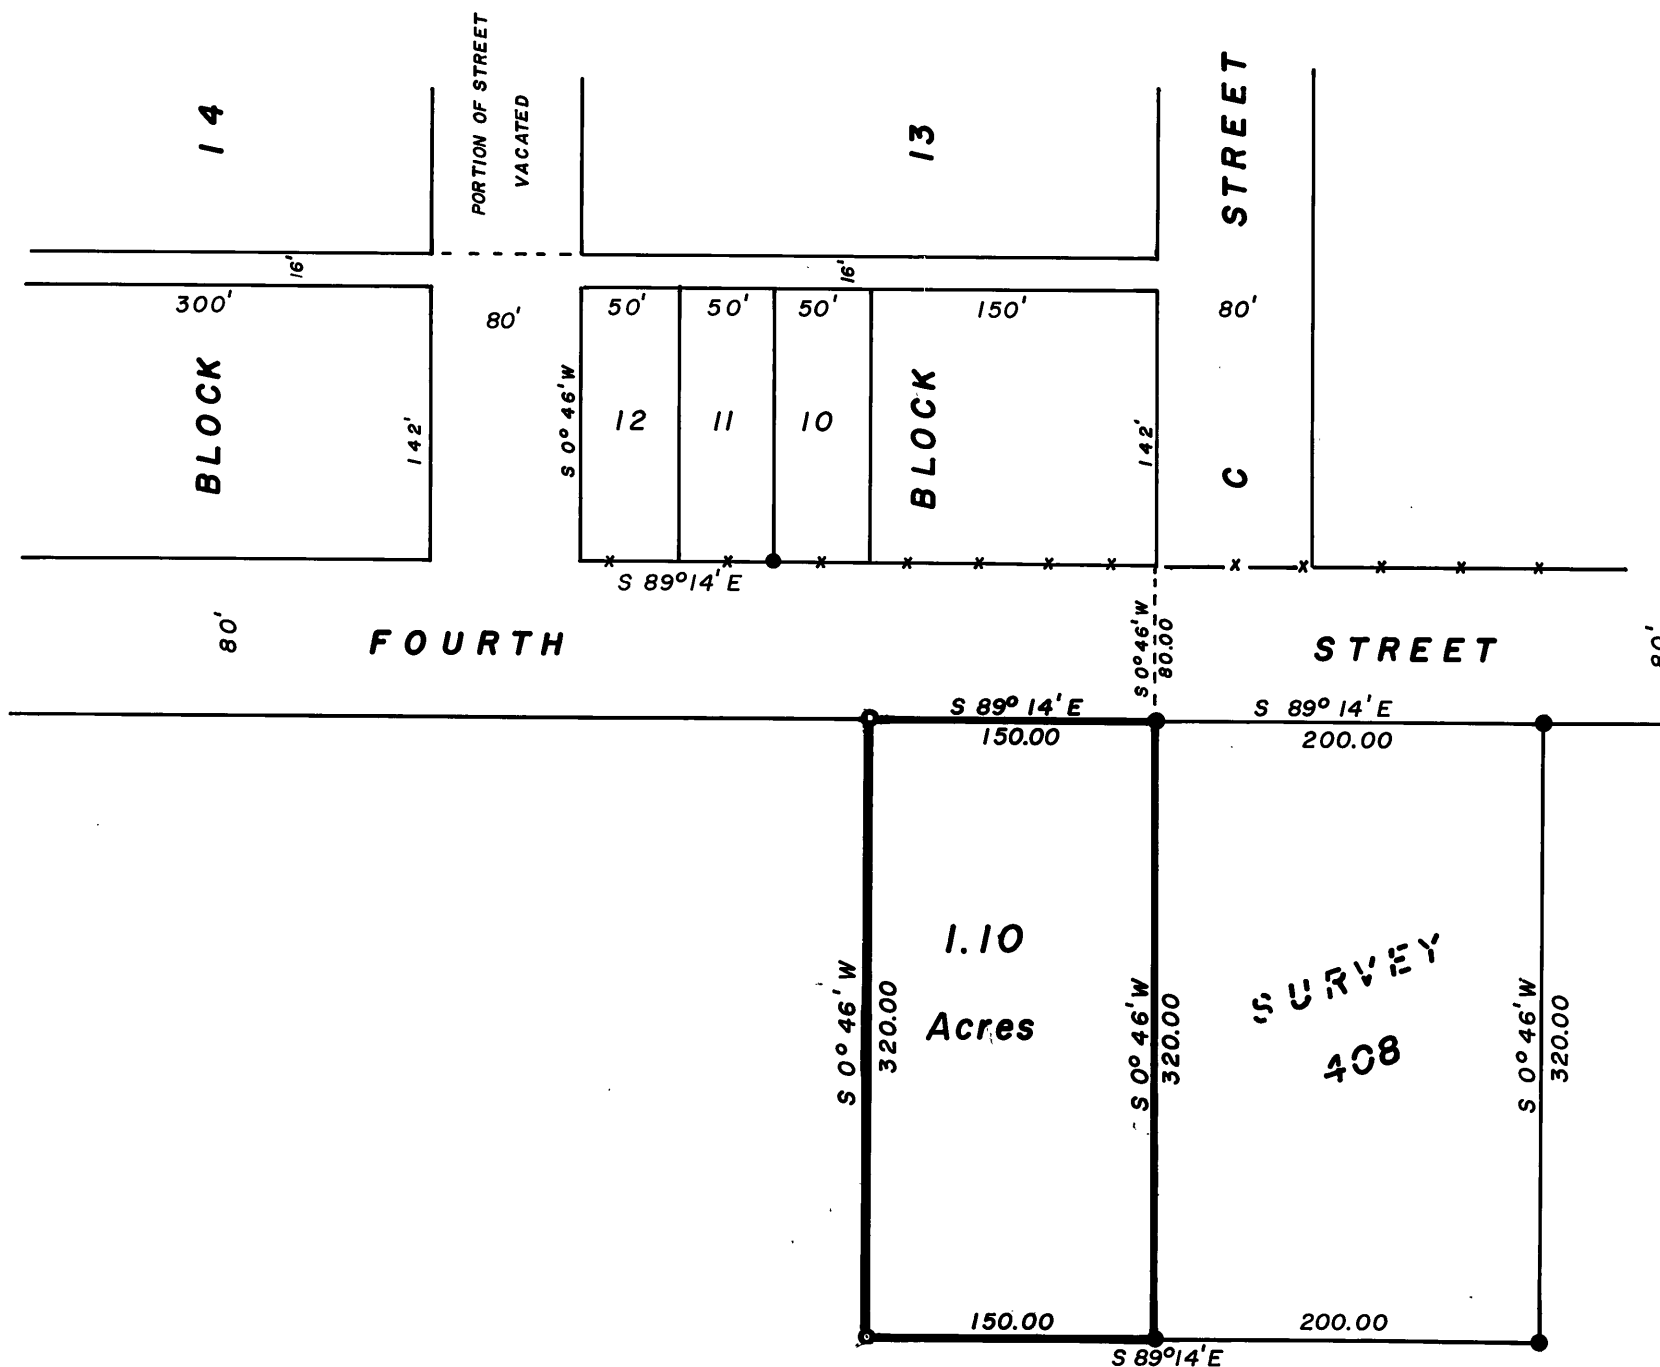

BASIS OF BEARINGS

SURVEY NO. 110

LEGEND

- FD. MONUMENT OF RECORD
- SET 5/8"X30" IRON PIN

x—x FENCE

RECEIVED AND
FILED

SEP 20 1976

JOHN L. VIEIRA, County Clerk

By _____ Deputy

REGISTERED
PROFESSIONAL
LAND SURVEYOR

Robert D. Bagett
OREGON
JULY 12, 1963
ROBERT D. BAGETT
598

BAGETT, GRIFFITH & ASSOCIATES

John Day, Oregon

Map of Survey

A TRACT OF LAND IN THE
NW1/4SW1/4, SEC. 10, T.10S., R.30E., W.M.

LONG CREEK

GRANT COUNTY, OREGON

SURVEYED FOR	GEORGE HIXSON	
SURVEYED BY	R.D.B. & W.G.	9 - 76
Scale: 1"= 100'	Drawn by: W.G.	9 - 76

MAP OF SURVEY NO. 419