


COZART AVENUE

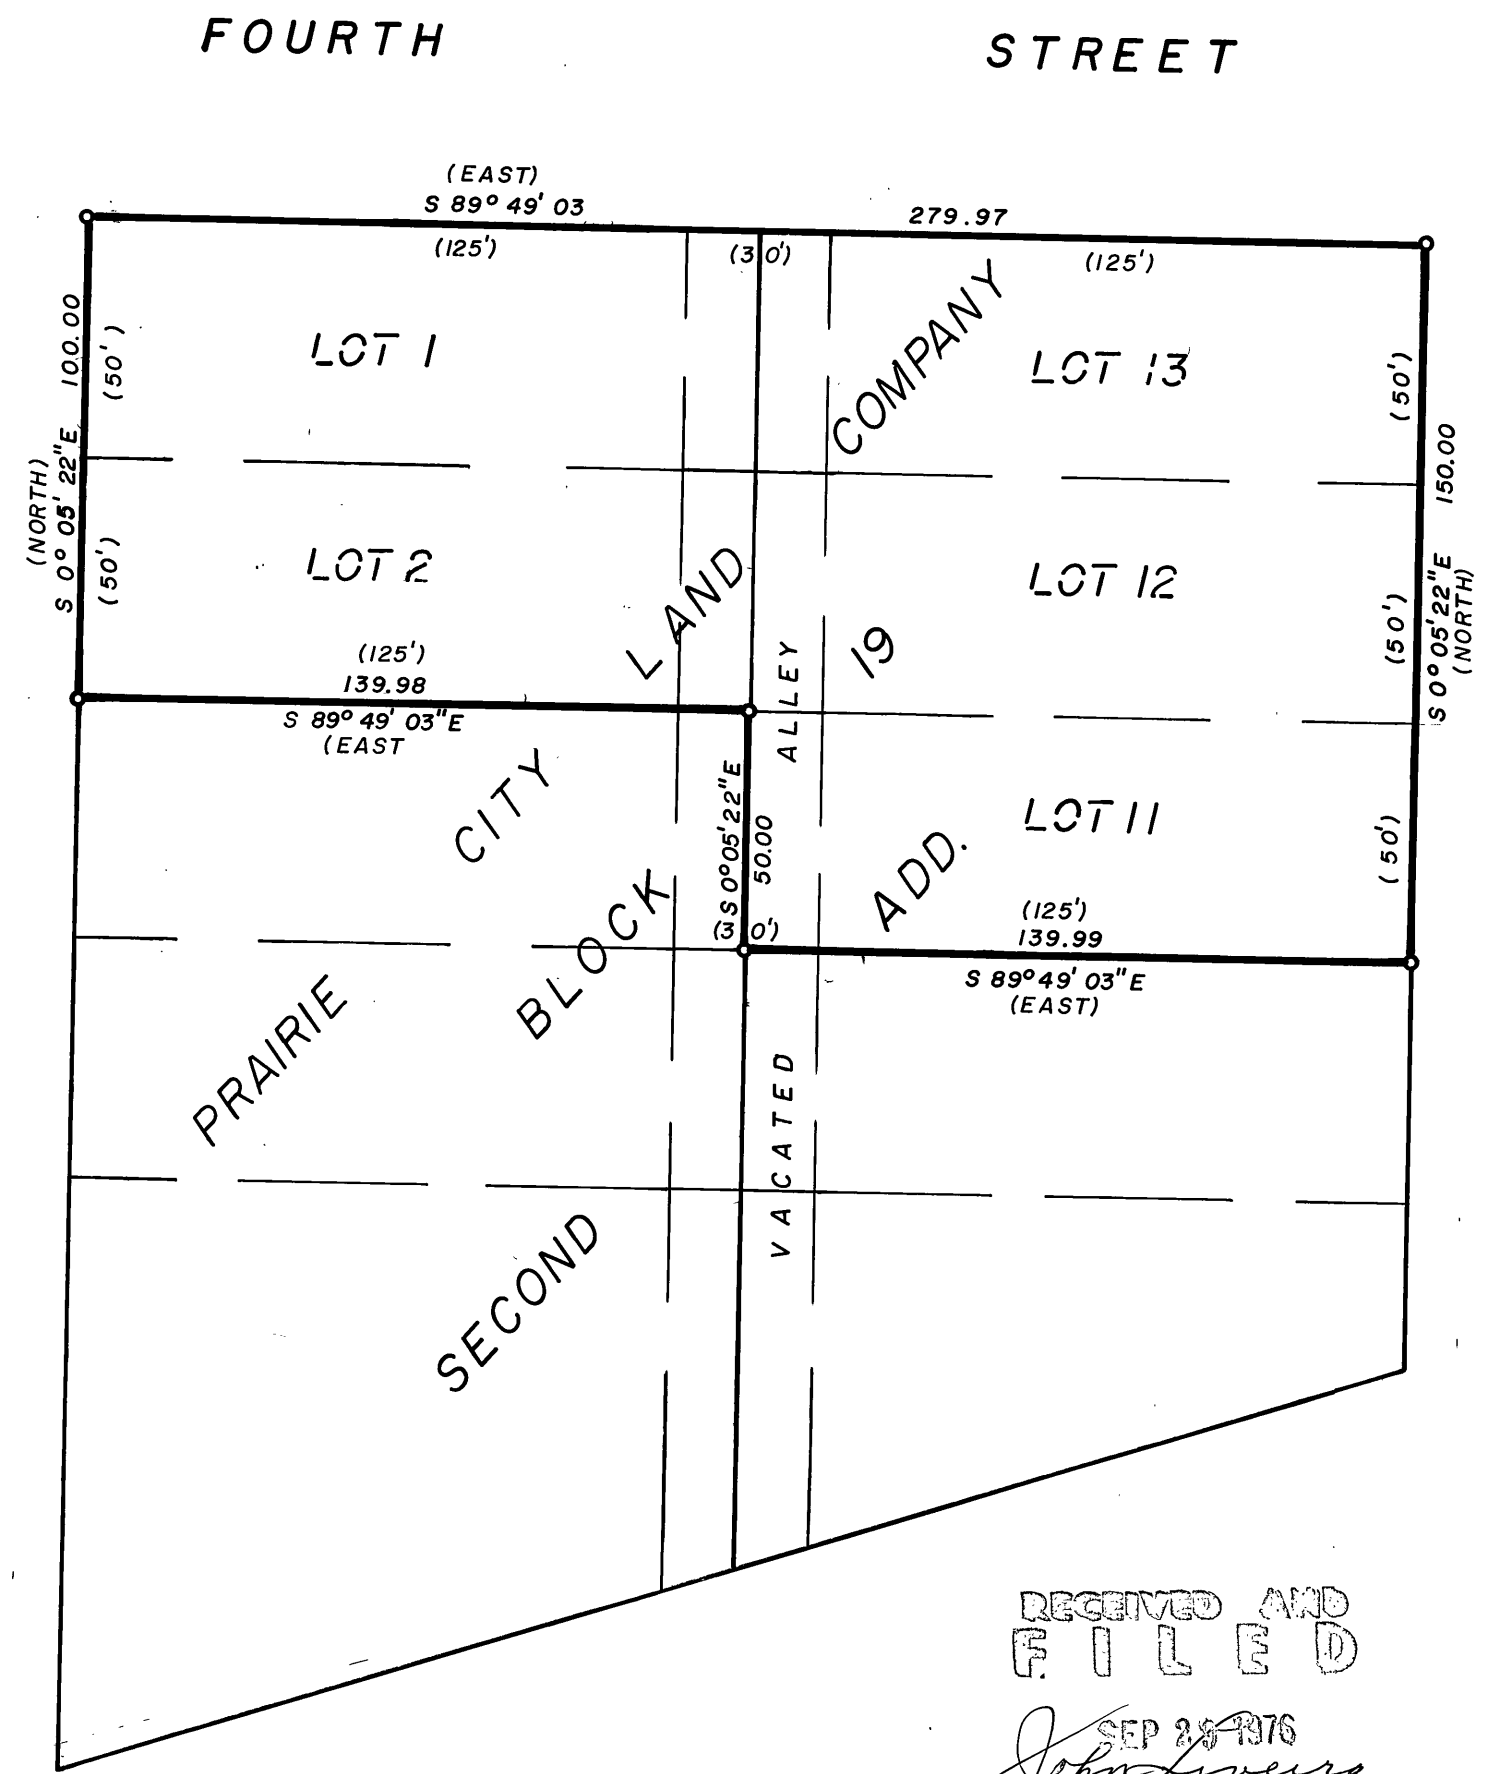

FOURTH STREET

JOHNSON AVENUE


BASIS OF BEARINGS
SURVEY NO. 113

LEGEND

◦ SET 5/8" X 30" IRON PIN

() RECORD BEARING & DISTANCE

RECEIVED AND
FILED
SEP 29 1976
John Livers
JOHN LIVERS, COUNTY CLERK

REGISTERED
PROFESSIONAL
LAND SURVEYOR
Robert D. Baggett
OREGON
JULY 12, 1960
ROBERT D. BAGETT
598

BAGETT, GRIFFITH & ASSOCIATES		
John Day, Oregon		
Map of Survey		
LOTS 1,2,11,12 & 13 BLK. 19 PRAIRIE CITY LAND COMPANY SECOND ADDITION PRAIRIE CITY		
GRANT COUNTY, OREGON		
SURVEYED FOR	U. S. FOREST SERVICE	
SURVEYED BY	R.D.B. & W.G.	9 - 76
Scale: 1" = 40'	Drawn by: W. G.	9 - 76