


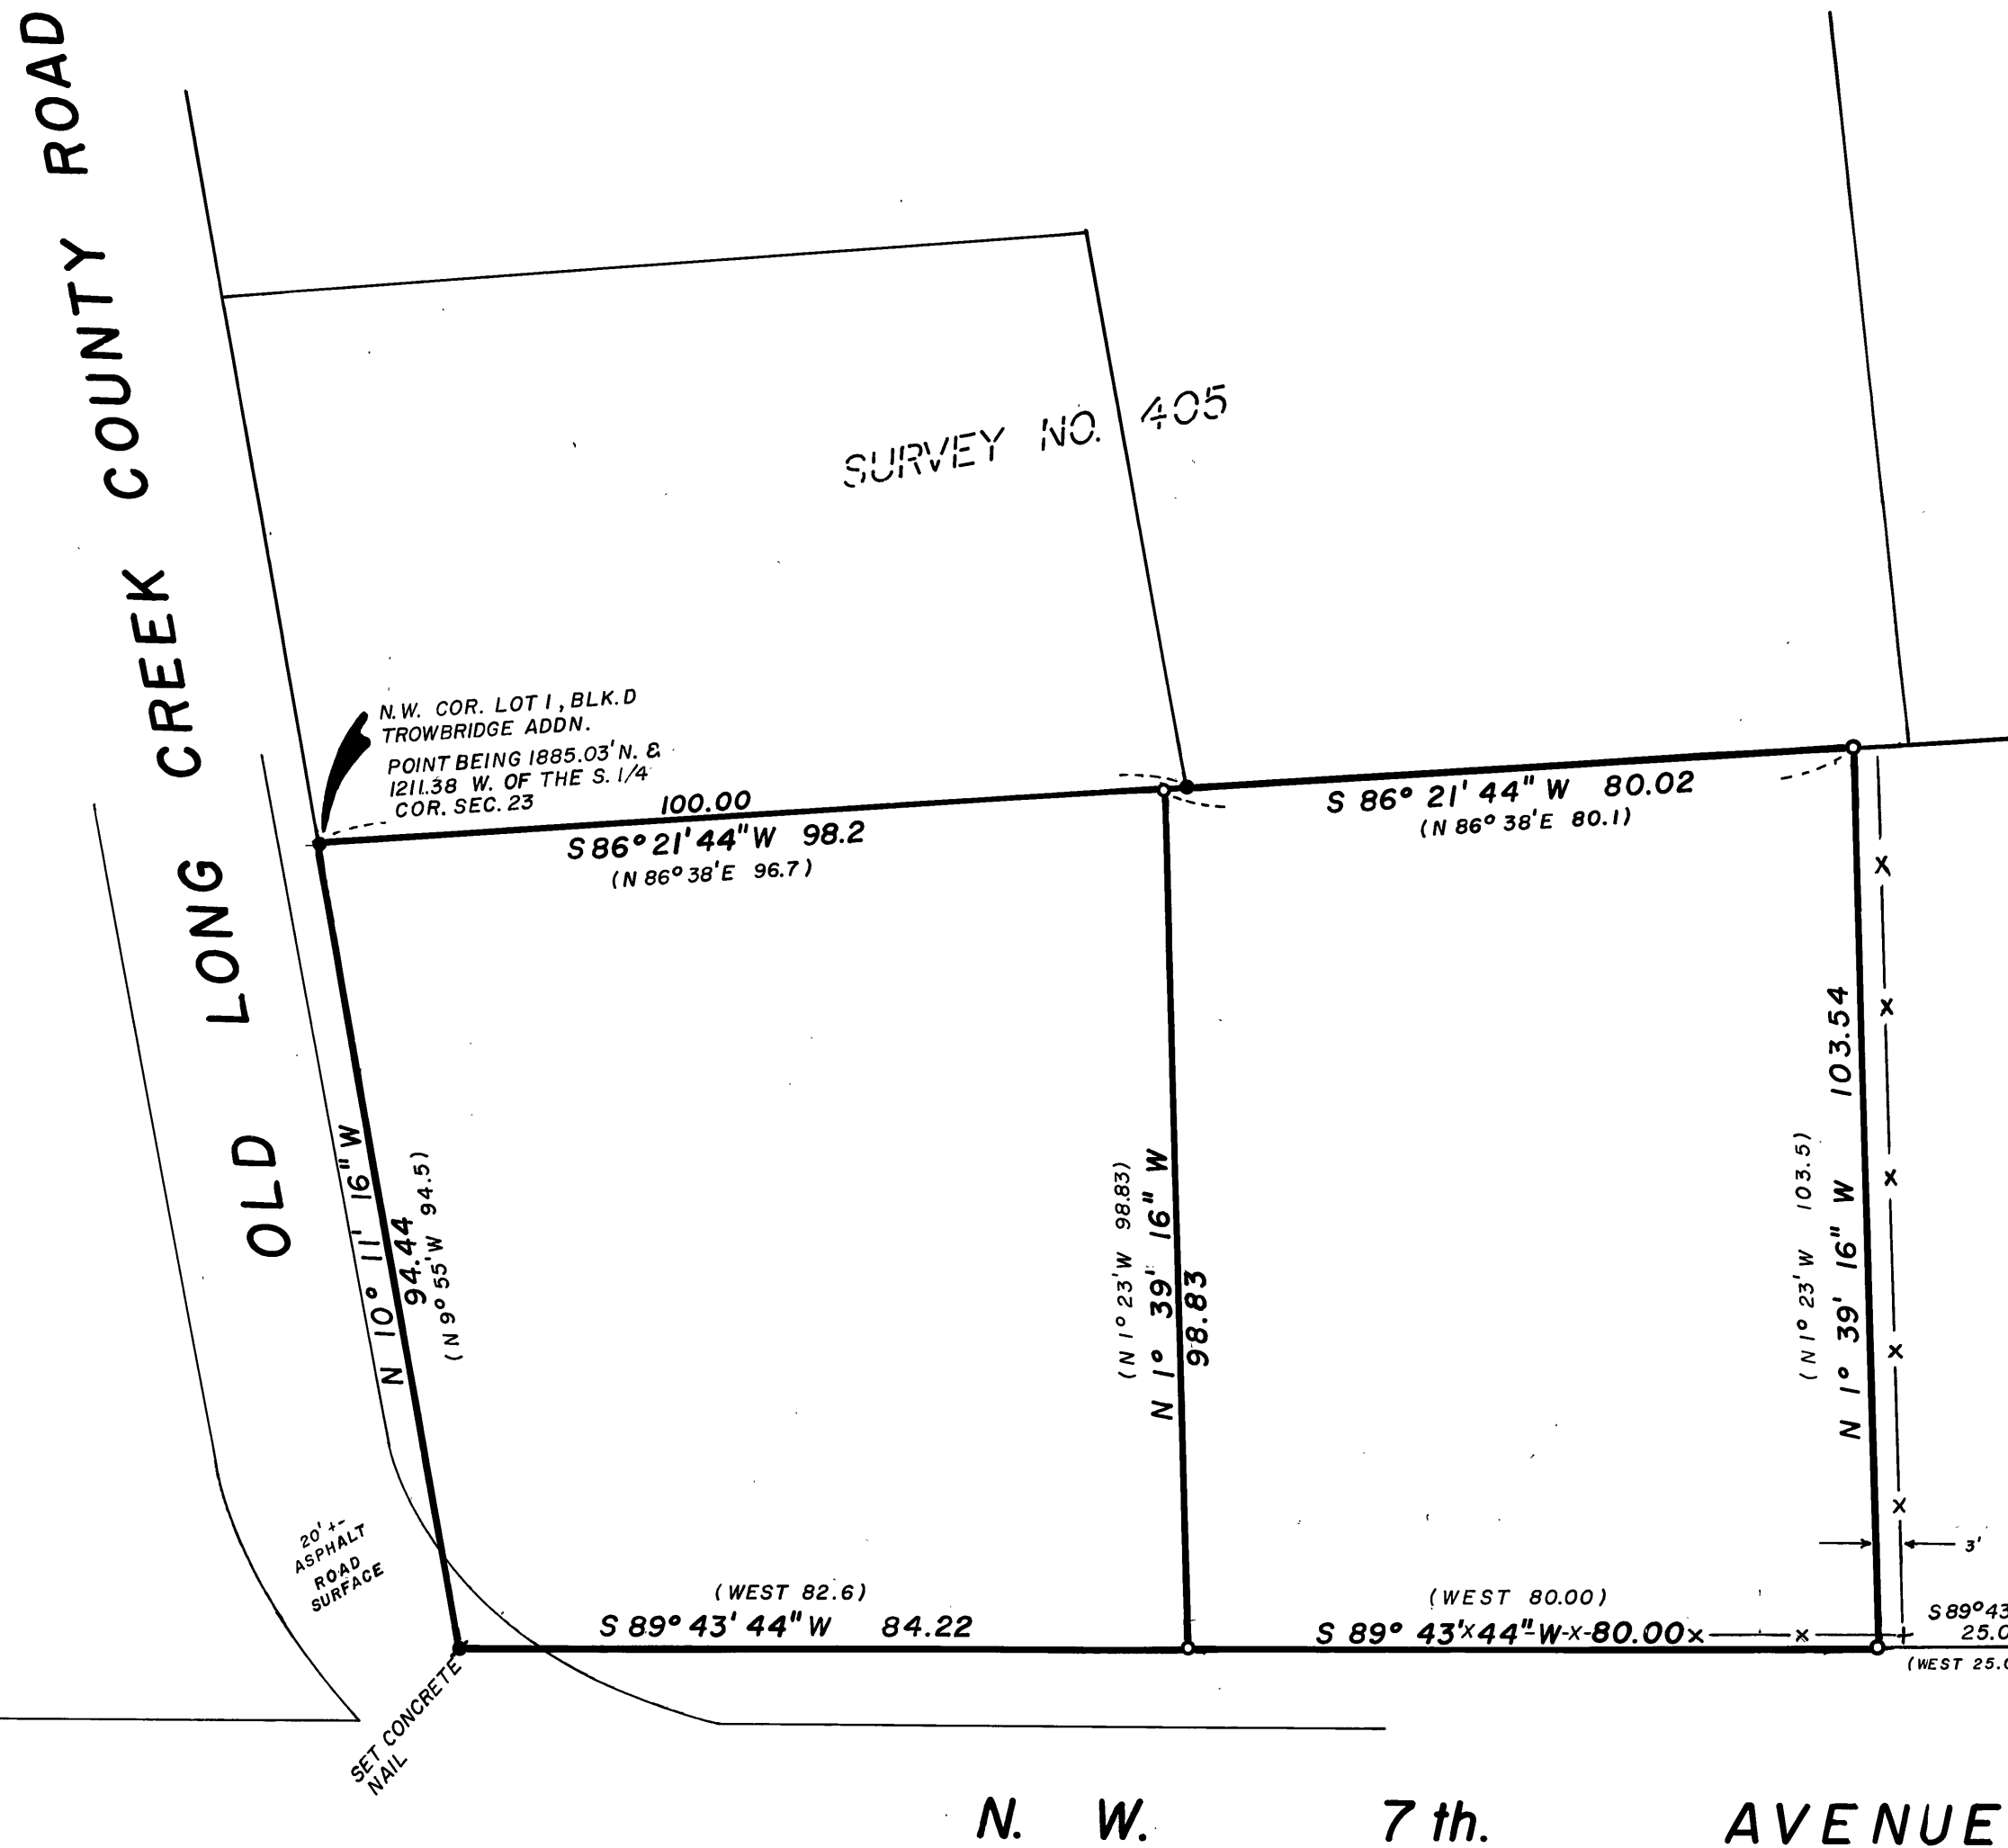

BASIS OF BEARINGS
SOLAR OBSERVATION

LEGEND

- FD. 5/8" IRON PIN
- SET 5/8" X 30" IRON PIN
- () RECORD BEARING & DISTANCE
- x—x FENCE

**RECEIVED AND
FILED**

DEC 20 1976
JOHN LIVEIRA, County Clerk

By _____ Deputy

REGISTERED
PROFESSIONAL
LAND SURVEYOR

Robert D. Bagett

OREGON
JULY 12, 1963
ROBERT D. BAGETT
598

BAGETT, GRIFFITH & ASSOCIATES

John Day, Oregon

Map of Survey

TRACT IN NE1/4SW1/4, SEC. 23, T. 13 S., R. 31 E., W. M.
INCLUDING A PORTION OF LOT 1, BLK. D TROWBRIDGE
SUBDIVISION

JOHN DAY

GRANT COUNTY, OREGON

SURVEYED FOR	GUS URIARTE	
SURVEYED BY	R.D.B. & W.G.	11-76
Scale: 1" = 20'	Drawn by: W.G.	11-76