



BASIS OF BEARINGS
SOLAR OBSERVATION

LEGEND

- SET 5/8" X 30" IRON PIN
UNLESS OTHERWISE NOTED
- x— FENCE

REGISTERED
PROFESSIONAL
LAND SURVEYOR
Robert D. Baggett
OREGON
JULY 12, 1969
ROBERT D. BAGGETT
598


RECEIVED AND
FILED

MAR 1 1977
JOHN L. LIVEIRA, County Clerk
By *Deputy* Deputy

BAGETT, GRIFFITH & ASSOCIATES			
John Day, Oregon			
Map of Survey			
TRACT IN THE SW1/4SE1/4, SECTION 21, T.13S., R.30E., W.4M MT. VERNON GRANT COUNTY, OREGON			
Surveyed For	FOCH BECK		
Surveyed By	R.D.B. & W.G.	12-76	
Scale: 1" = 20'	Drawn By: W.G.	12-76	

MAP OF SURVEY NO. 425

0.694 Ac.

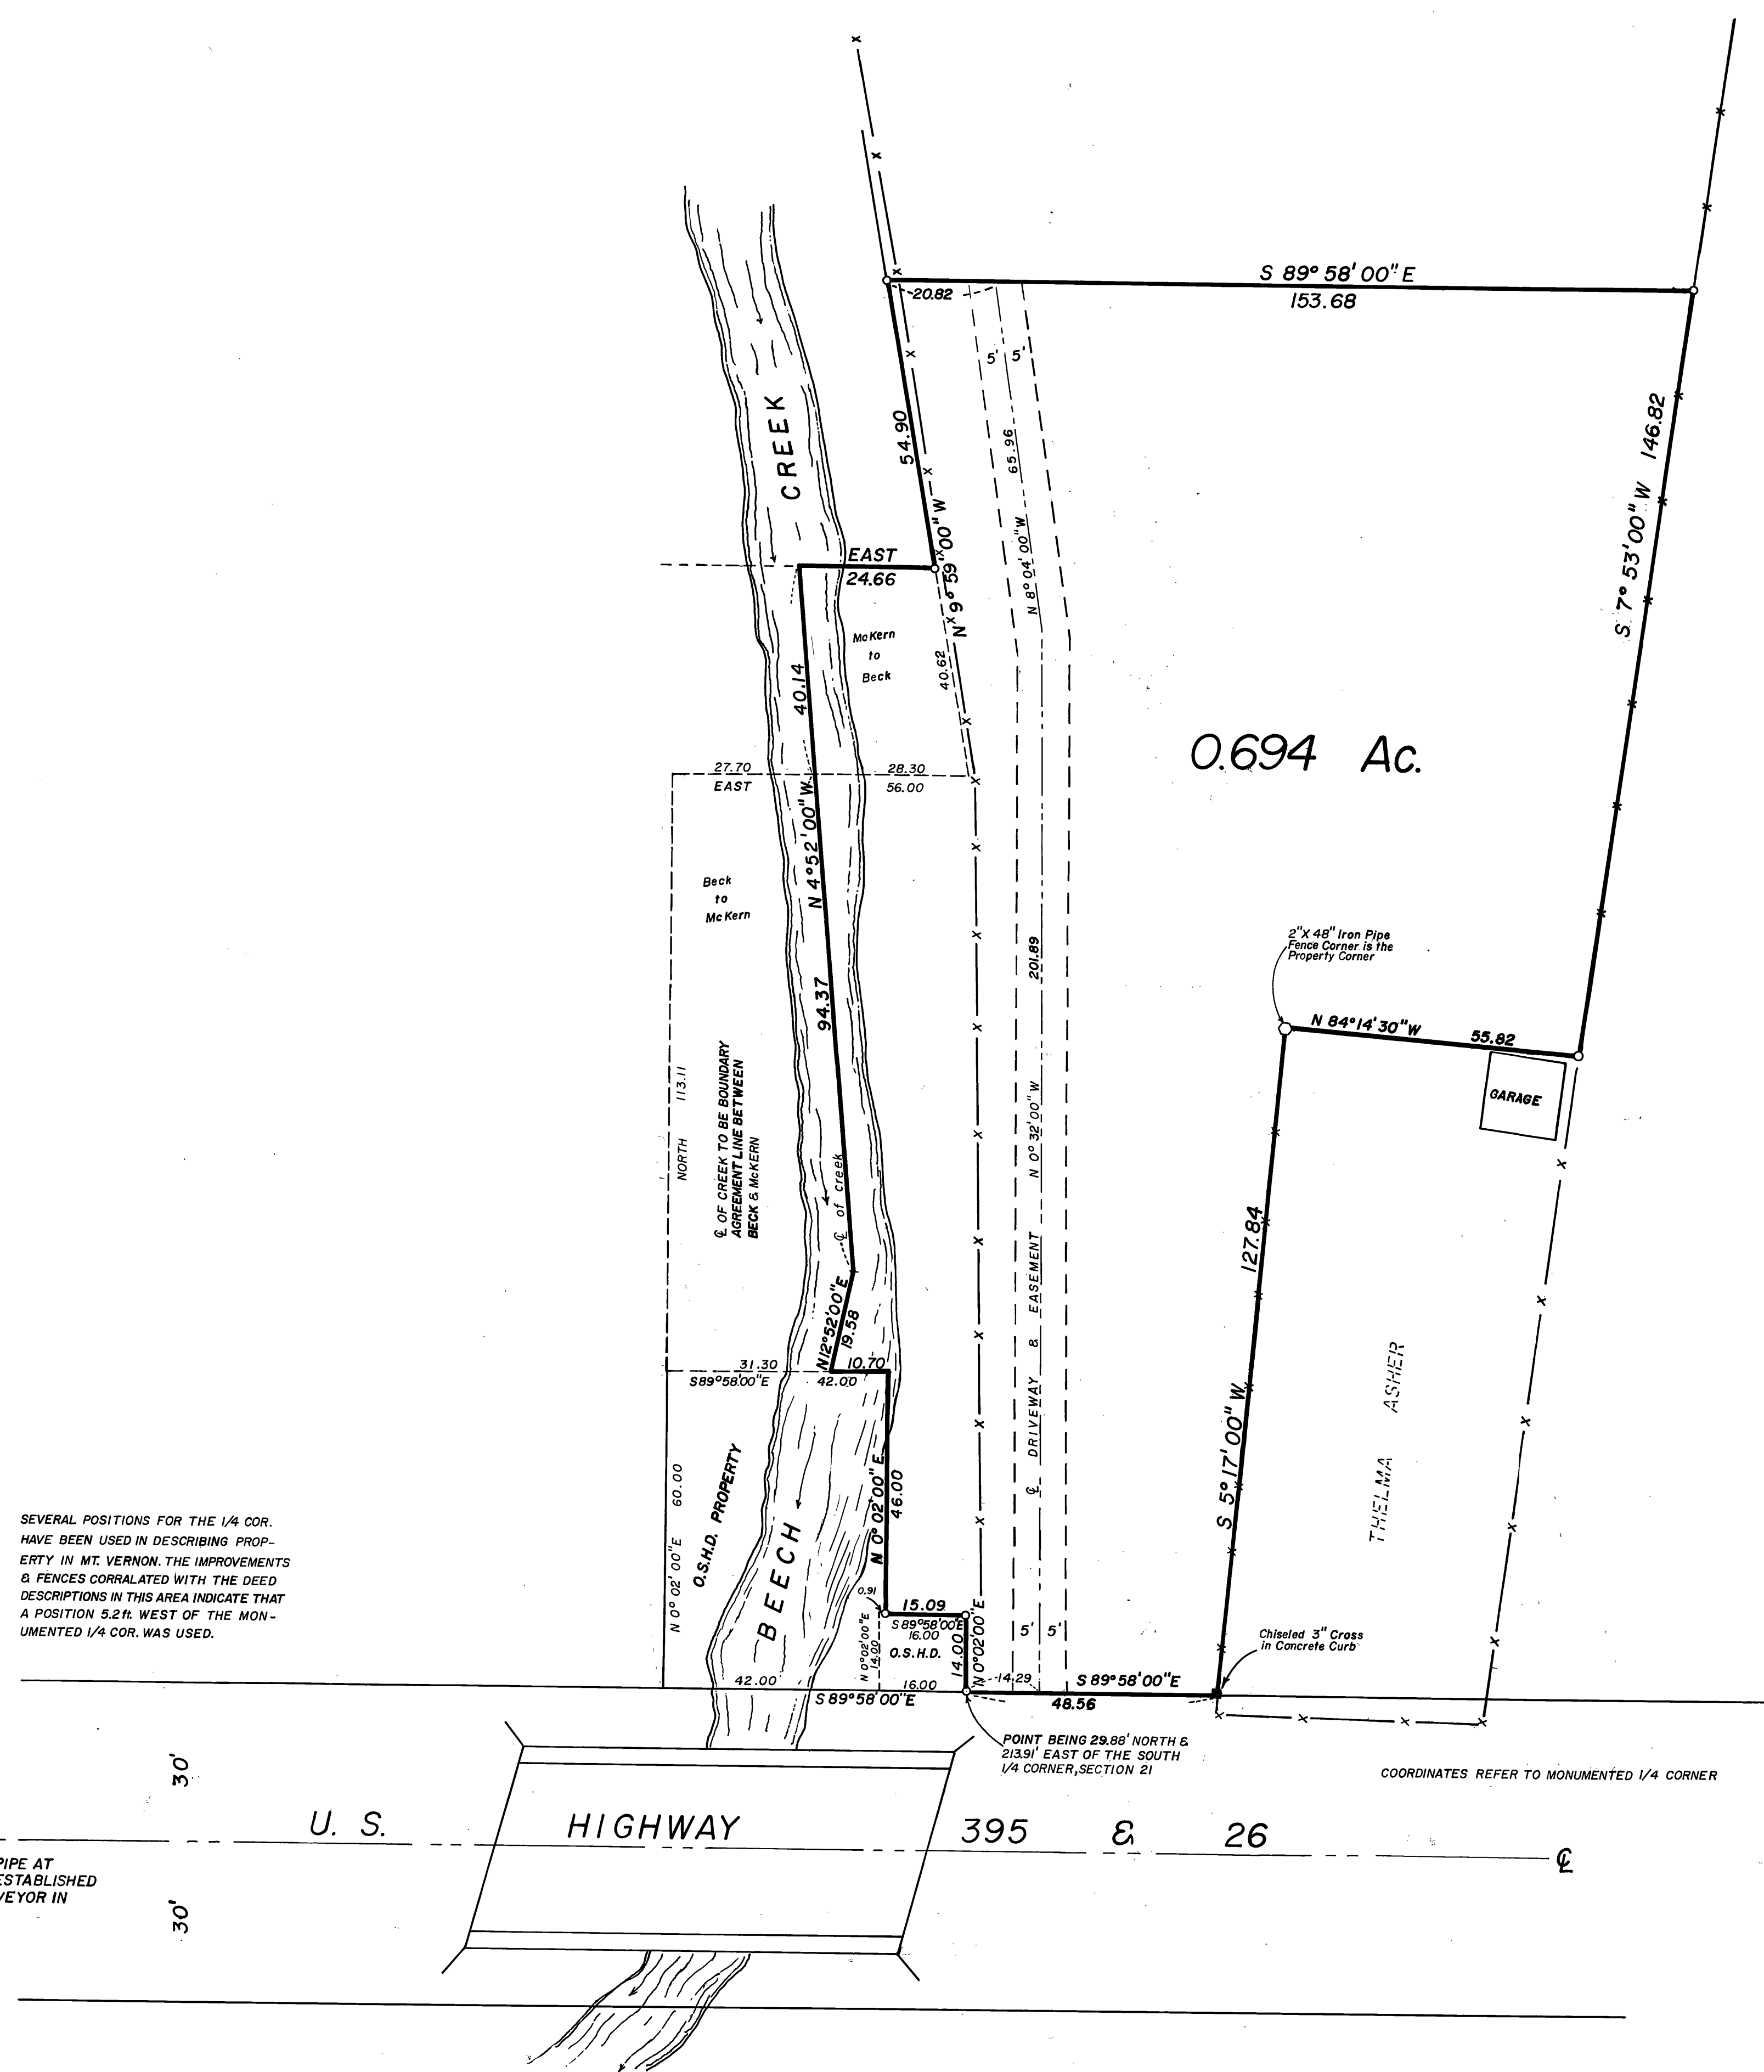

SEVERAL POSITIONS FOR THE 1/4 COR.
HAVE BEEN USED IN DESCRIBING PROP-
ERTY IN MT. VERNON. THE IMPROVEMENTS
& FENCES CORRELATED WITH THE DEED
DESCRIPTIONS IN THIS AREA INDICATE THAT
A POSITION 5.2 ft. WEST OF THE MON-
UMENTED 1/4 COR. WAS USED.

COORDINATES REFER TO MONUMENTED 1/4 CORNER