


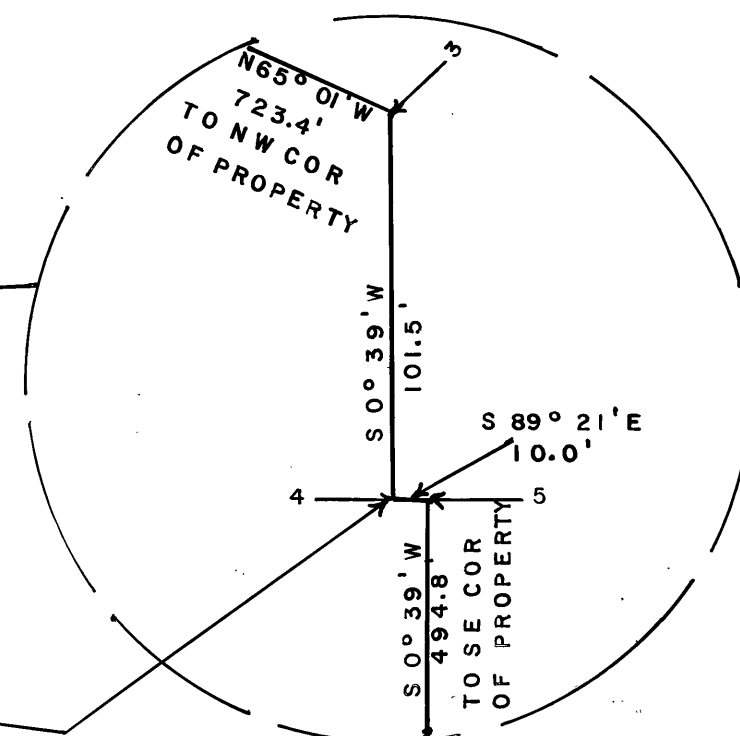

THIS SURVEY IS A RETRACEMENT OF
SURVEY NO. 369 IN ORDER TO REPLACE
THE MONUMENTS AS SHOWN.

● SET $\frac{5}{8}$ " X 30" IRON PIN
X SCRIBED "X" IN CONCRETE
O FOUND MONUMENT OF RECORD
***** FENCE
→ REFERENCES MONUMENT NO. #
SEE MAP OF SURVEY 369

SCRIBED "X" IN NORTH EDGE OF
CONCRETE SIDEWALK AT RECORD
N 66° 15' E 106.40 F.T. FROM
THE L.C.I. INITIAL POINT.

MAP OF SURVEY # 369
MAP OF SURVEY # 110

FD. PK NAIL AT L.C.I. INITIAL POINT.
CALLED AS 1/4 COR. ON SURVEY NO. 369.

REGISTERED
PROFESSIONAL
LAND SURVEYOR

OREGON
JULY 12, 1968
DOUGLAS M. FERGUSON
848

OREGON EAST ENGINEERING INC.
M.T. VERNON, OREGON

RE-SET MONUMENTS IN
SEC.4, T. 10 S., R. 30 E., W. M.
GRANT COUNTY, OREGON

FOR	MIKE STEVENS	
BY	D.M.F	B.E.G J.E.L
DRAWN BY J.E.L	MARCH 1977	SCALE 1" =

RECEIVED AND
FILED

MAY 16 1977
JOHN LIVEIRA, County Clerk

By _____ Deputy

MAP OF Survey 435