


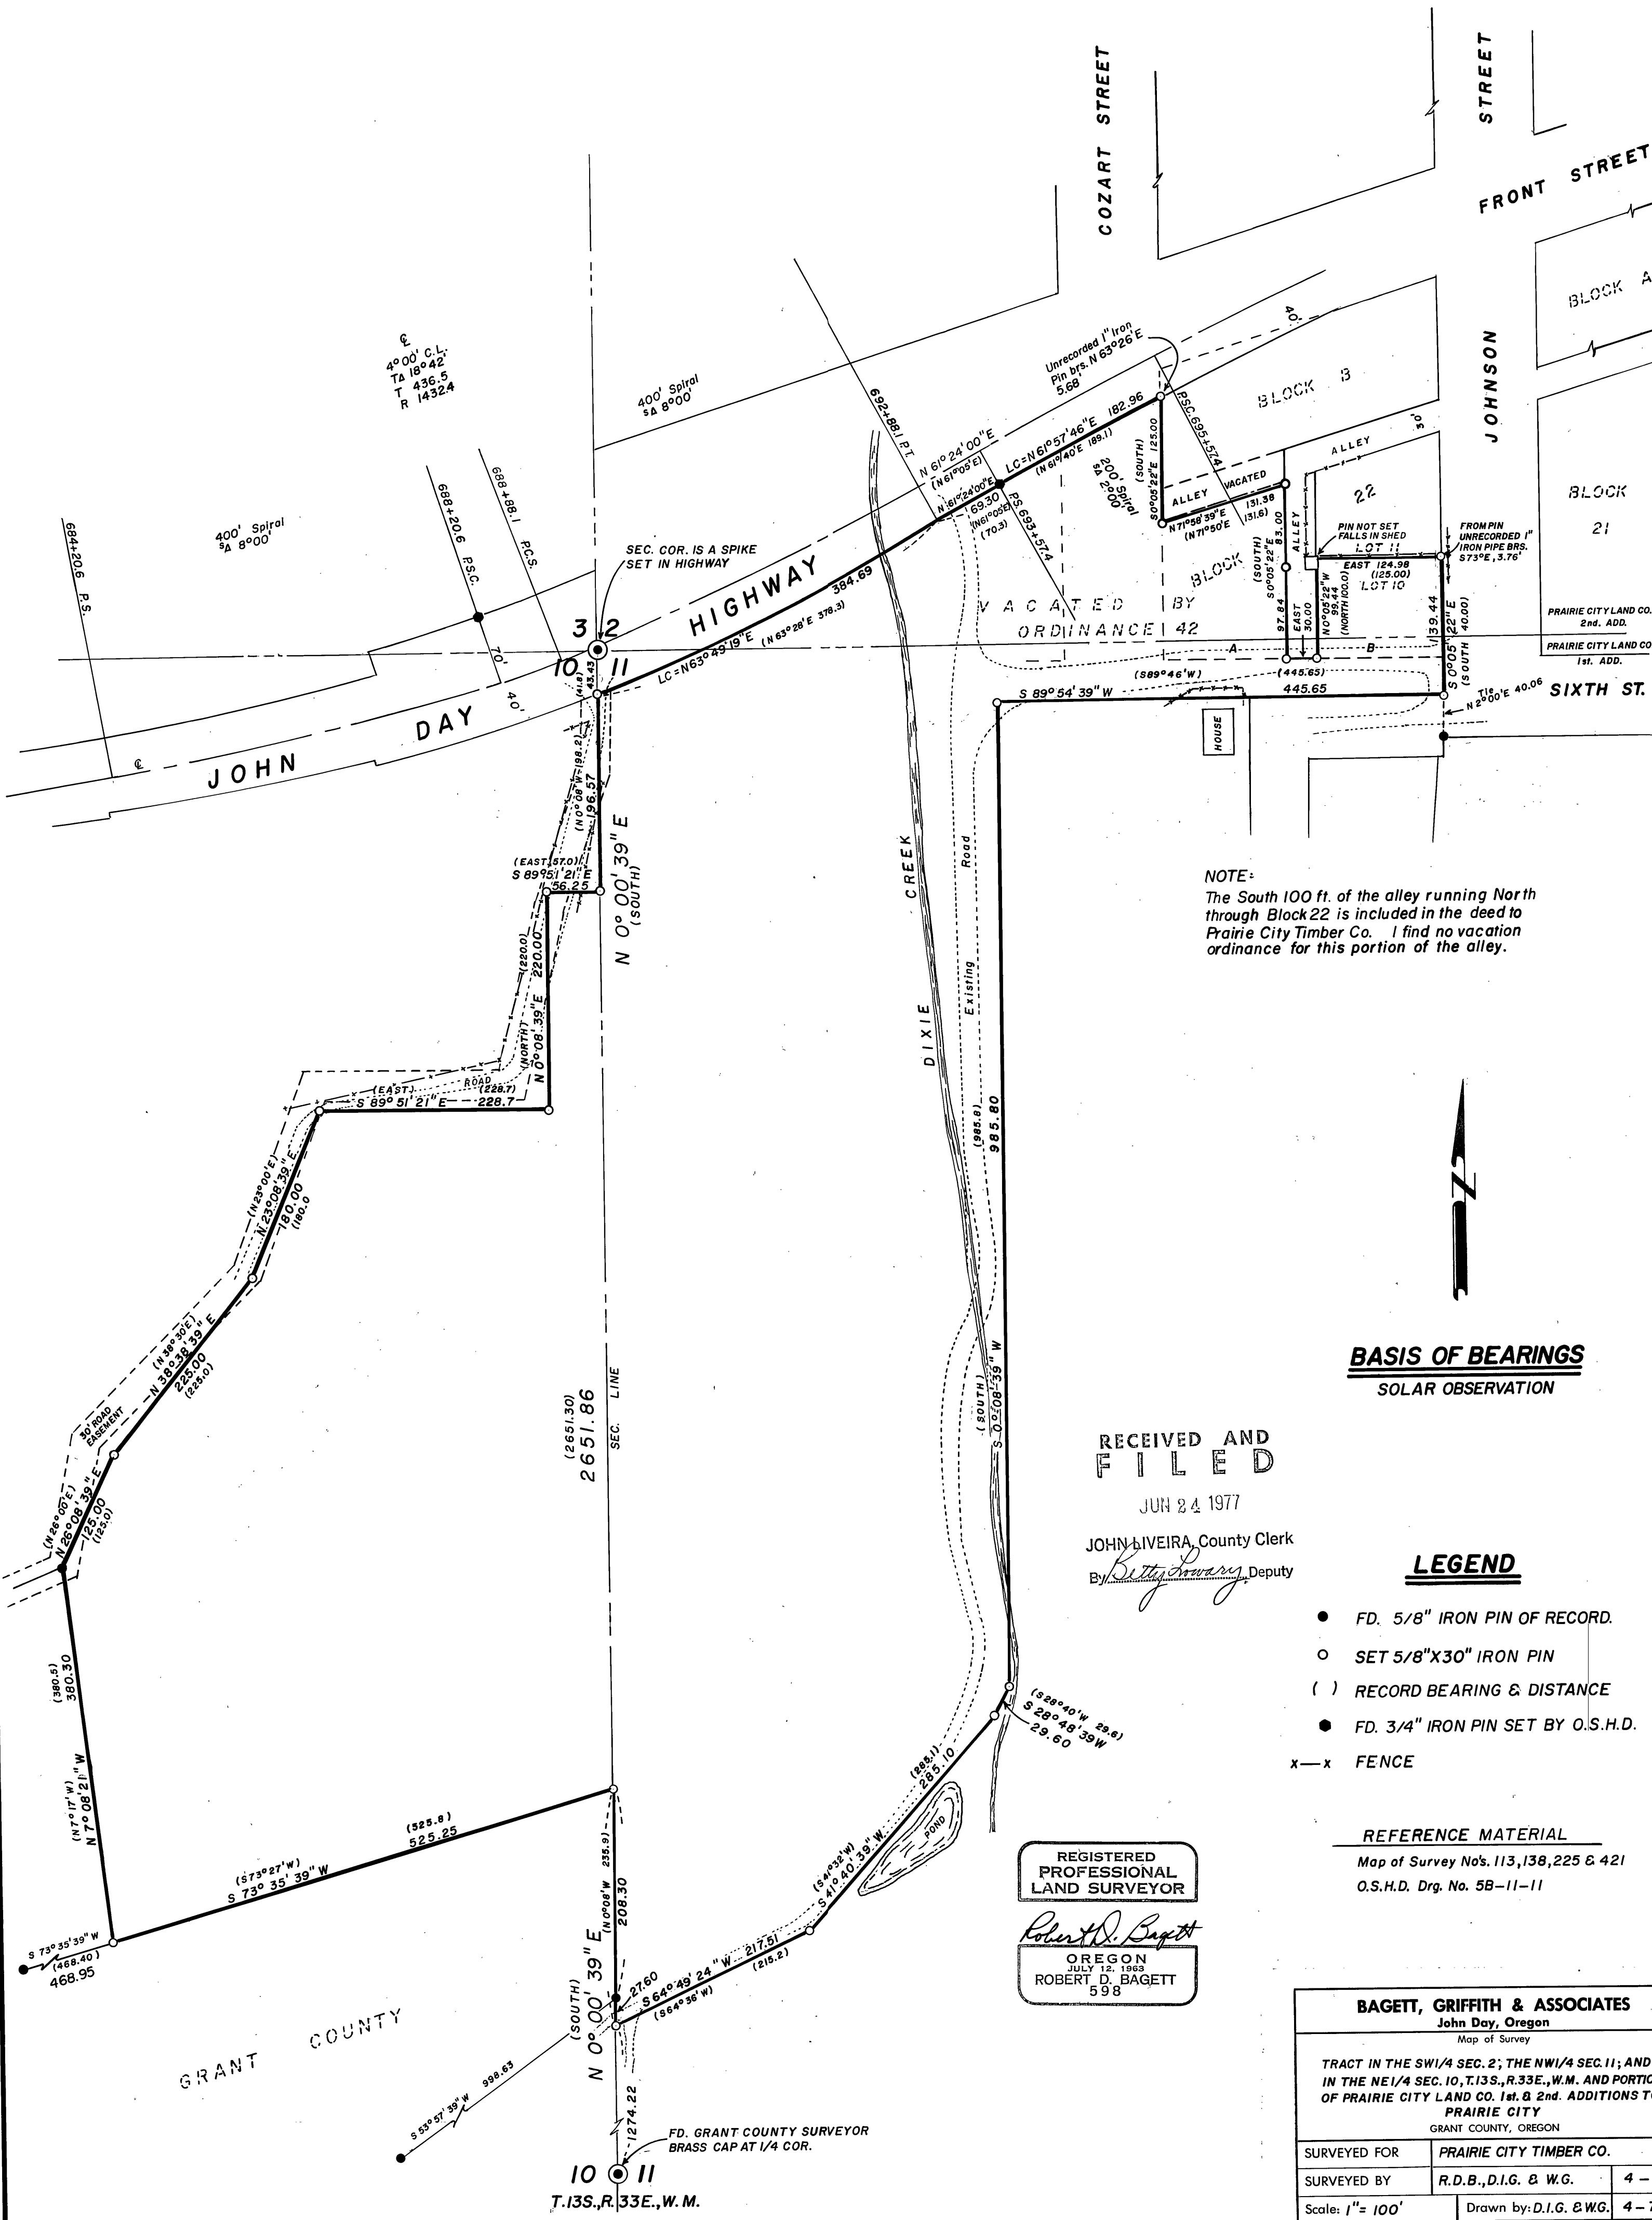

NOTE:  
The South 100 ft. of the alley running North through Block 22 is included in the deed to Prairie City Timber Co. I find no vacation ordinance for this portion of the alley.

**BASIS OF BEARINGS**  
SOLAR OBSERVATION

RECEIVED AND  
FILED

JUN 24 1977

JOHN LIVEIRA, County Clerk  

**LEGEND**

- FD. 5/8" IRON PIN OF RECORD.
- SET 5/8"x30" IRON PIN
- ( ) RECORD BEARING & DISTANCE
- FD. 3/4" IRON PIN SET BY O.S.H.D.
- x—x FENCE

**REFERENCE MATERIAL**

Map of Survey Nos. 113, 138, 225 & 421  
O.S.H.D. Drg. No. 5B-11-11

REGISTERED  
PROFESSIONAL  
LAND SURVEYOR

*Robert D. Baggett*  
OREGON  
ROBERT D. BAGGETT  
598

**BAGETT, GRIFFITH & ASSOCIATES**  
John Day, Oregon  
Map of Survey

TRACT IN THE SW1/4 SEC. 2; THE NW1/4 SEC. 11; AND  
IN THE NE1/4 SEC. 10, T.13S., R.33E., W.M. AND PORTIONS  
OF PRAIRIE CITY LAND CO. 1st. & 2nd. ADDITIONS TO  
PRAIRIE CITY  
GRANT COUNTY, OREGON

|                 |                         |      |
|-----------------|-------------------------|------|
| SURVEYED FOR    | PRAIRIE CITY TIMBER CO. |      |
| SURVEYED BY     | R.D.B., D.I.G. & W.G.   | 4-77 |
| Scale: 1"= 100' | Drawn by: D.I.G. & W.G. | 4-77 |