


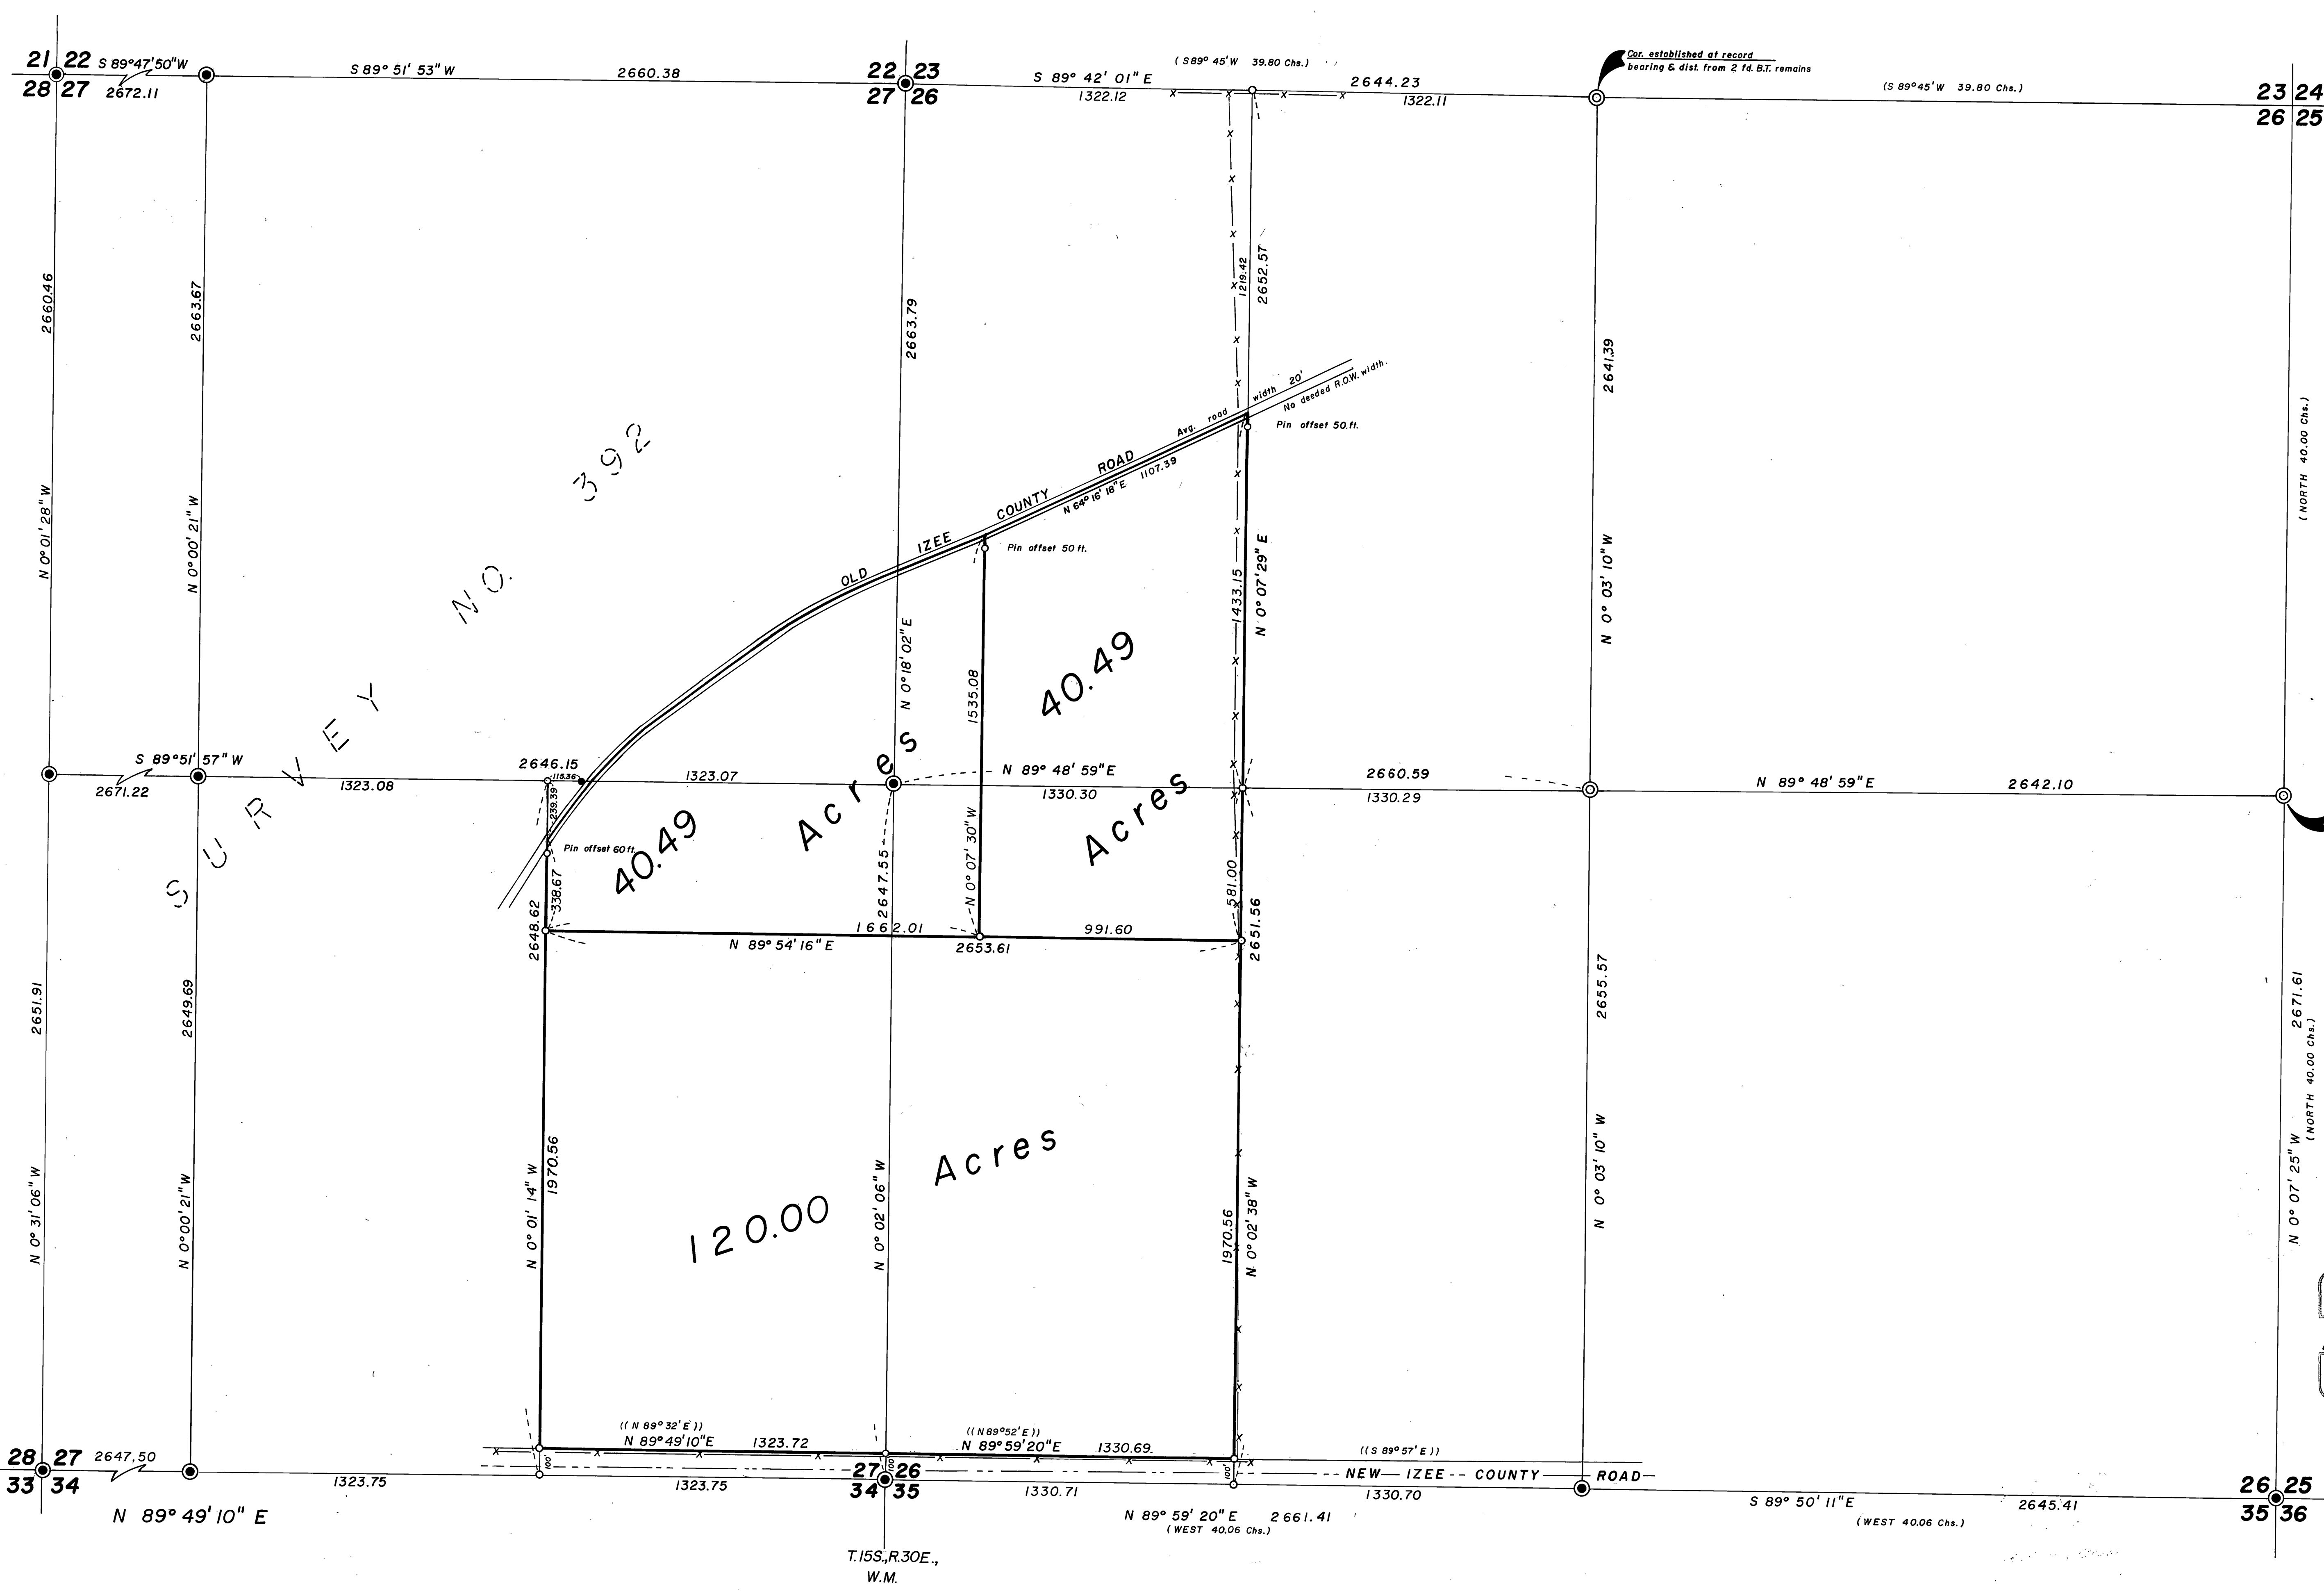

BASIS OF BEARINGS
SOLAR OBSERVATION

LEGEND

- FD. GRANT COUNTY SURVEYOR BRASS CAP
- SET GRANT COUNTY SURVEYOR BRASS CAP
- FD. 5/8" IRON PIN AS SET IN SURVEY NO. 392
- SET 5/8" X 30" IRON PIN
- () RECORD BEARING & DIST. - G.L.O.
- (()) RECORD BEARING CO. ROAD DEED
- x—x FENCE

REGISTERED
PROFESSIONAL
LAND SURVEYOR
Robert D. Baggett
ROBERT D. BAGGETT
598

RECEIVED AND
FILED
MAY 16 1977
JOHN L. VIEIRA, County Clerk
By _____ Deputy

BAGETT, GRIFFITH & ASSOCIATES John Day, Oregon Map of Survey		
TRACTS IN THE E1/2E1/2 OF SEC. 27 AND IN THE W1/2W1/2 OF SEC. 26, T.15S., R.30E., W.M.		
GRANT COUNTY, OREGON		
SURVEYED FOR	NORBERT VOLNY	
SURVEYED BY	R.D.B. & W.G.	4-77
Scale: 1"=300'	Drawn by: W.G.	4-77