


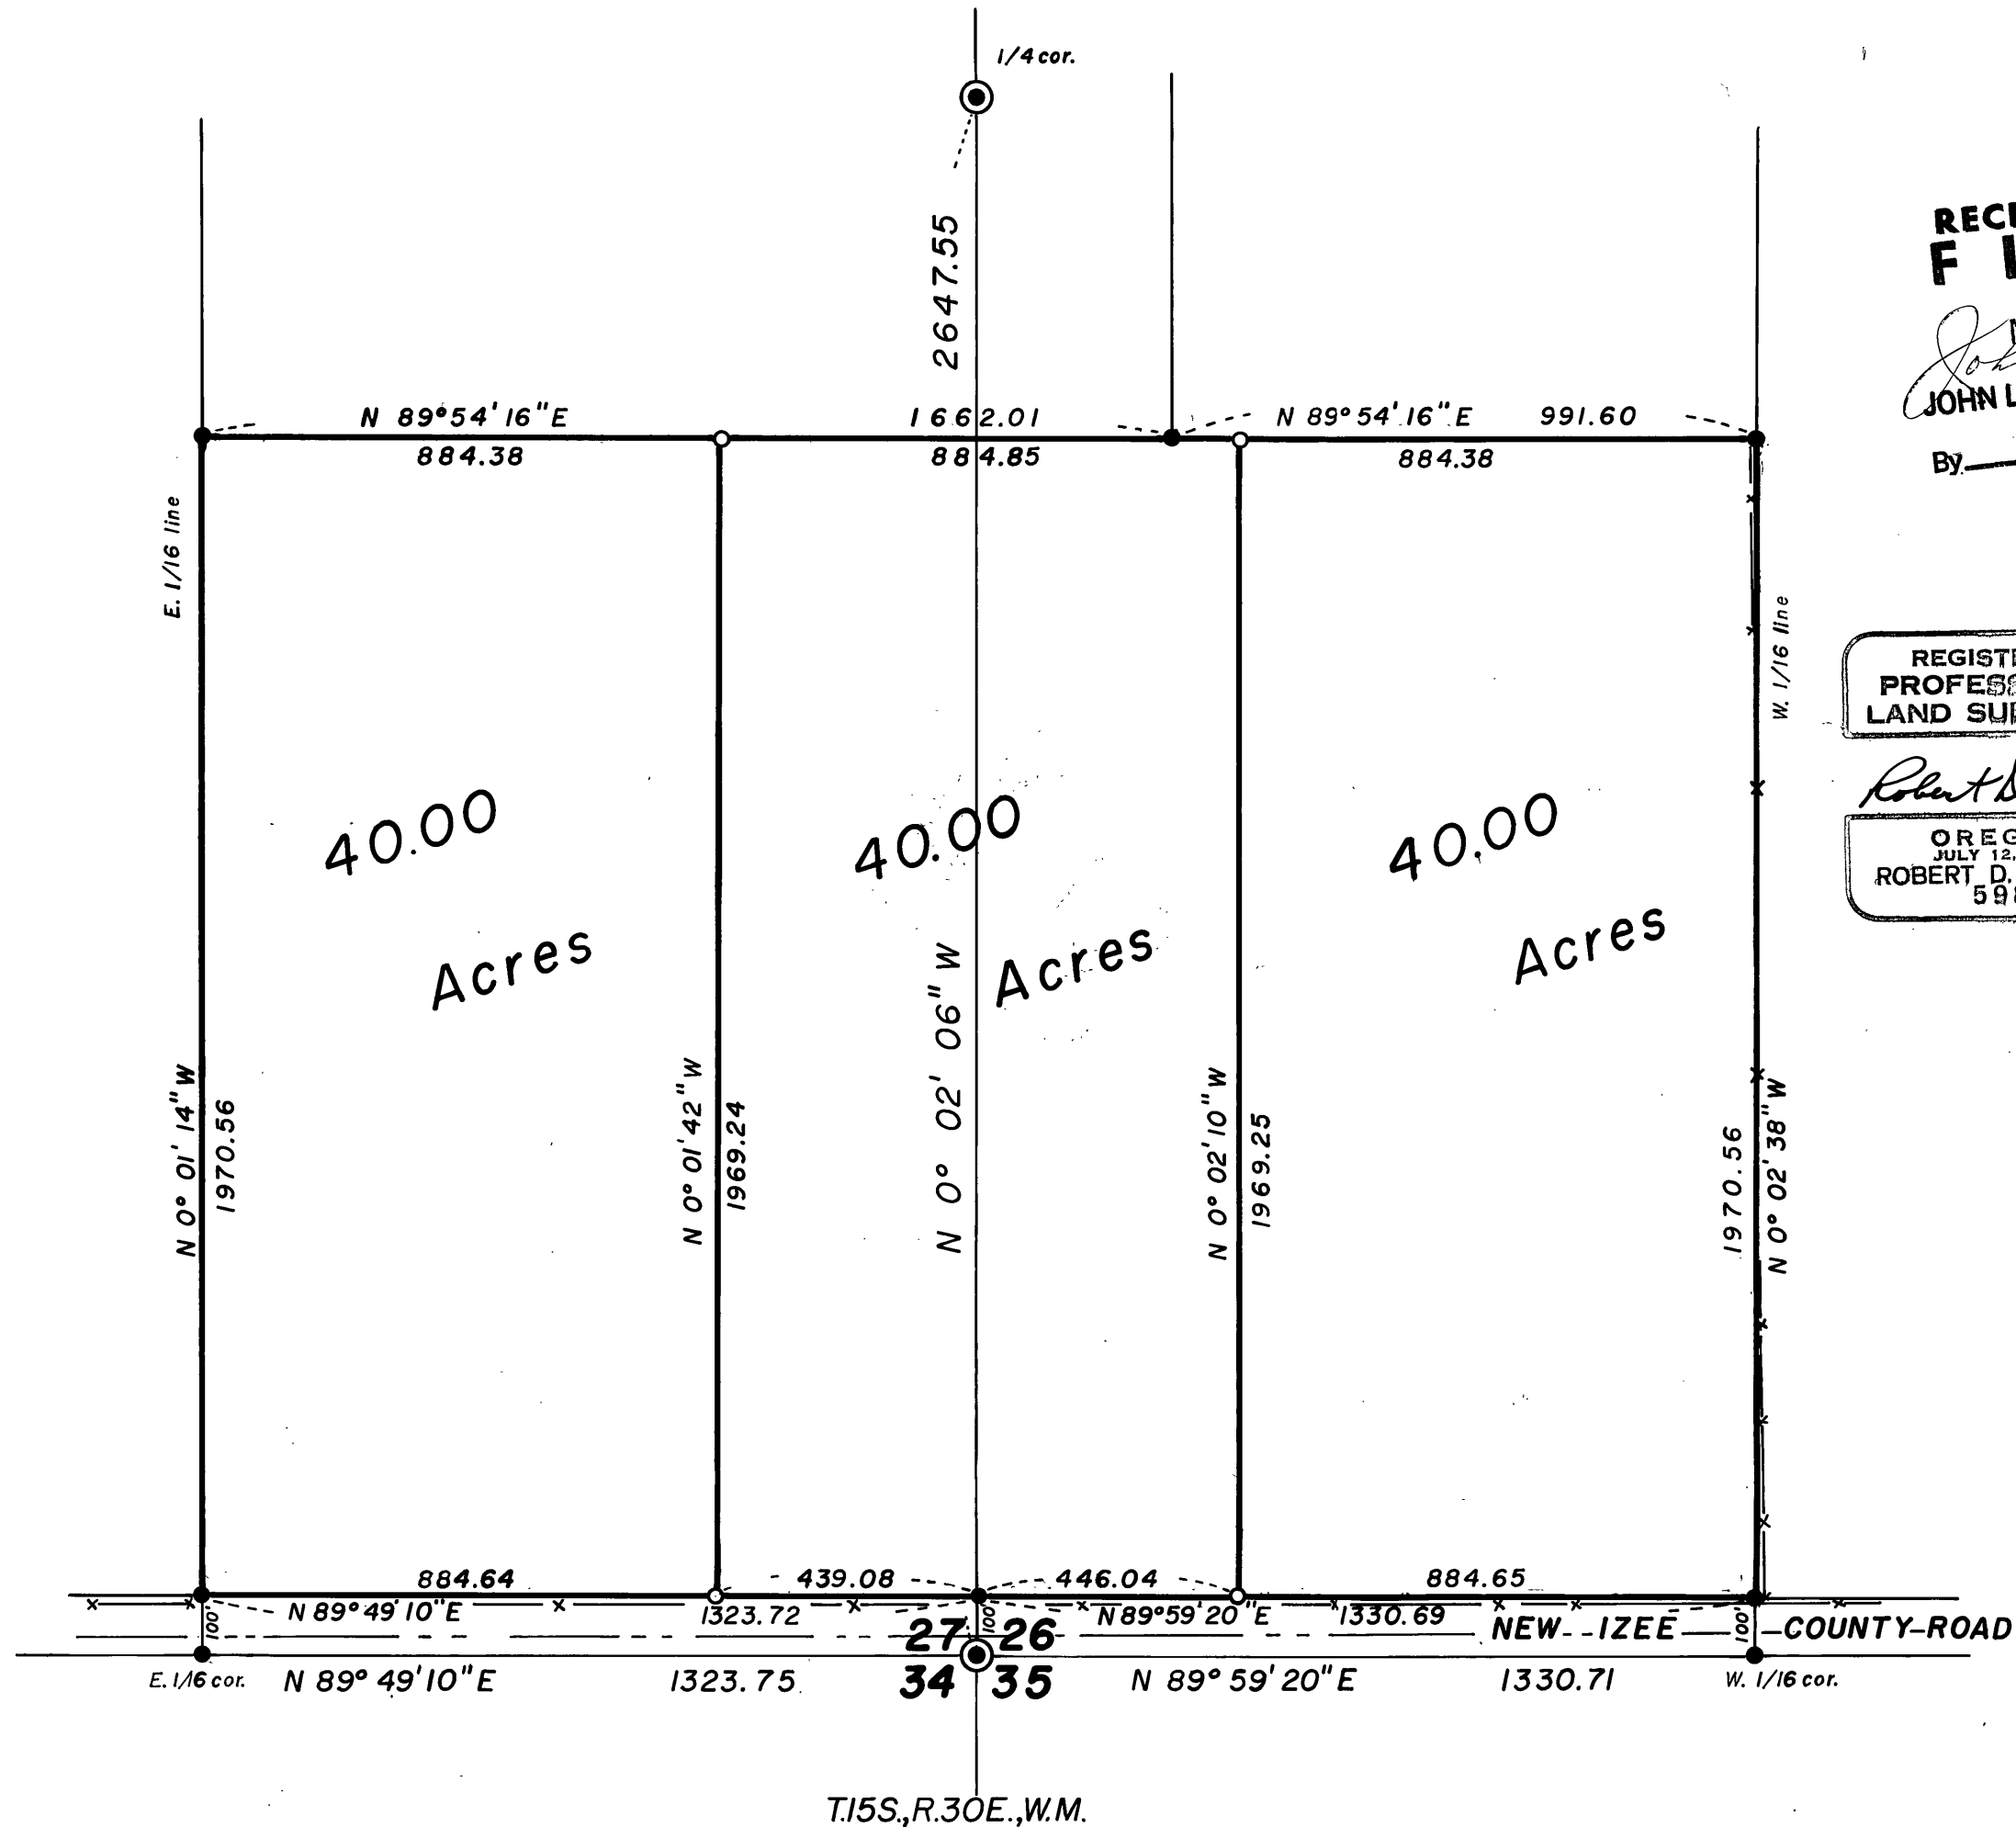

RECEIVED AND
FILED

MAY 16 1977
JOHN LIVEIRA, County Clerk
By _____ Deputy



BASIS OF BEARINGS
SURVEY NO. 444

REGISTERED
PROFESSIONAL
LAND SURVEYOR

Robert D. Bagett

OREGON
JULY 12, 1963
ROBERT D. BAGETT
598

LEGEND

- FD. GRANT CO. SURVEYOR BRASS CAP
- FD. 5/8" IRON PIN
- SET 5/8" X 30" IRON PIN
- x — x FENCE

REFERENCE MATERIAL:
Map of Survey no. 444

BAGETT, GRIFFITH & ASSOCIATES
John Day, Oregon
Map of Survey

TRACTS IN THE E1/2SE1/4 OF SEC. 27 AND IN THE
W1/2SW1/4 SEC. 26, T.15S., R.30E.,
WILLAMETTE MERIDIAN
GRANT COUNTY, OREGON

SURVEYED FOR	NORBERT J. VOLNY	
SURVEYED BY	R. D. B. & W. G.	5 - 77
Scale: 1" = 300'	Drawn by: W. G.	5 - 77