


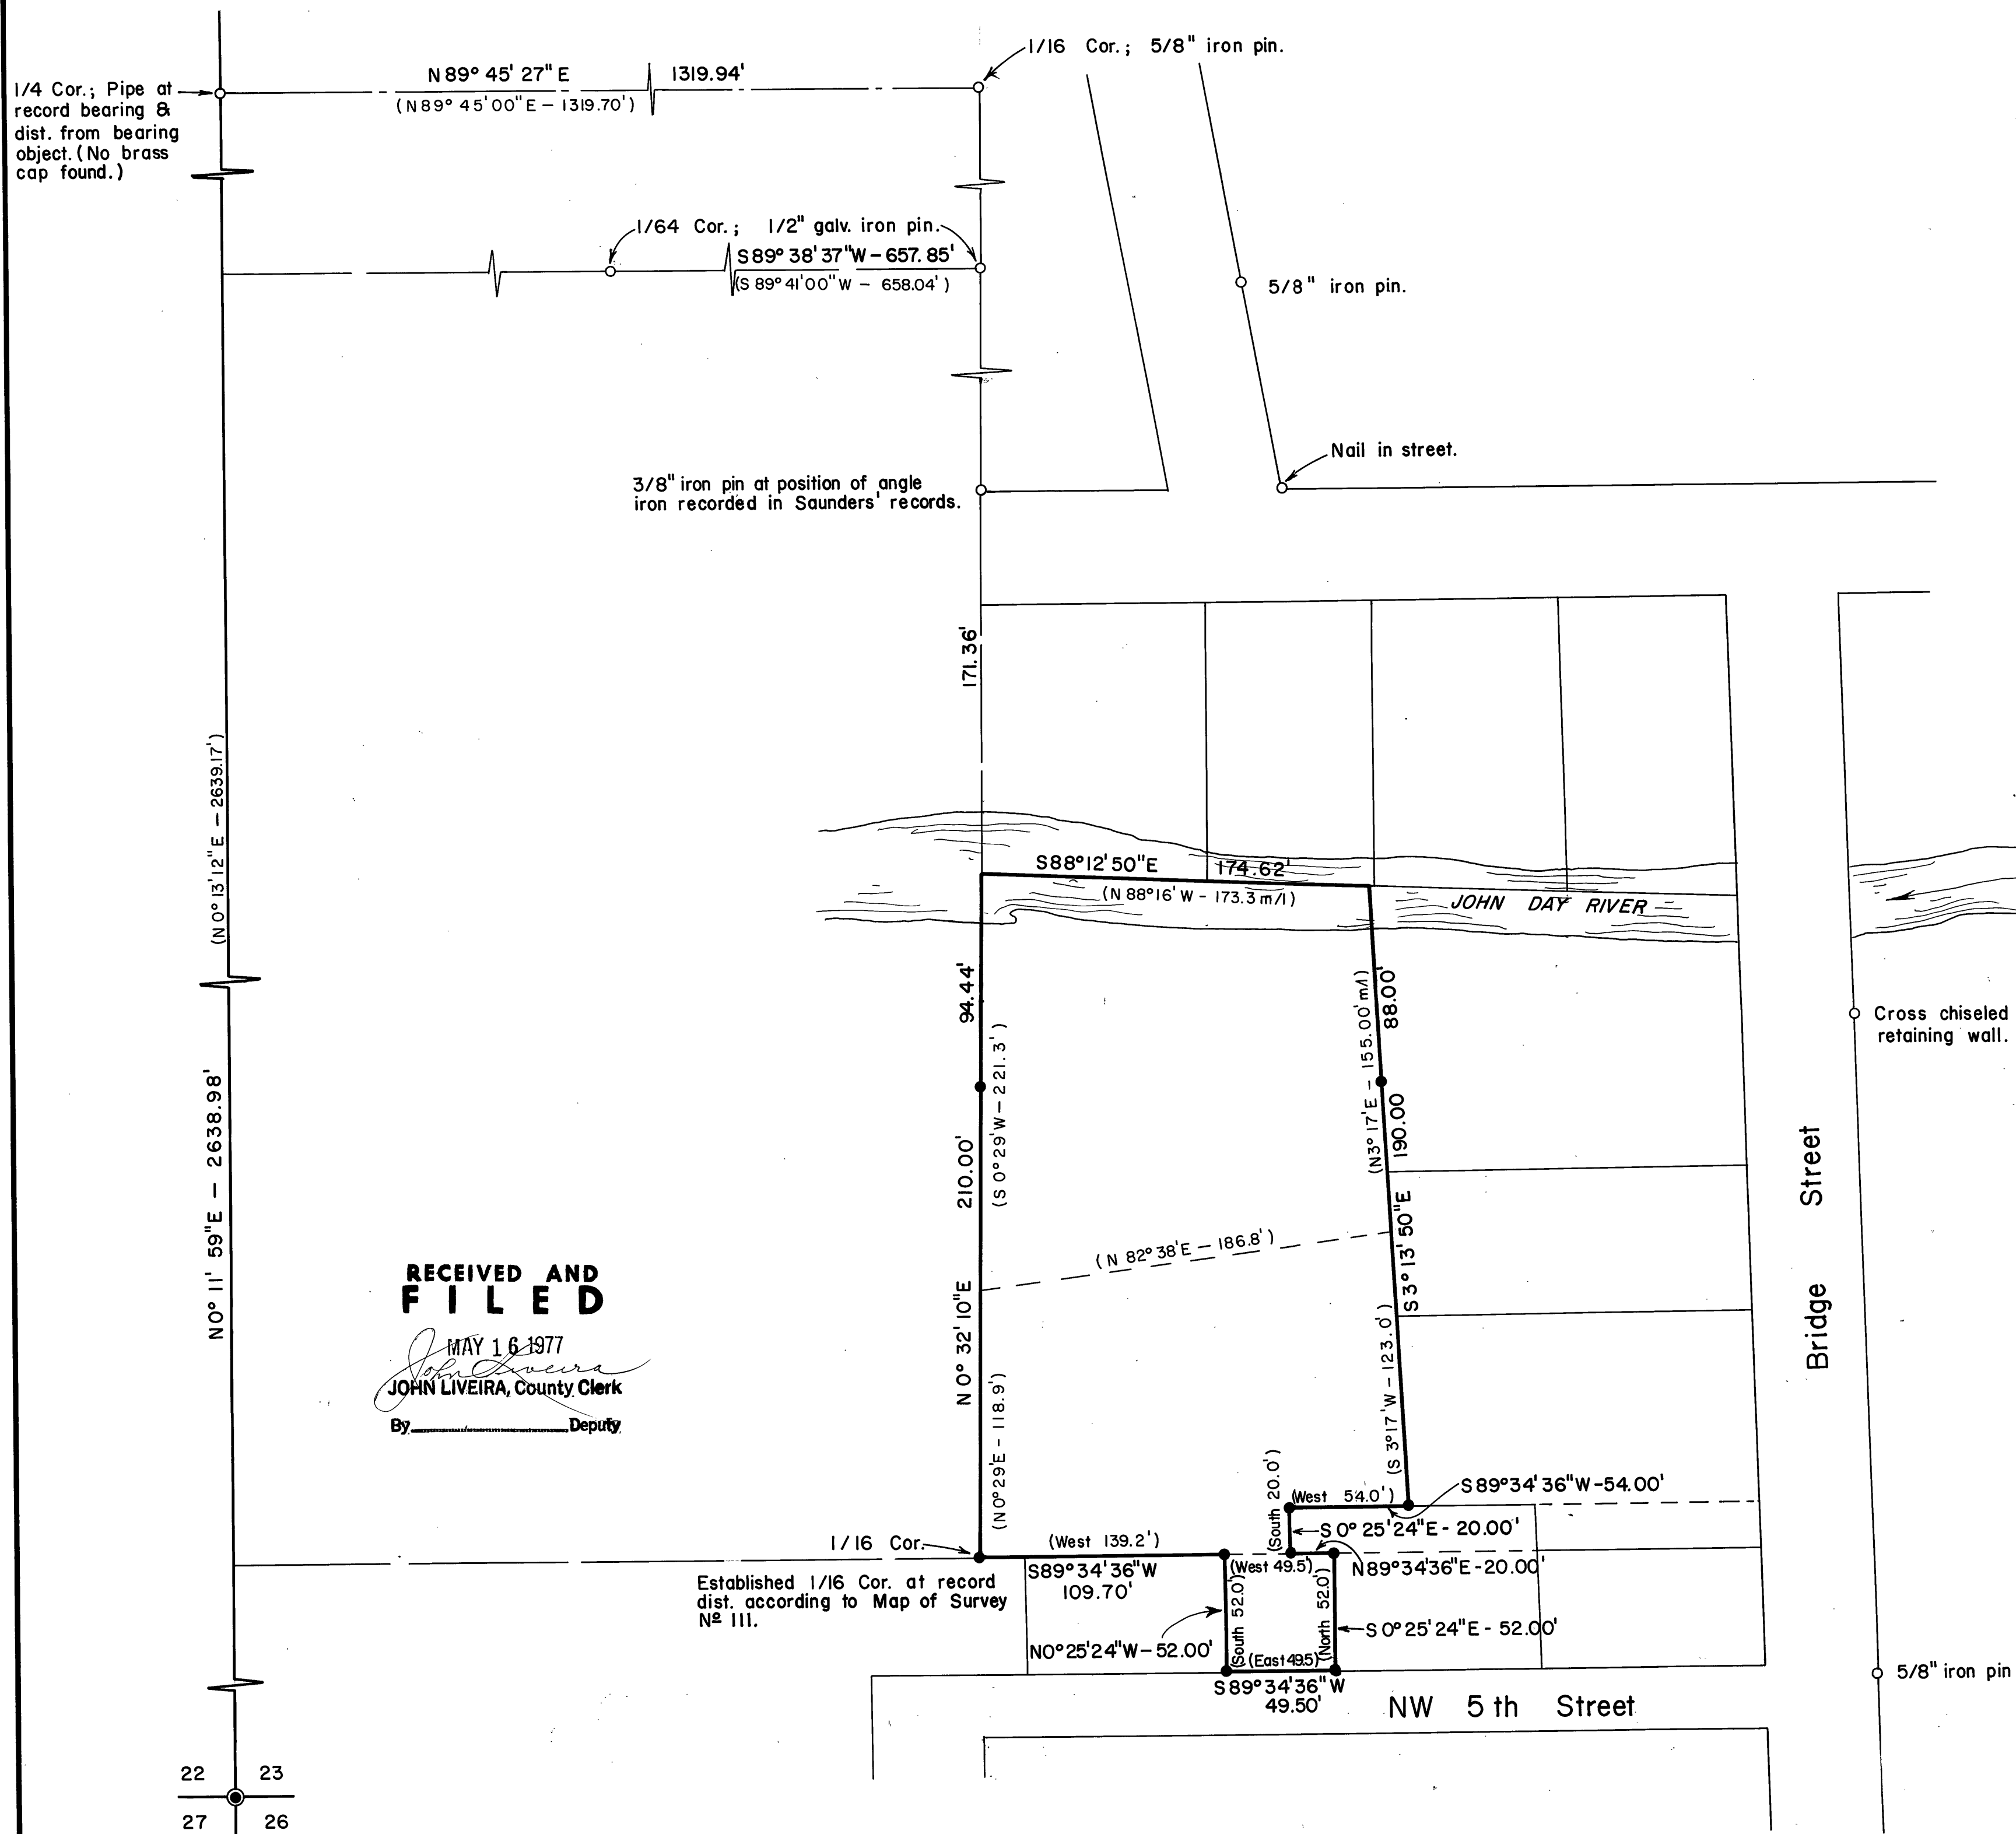

BASIS OF BEARINGS
East line of the NW 1/4 of the SW 1/4 of Section 23 according to map of survey III.

LEGEND

- Axle set in conc. Found monument.
- Set 5/8"x30" iron pin. Brg. & Dist. of record
- () Cross chiseled in conc. retaining wall.

REFERENCES

Map of Survey No. III.
Map of Survey No. 355
Map of Survey No. 424
Deed descriptions

RECEIVED AND FILED

MAY 16 1977
JOHN LIVEIRA, County Clerk
By _____ Deputy

REGISTERED PROFESSIONAL LAND SURVEYOR

OREGON
JULY 12, 1968
DOUGLAS M. FERGUSON
848

OREGON EAST ENGINEERING, INC. MT. VERNON, ORE.			
MAP of SURVEY			
PARCEL IN. W1/2, E1/2, SW1/4			
Section 23, T13S, R31E, WM			
GRANT COUNTY			
Surveyed for	FRANK ASHER		
Surveyed by	D.M.F., J.A.L., B.E.G., JEL	3/77	
Scale: 1" = 50'	Drawn by	J.A.L.	3/77

MAP OF SURVEY No. 446