


RECEIVED AND
FILED

MAY 16 1977
John Liveira
JOHN LIVEIRA, County Clerk
By _____ Deputy

PROPOSED RELOCATION
GRANT COUNTY, ORE. IZEE ROAD
5-16-77 SCALE 1"=1000'

Note:
This map of Survey was recently recovered
from James D. Hanley, P.E.
MR. Hanley informed me that
he no longer has
The original drawing and
authored me to file his only copy.
This survey executed in
Robert L. Sargent
Grant County Surveyor.

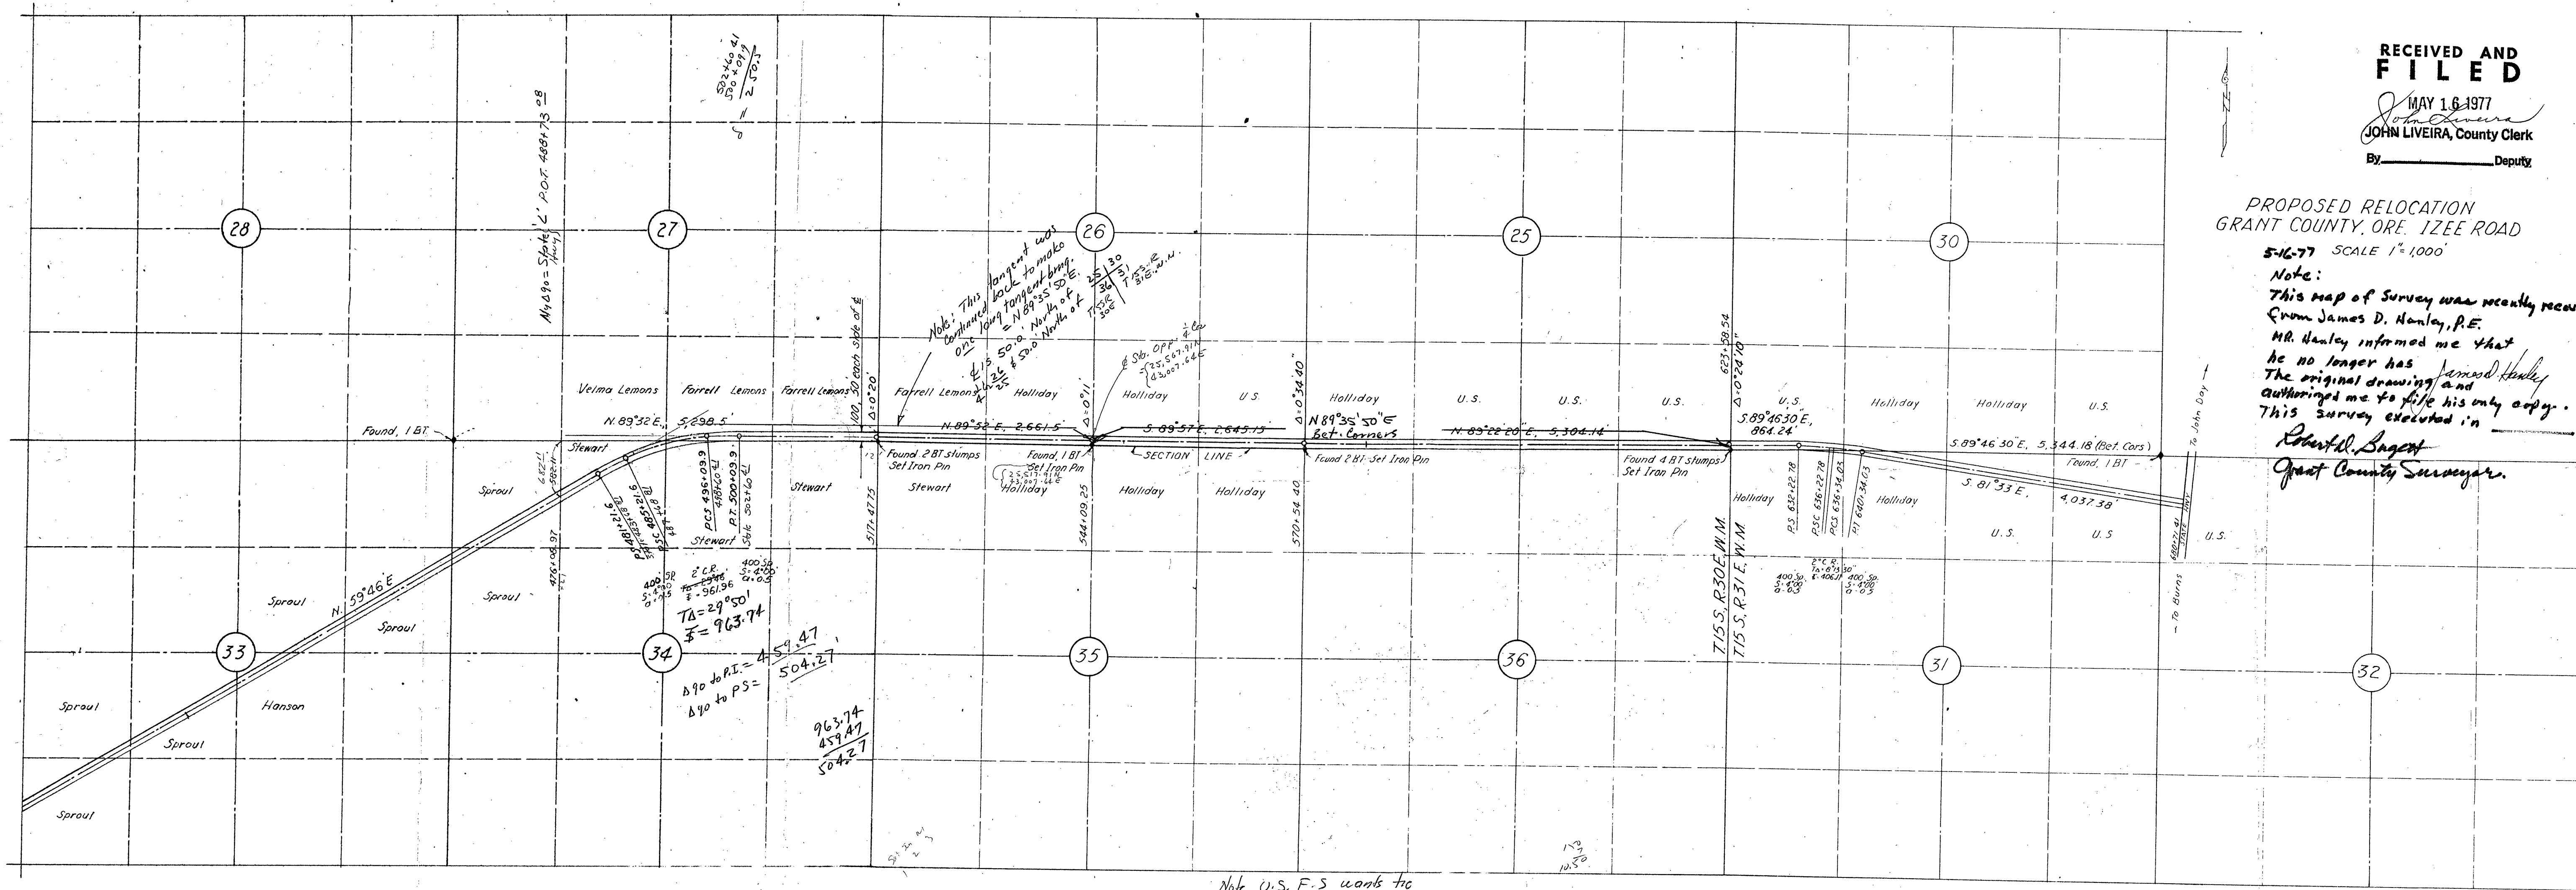

Note U.S. F.S. wants tie
to Sta 421+00