


BASIS OF BEARINGS
SOLAR OBSERVATION

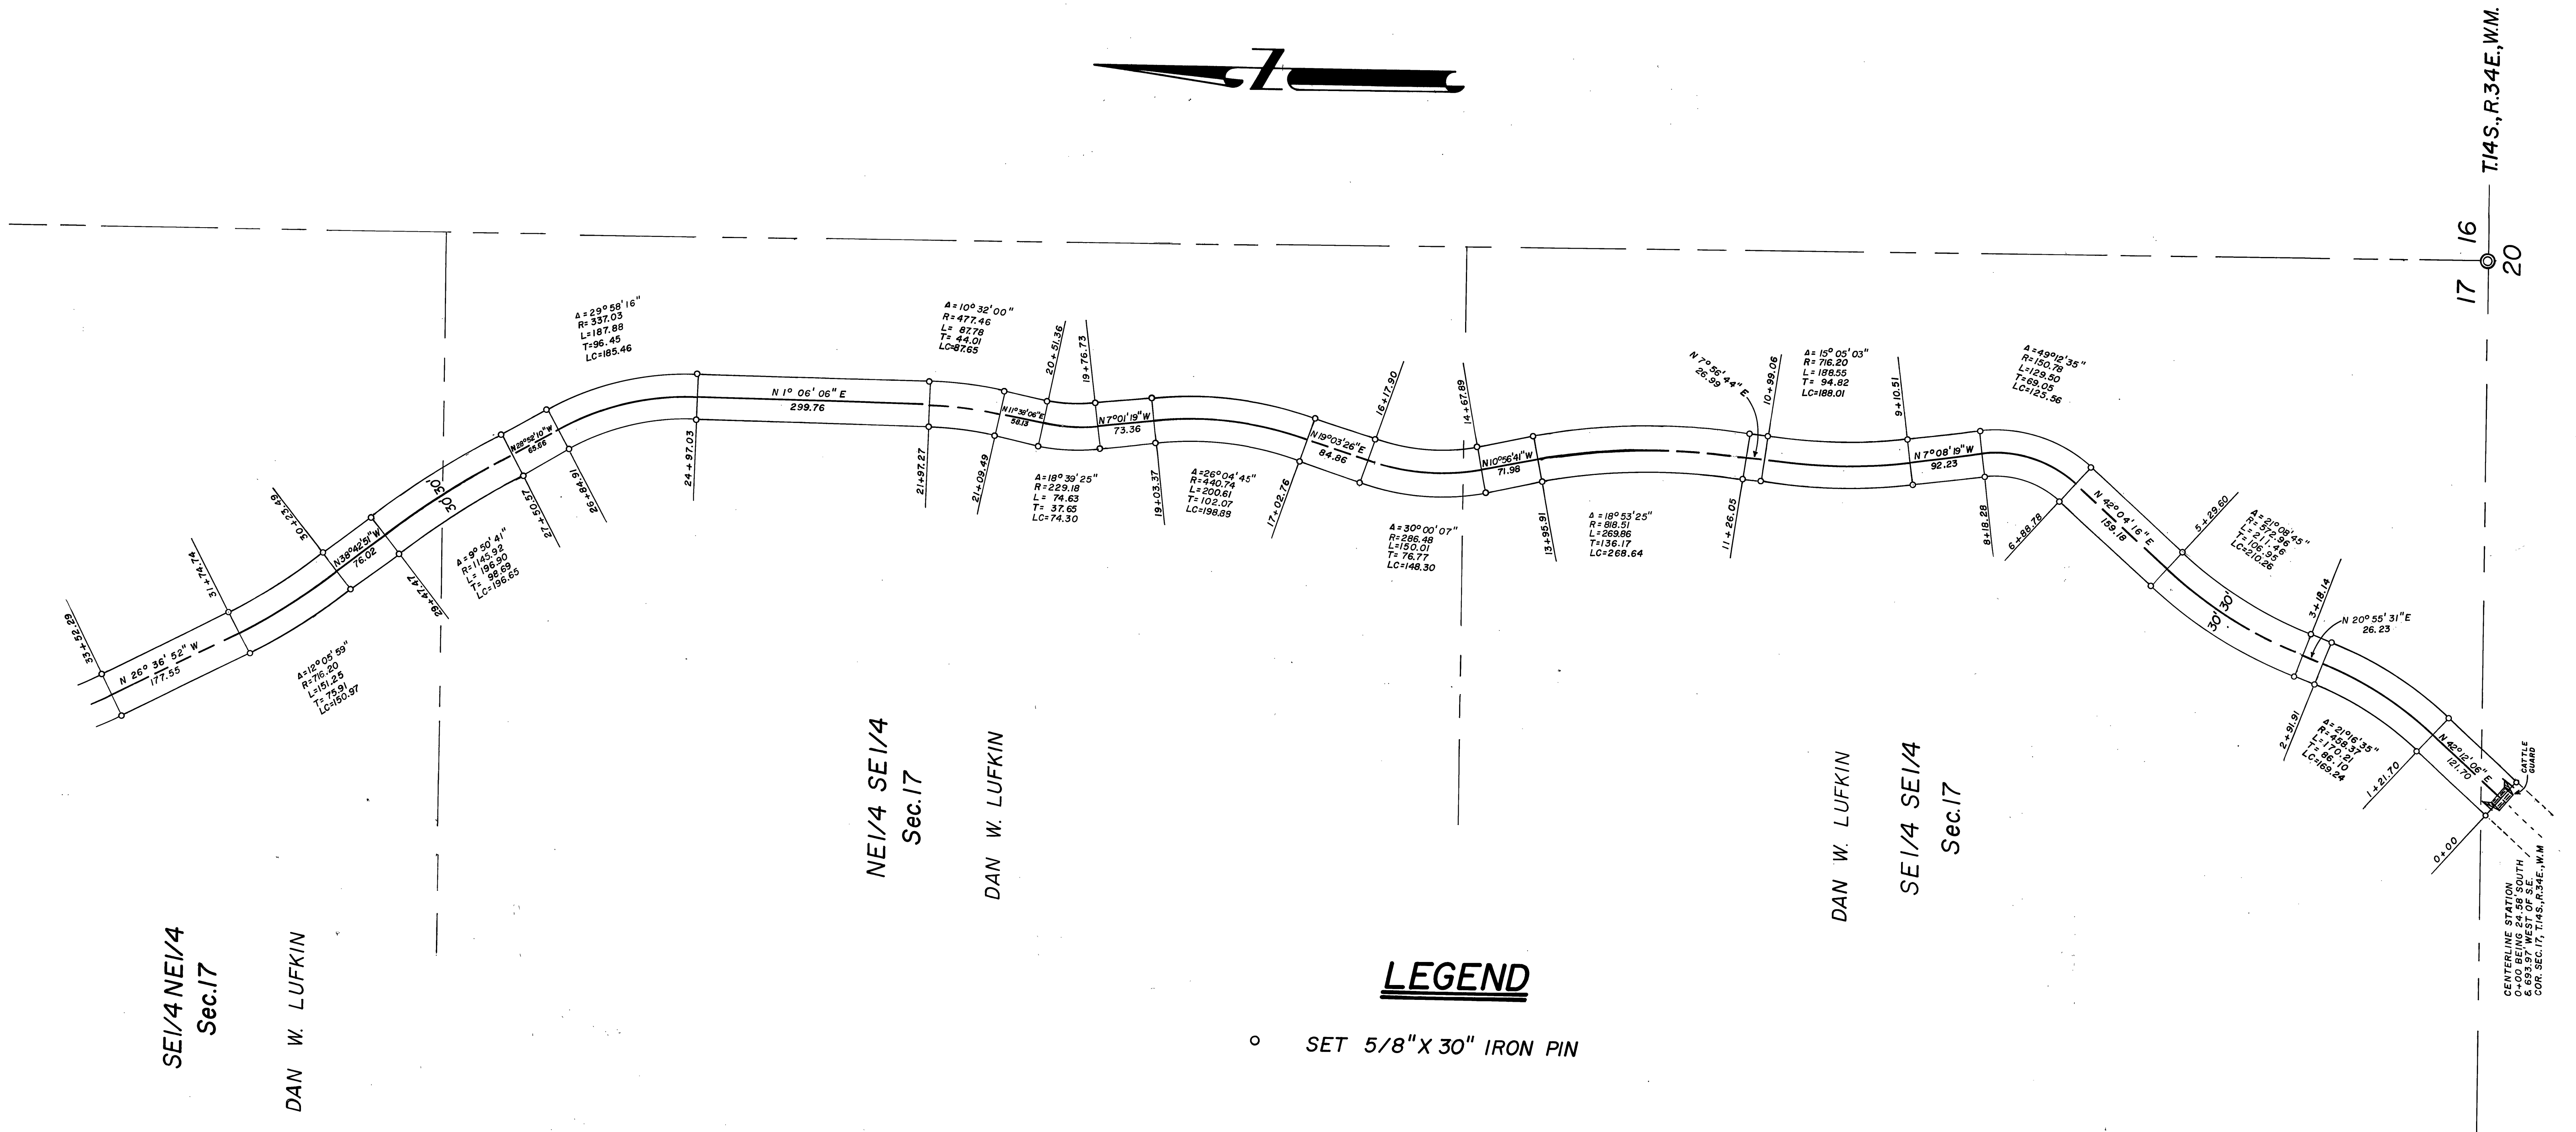

LEGEND

○ SET 5/8" X 30" IRON PIN

RECEIVED AND
FILED

JUN 24 1977


JOHN OLIVEIRA, County Clerk
By *Robert D. Baggett* Deputy

NOTE:

ALL ROAD DATA PERTAINS TO CENTERLINE.

THE CENTERLINE SHOWN GENERALLY FOLLOWS
OF EXISTING ROAD.

SEC. LINES & 1/16 LINES ARE PROJECTED FROM
FD. COR. AT THE S.E. COR., SEC. 17

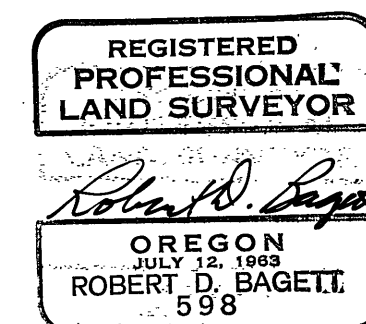

BAGETT, GRIFFITH & ASSOCIATES John Day, Oregon Map of Survey		
COUNTY ROAD NO. 60 (STRAWBERRY ROAD) SEC. 17 T.14S., R.34E., W.1M. GRANT COUNTY, OREGON		
SURVEYED FOR	GRANT COUNTY ROAD DEPT.	
SURVEYED BY	R.D.B. & W.G.	5-1977
Scale: 1" = 100'	Drawn by: W.G.	5-1977