


BASIS OF BEARINGS
SOLAR OBSERVATION

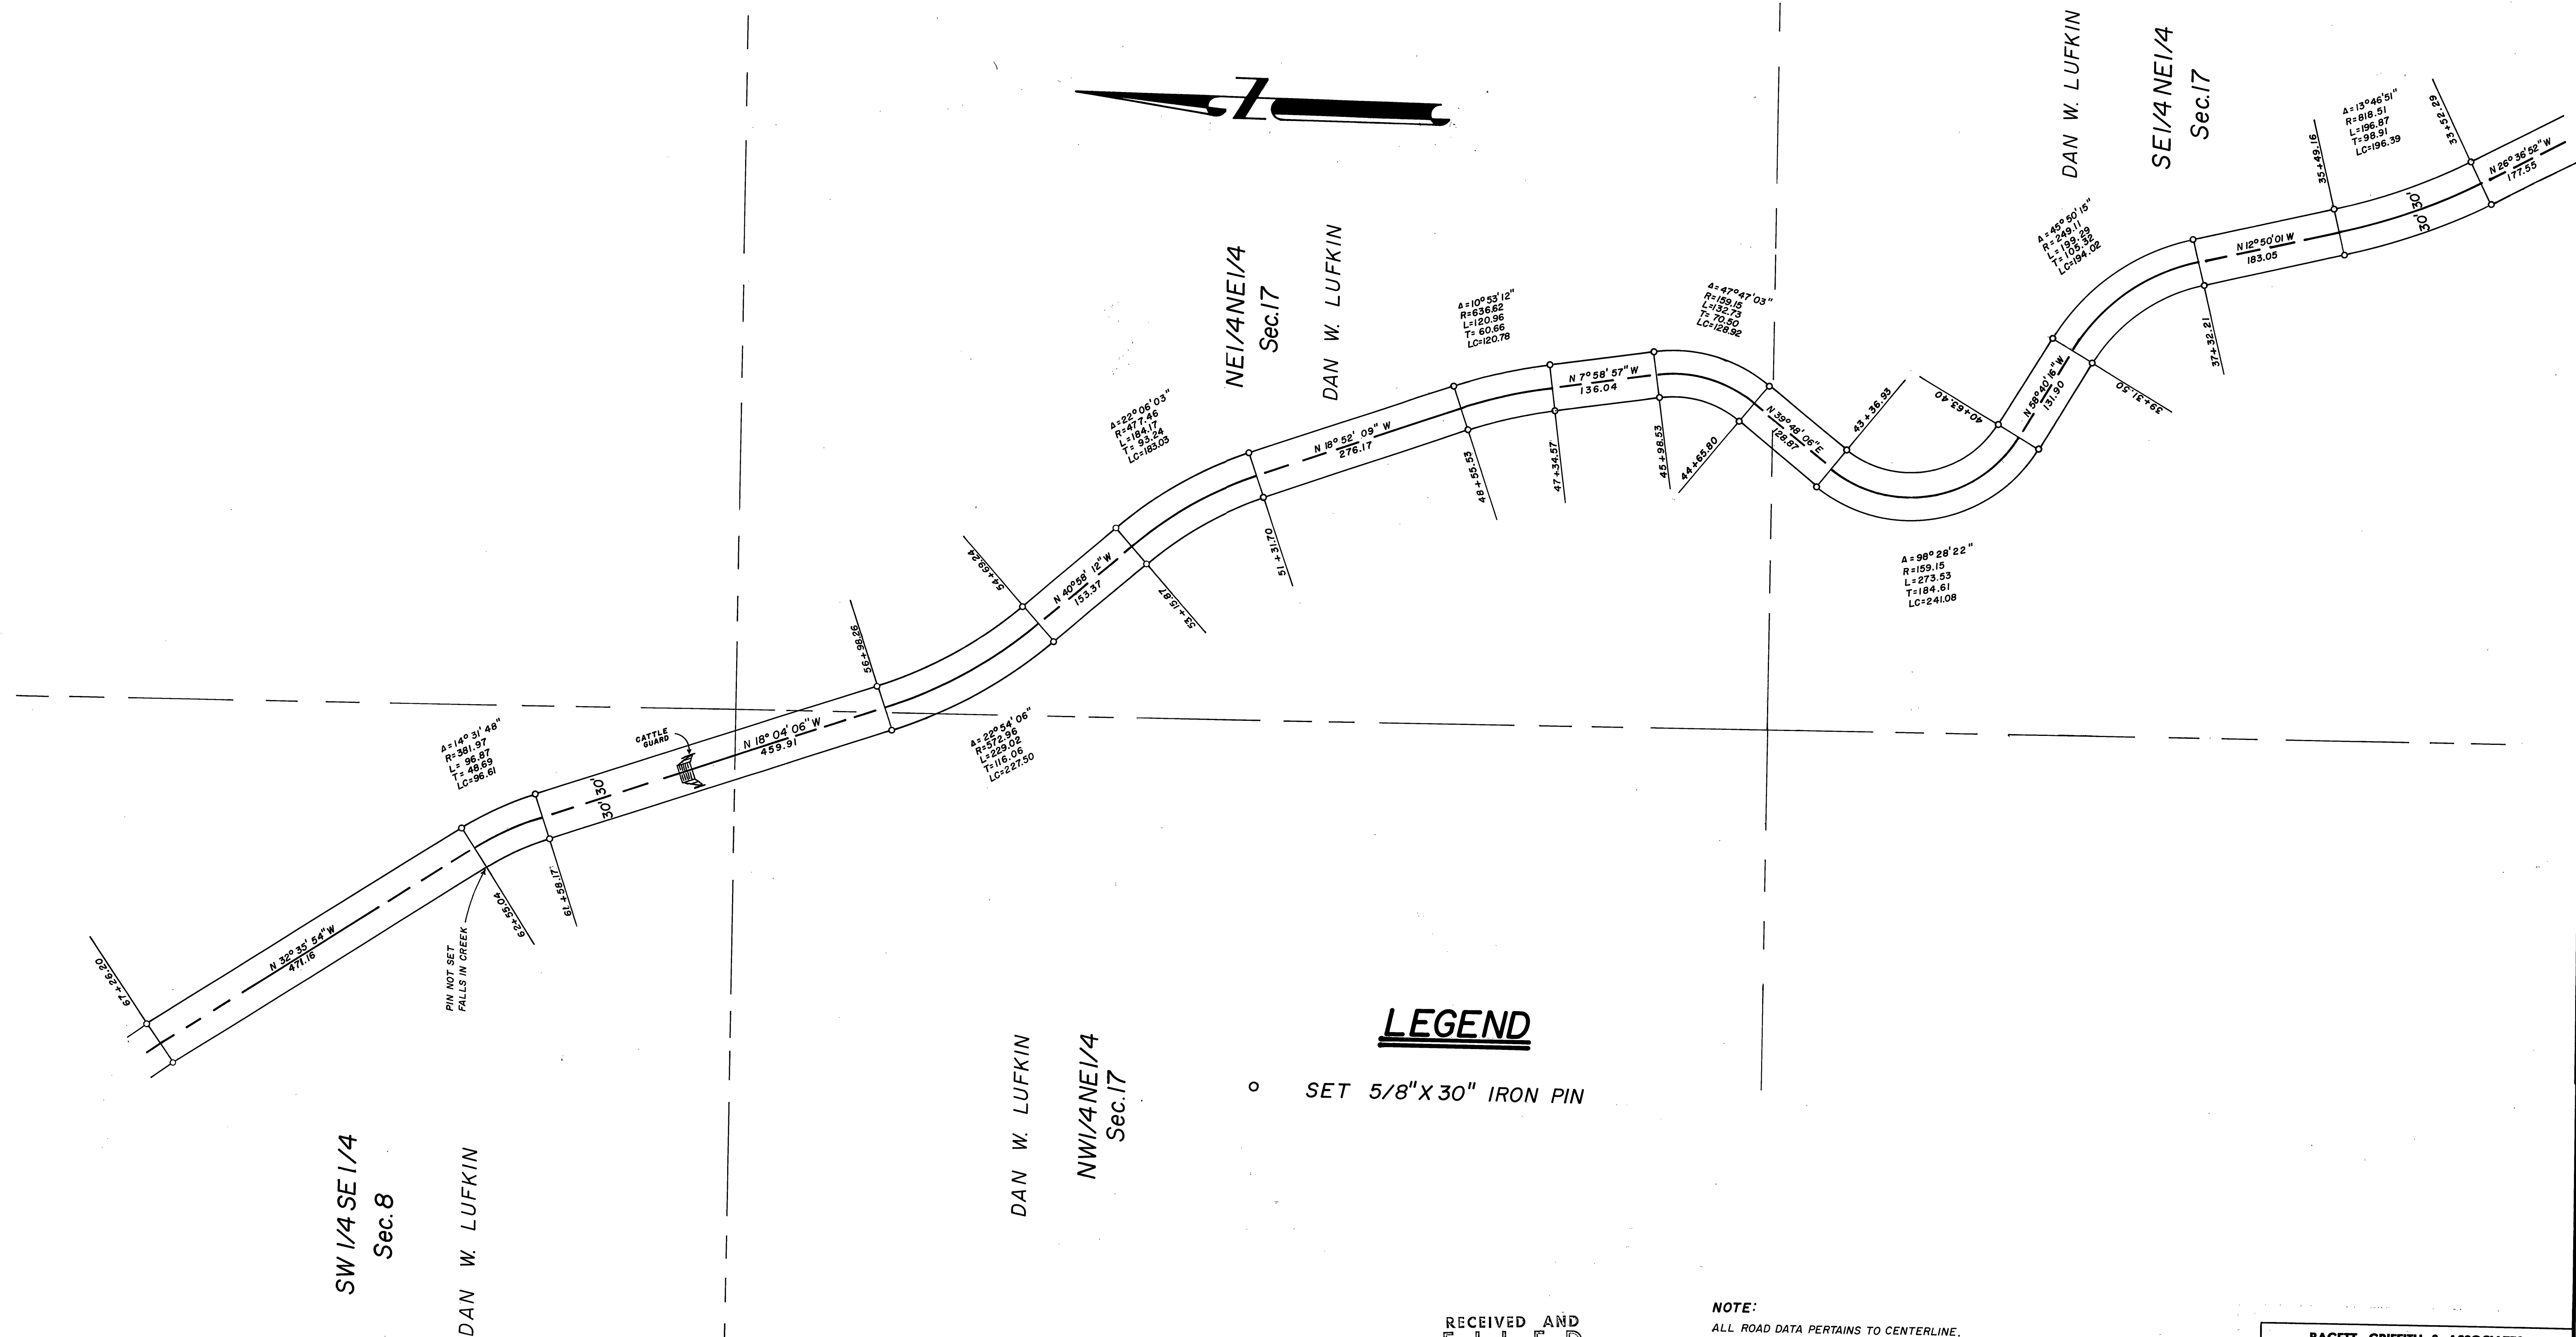

LEGEND

○ SET 5/8" X 30" IRON PIN

RECEIVED AND
FILED

JUN 24 1977

JOHN LIVEIRA, County Clerk
By *Robert D. Bagett* Deputy

NOTE:

ALL ROAD DATA PERTAINS TO CENTERLINE.

THE CENTERLINE SHOWN GENERALLY FOLLOWS
OF EXISTING ROAD.

SEC. LINES & 1/16 LINES ARE PROJECTED FROM
FD. COR. AT THE S.E. COR., SEC. 17

REGISTERED
PROFESSIONAL
LAND SURVEYOR

Robert D. Bagett
OREGON
JULY 12, 1963
ROBERT D. BAGETT
598

BAGETT, GRIFFITH & ASSOCIATES		
John Day, Oregon		
Map of Survey		
COUNTY ROAD NO. 60		
(STRAWBERRY ROAD)		
SEC'S 8 & 17 T.4S., R.34E., W.M.		
GRANT COUNTY, OREGON		
SURVEYED FOR	GRANT COUNTY ROAD DEPT.	
SURVEYED BY	R.D.B. & W.G.	5-1977
Scale: 1"=100'	Drawn by: W.G.	5-1977