


BASIS OF BEARINGS
SOLAR OBSERVATION

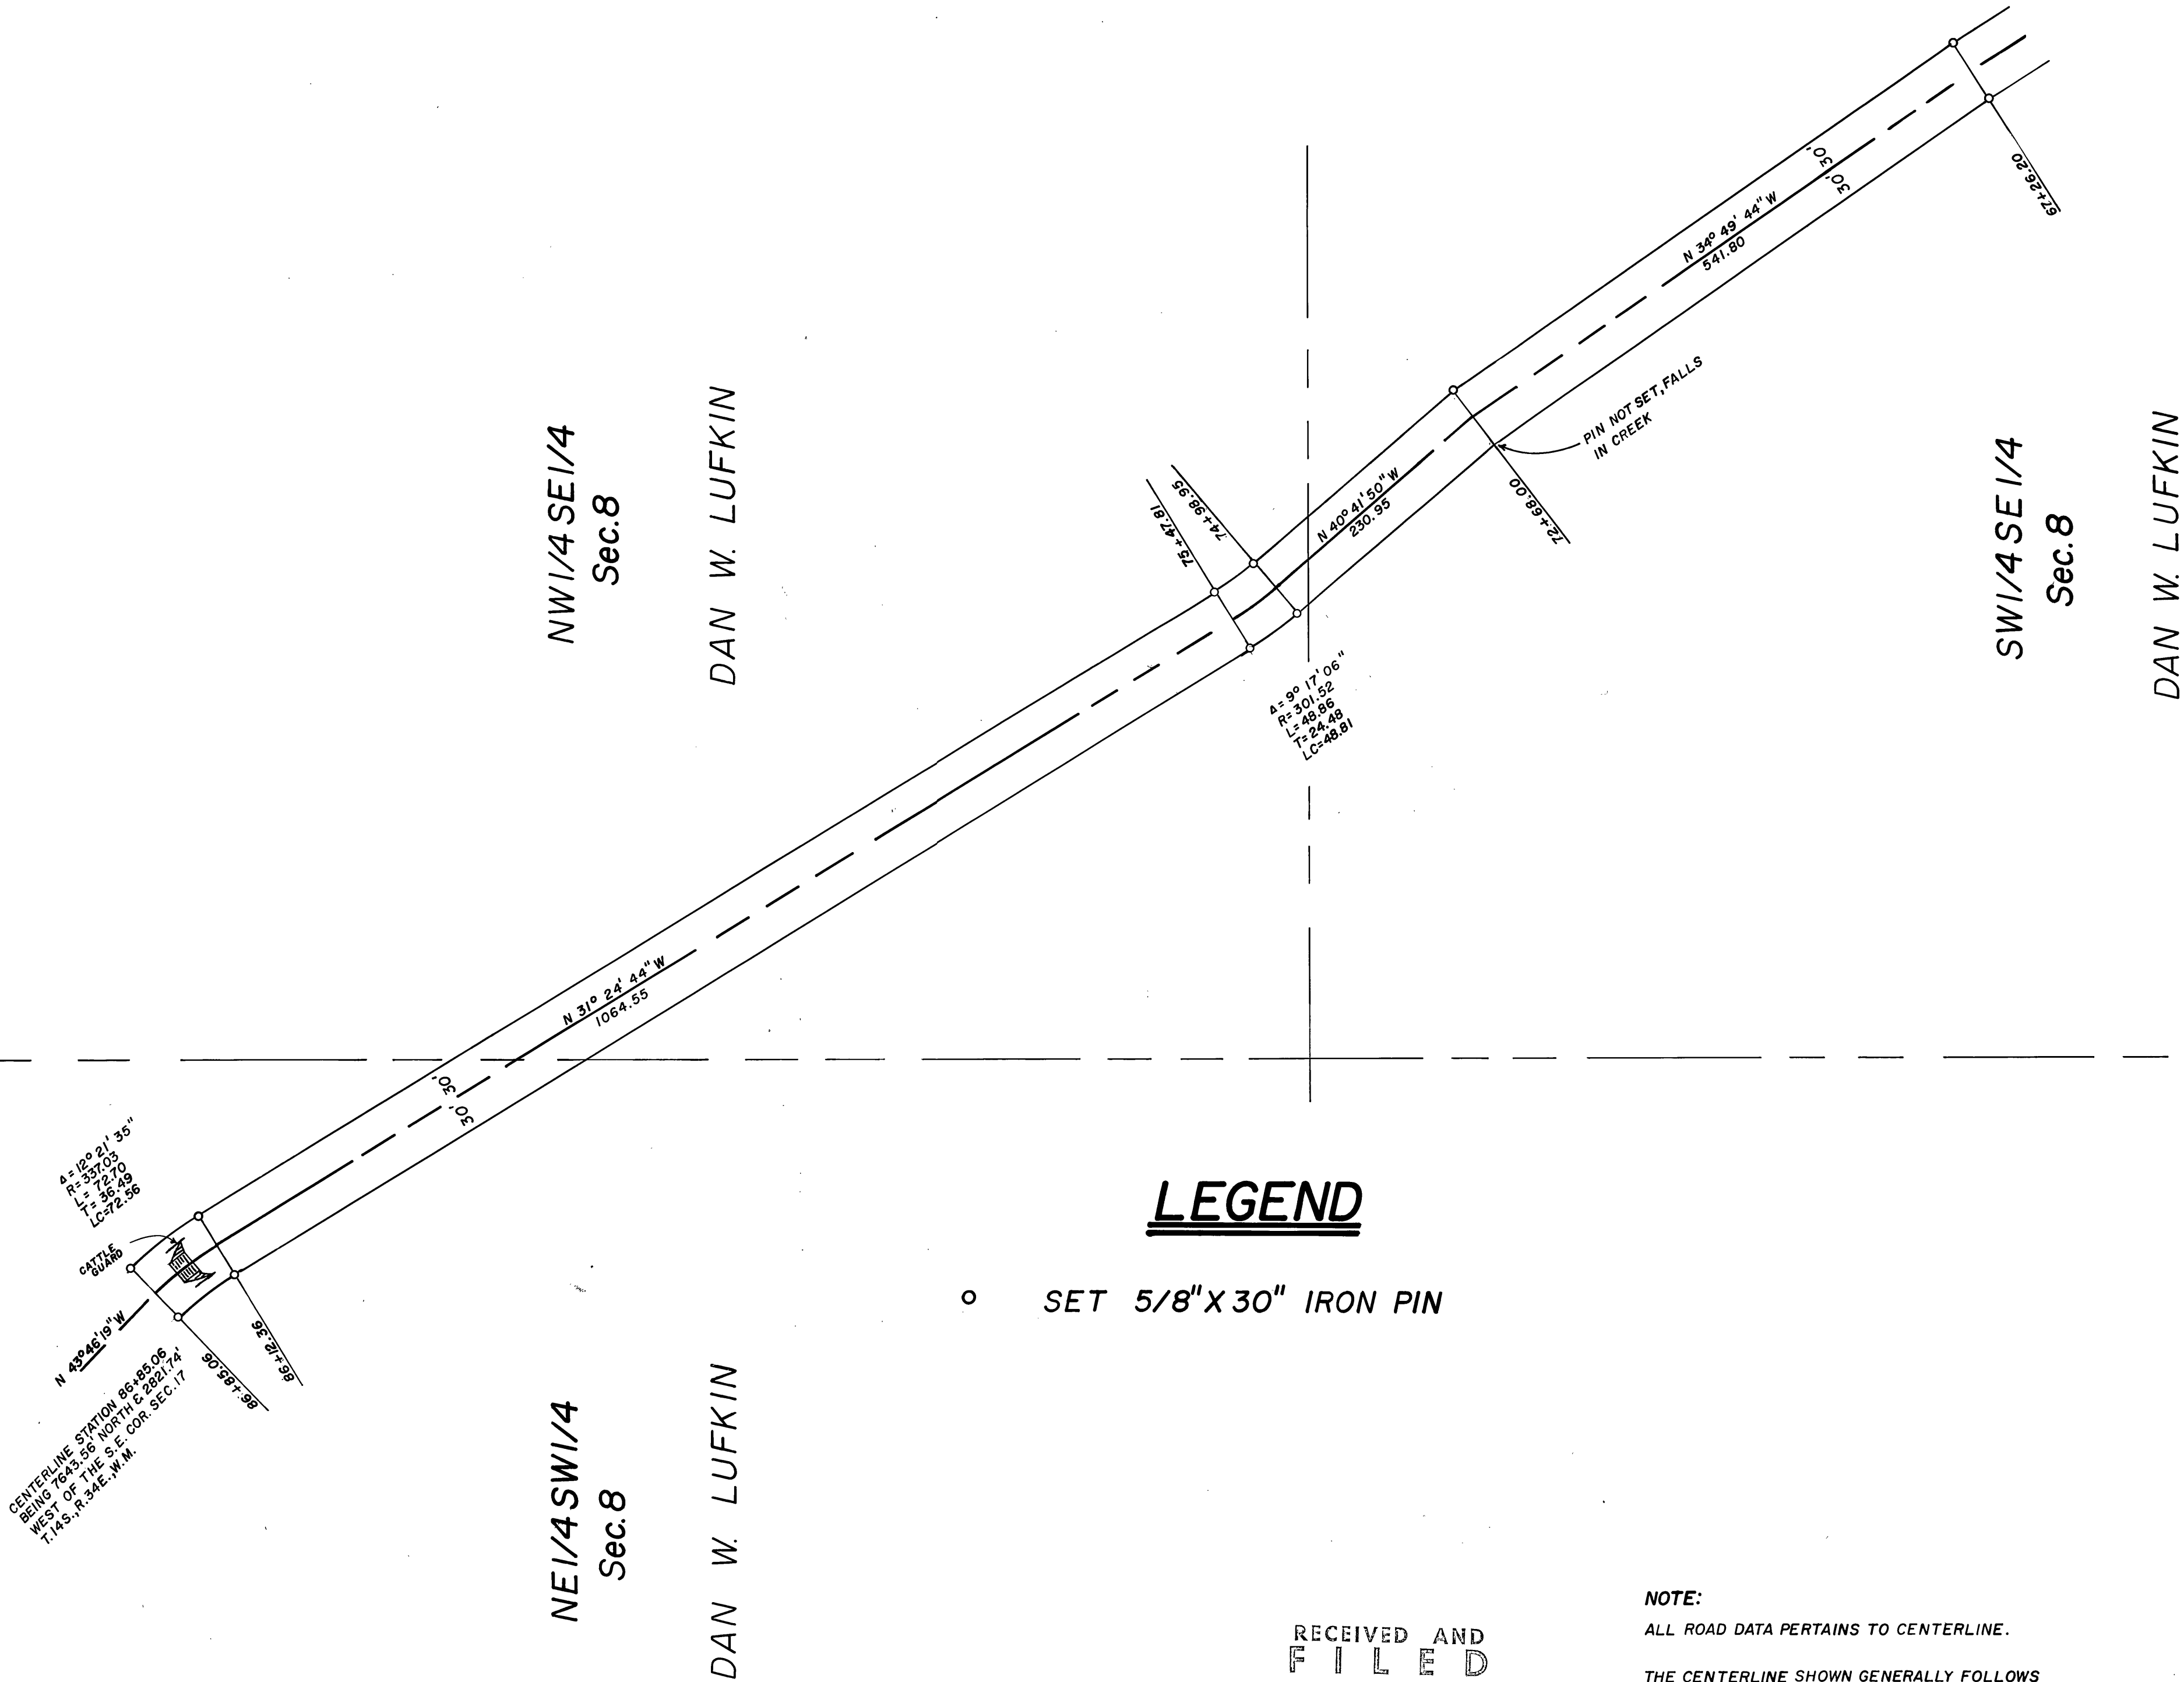

LEGEND

○ SET 5/8" X 30" IRON PIN

NOTE:
ALL ROAD DATA PERTAINS TO CENTERLINE.
THE CENTERLINE SHOWN GENERALLY FOLLOWS
OF EXISTING ROAD.
SEC. LINES & 1/16 LINES ARE PROJECTED FROM
FD. COR. AT THE S.E. COR., SEC. 17

RECEIVED AND
FILED
JUN 24 1977
JOHN VIVEIRA, County Clerk
By *[Signature]* Deputy

REGISTERED
PROFESSIONAL
LAND SURVEYOR
Robert D. Bagett
OREGON
JULY 12, 1963
ROBERT D. BAGETT
598

BAGETT, GRIFFITH & ASSOCIATES John Day, Oregon Map of Survey		
COUNTY ROAD NO. 60 (STRAWBERRY ROAD) SEC. 8, T14S., R. 34E., W. 6. GRANT COUNTY, OREGON		
SURVEYED FOR	GRANT COUNTY ROAD DEPT.	
SURVEYED BY	R.D.B. & W.G.	5-1977
Scale: 1" = 100'	Drawn by: W.G.	5-1977