


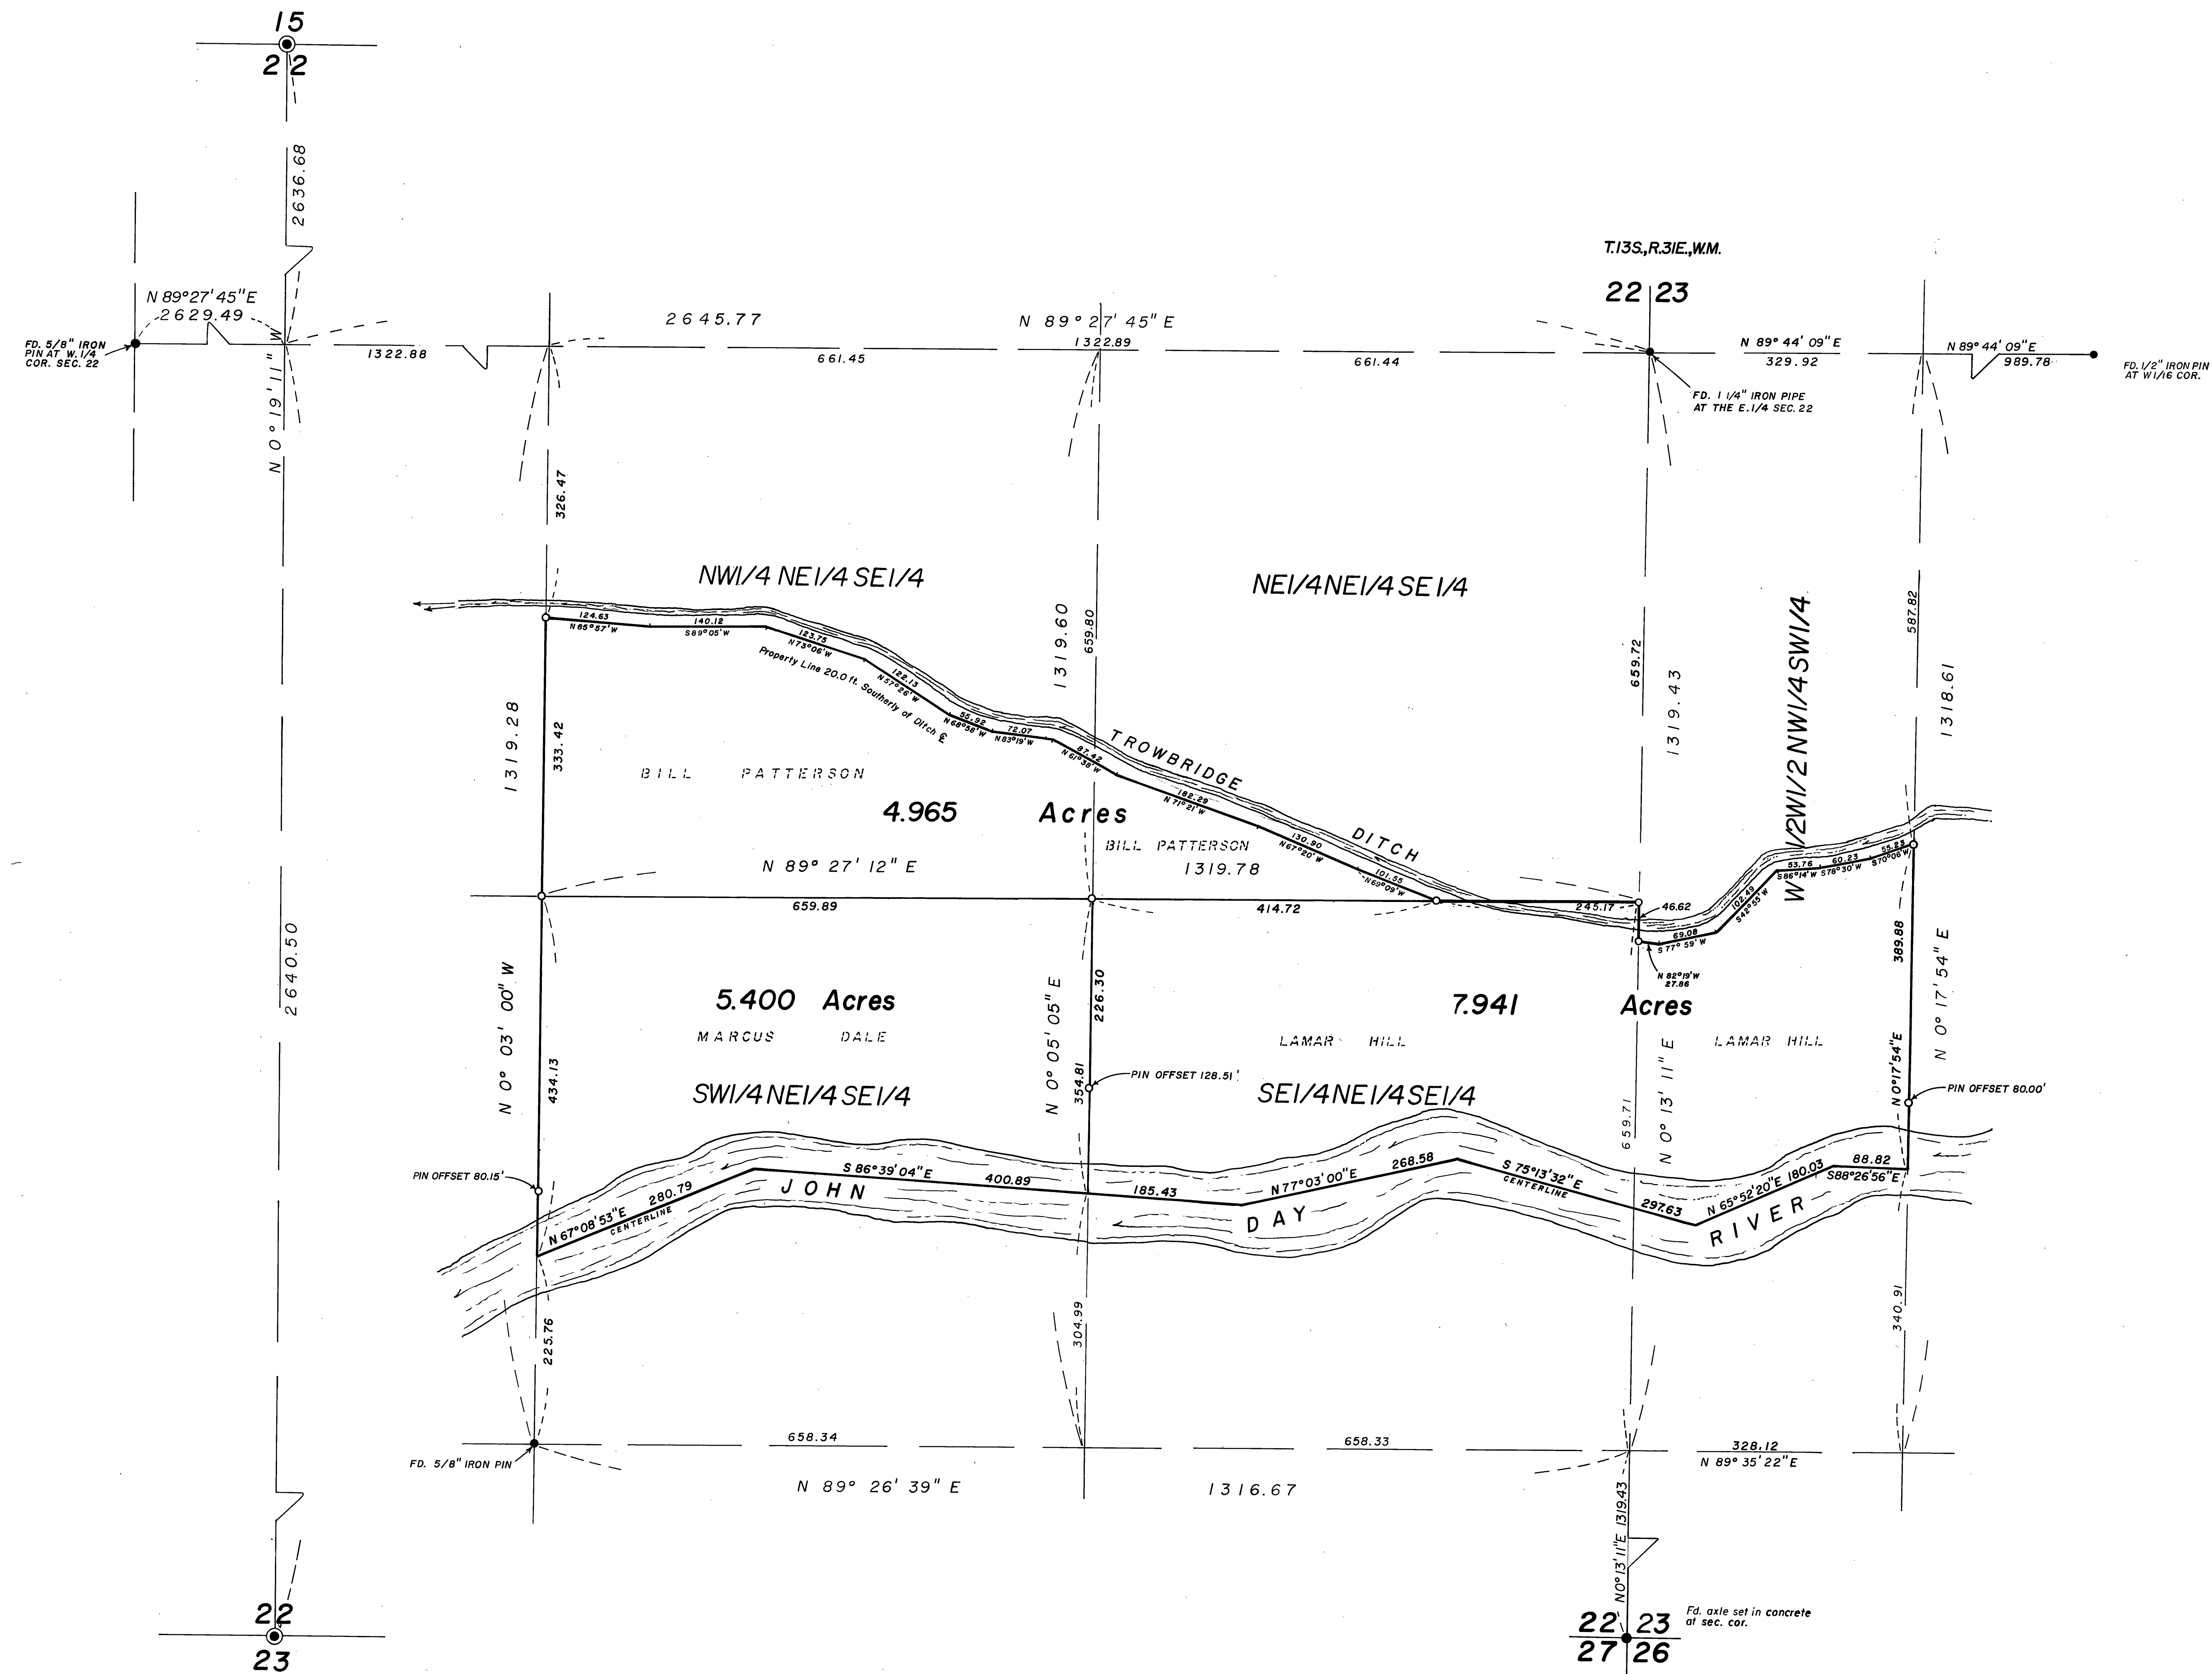

BASIS OF BEARINGS
SOLAR OBSERVATION

LEGEND

- FOUND BRASS CAP
- FOUND MONUMENT OF RECORD
- SET 5/8" X 30" IRON PIN

REFERENCES:
MAPS OF SURVEY NO'S. 111 & 179 & 324.

REGISTERED
PROFESSIONAL
LAND SURVEYOR
Robert D. Baggett
OREGON
JULY 12, 1963
ROBERT D. BAGGETT
588

RECEIVED AND
FILED
AUG 2 1977
JOHN LIVEIRA, County Clerk
By *Robert D. Baggett* Deputy

BAGETT, GRIFFITH & ASSOCIATES John Day, Oregon Map of Survey		
TRACT IN THE NE1/4SE1/4 SEC. 22 & IN THE NW1/2 NW1/4SW1/4 SEC. 23, T13S., R.31E., W. M.		
GRANT COUNTY, OREGON		
SURVEYED FOR	CITY OF JOHN DAY	
SURVEYED BY	R. D. B. & W. G.	5-77-6-77
Scale: 1" = 100'	Drawn by: W. G.	6-1977