


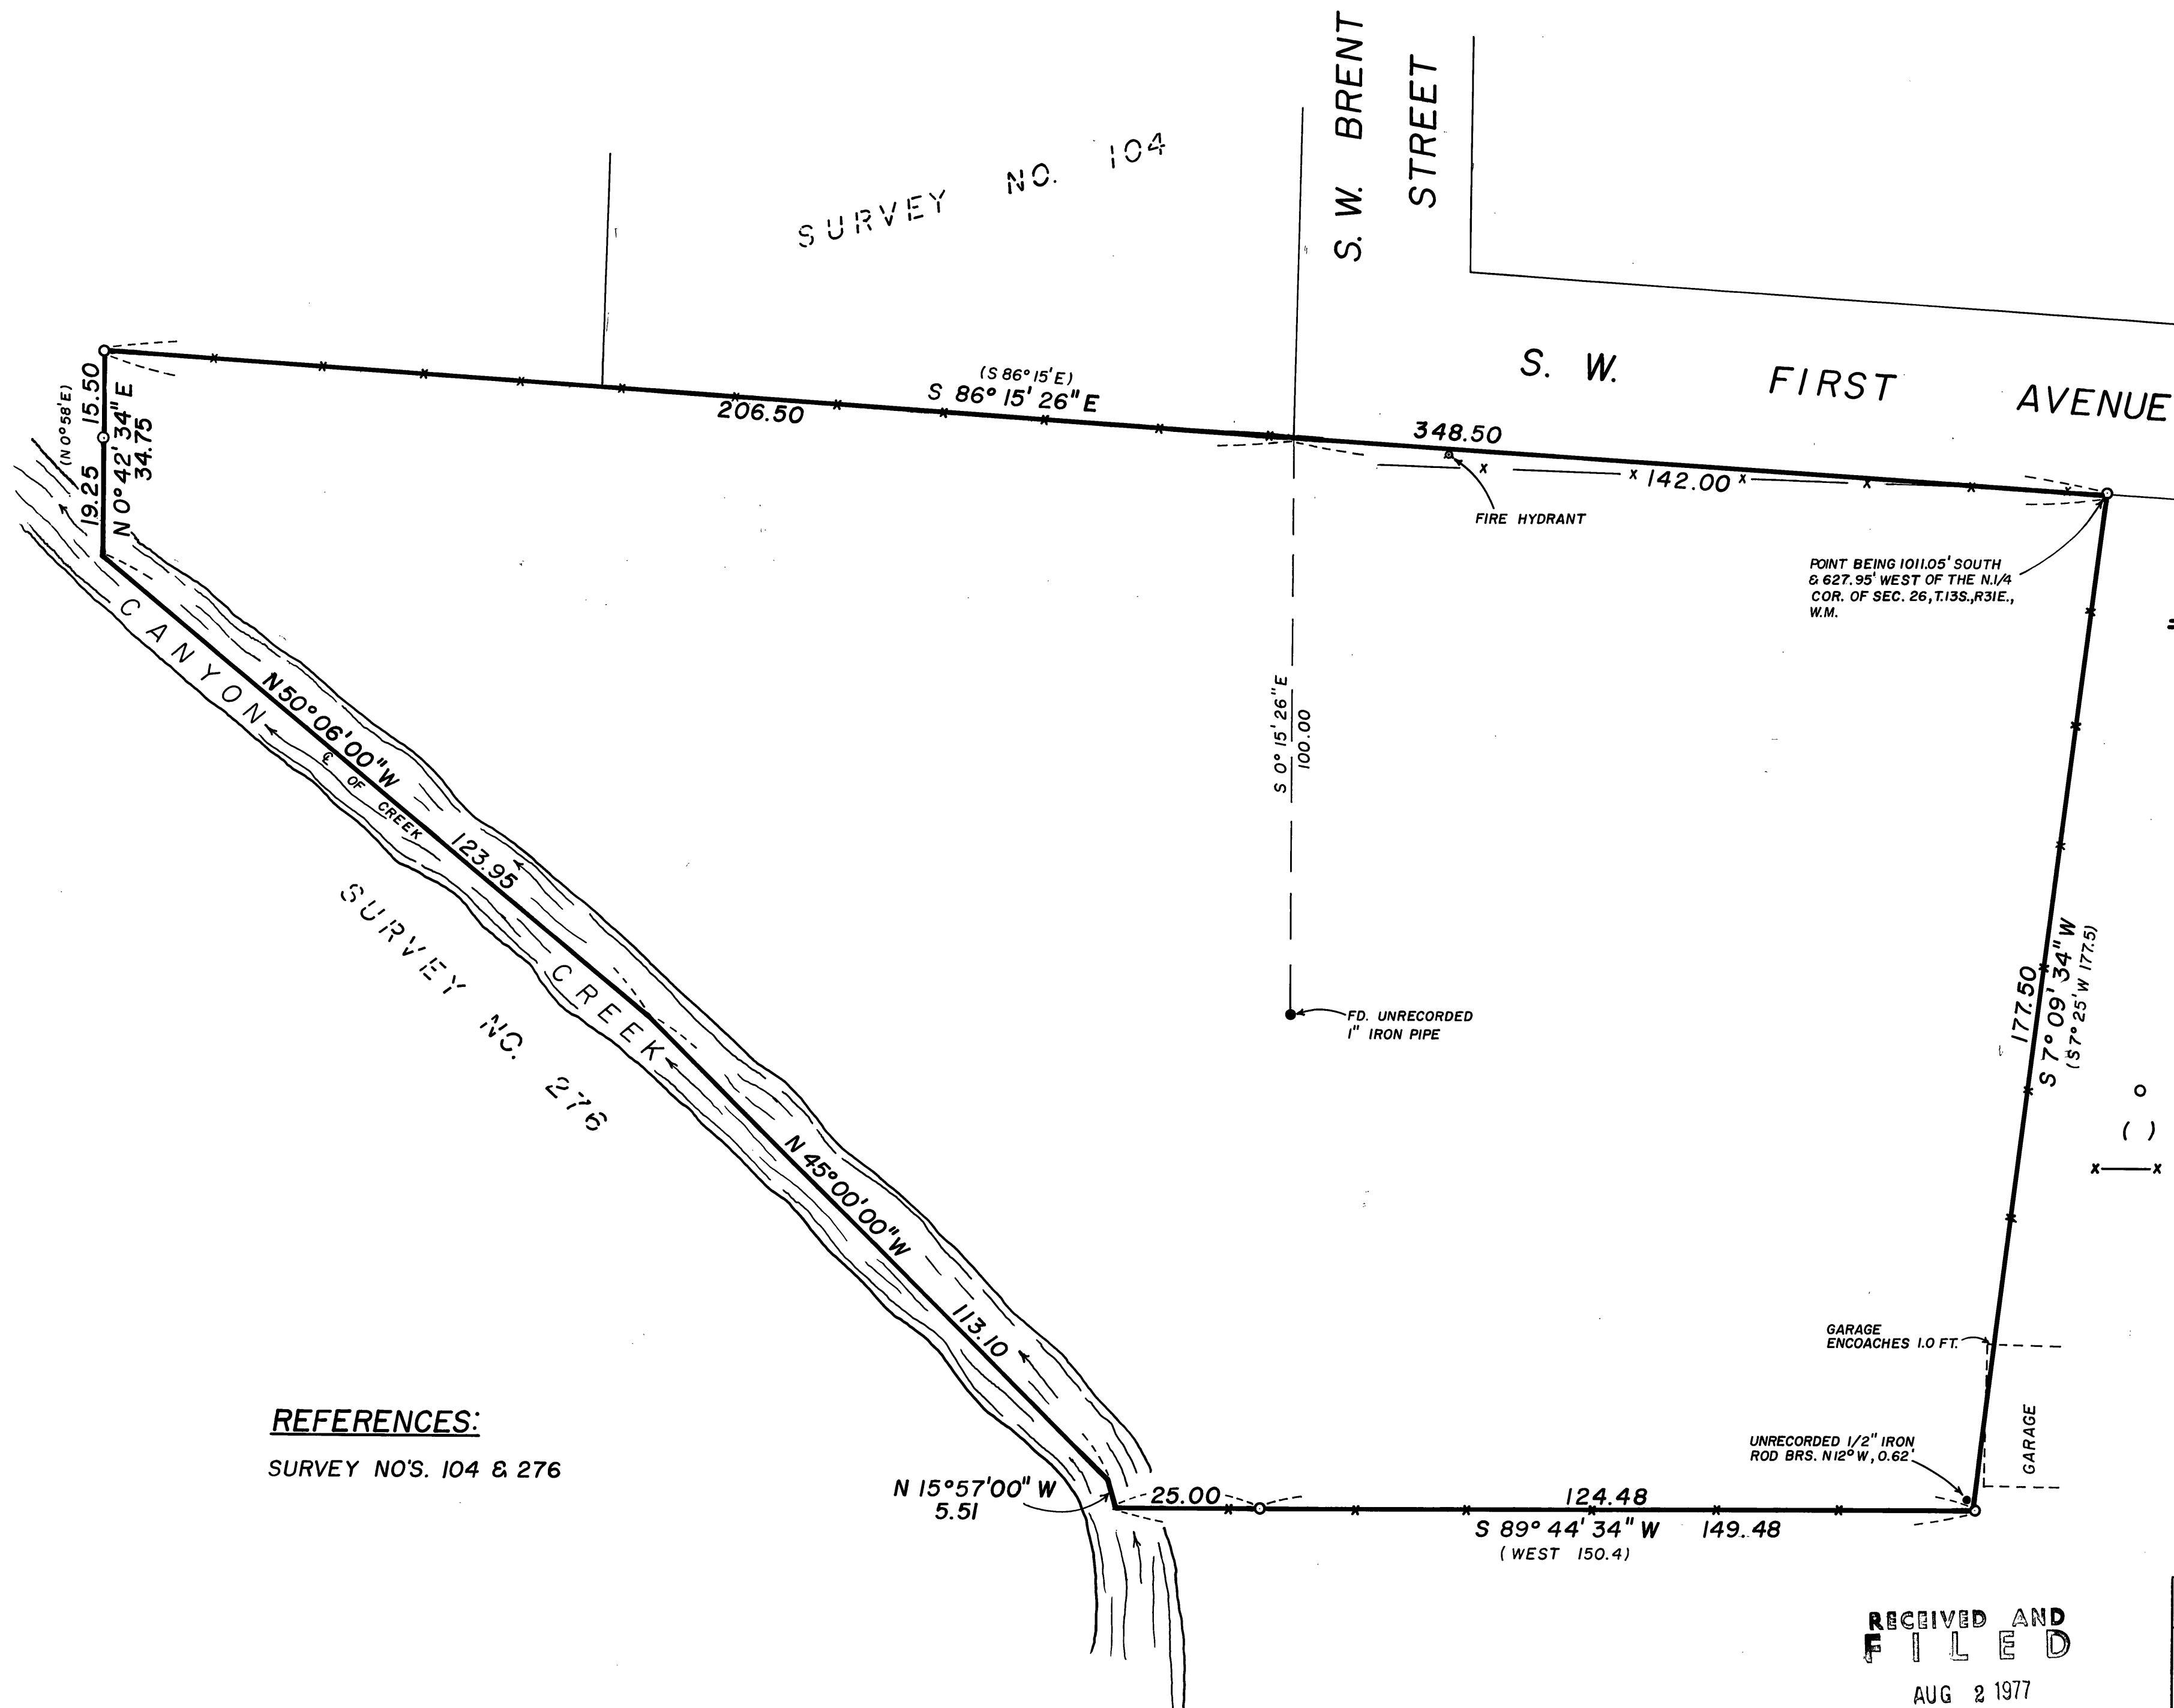

BASIS OF BEARINGS
SOLAR OBSERVATION

LEGEND

- SET 5/8" X 30" IRON PIN
- () RECORD BEARING & DISTANCE
- x—x FENCE

REFERENCES:

SURVEY NO'S. 104 & 276

REGISTERED
PROFESSIONAL
LAND SURVEYOR

Robert D. Baggett
OREGON
JULY 12, 1969
ROBERT D. BAGGETT
598

RECEIVED AND
FILED

AUG 2 1977

JOHN LIVEIRA, County Clerk
Barbara L. Lemoine
Deputy

BAGETT, GRIFFITH & ASSOCIATES John Day, Oregon Map of Survey		
TRACT IN THE NE1/4NW1/4 OF SEC. 26, T.13S., R.31E., W.M. JOHN DAY GRANT COUNTY, OREGON		
SURVEYED FOR	RAWLINS & REX	
SURVEYED BY	R.D.B. & W.G.	6-77
Scale: 1"=20'	Drawn by: W.G.	6-77