




LEGEND

- o Set 5/8" x 30" Iron pin
- X- Fence

REFERENCE MATERIAL

O.S.H.D. DRAWING NO. 4B-26-9
SURVEY NO. 385

BASIS OF BEARINGS
SURVEY NO. 98

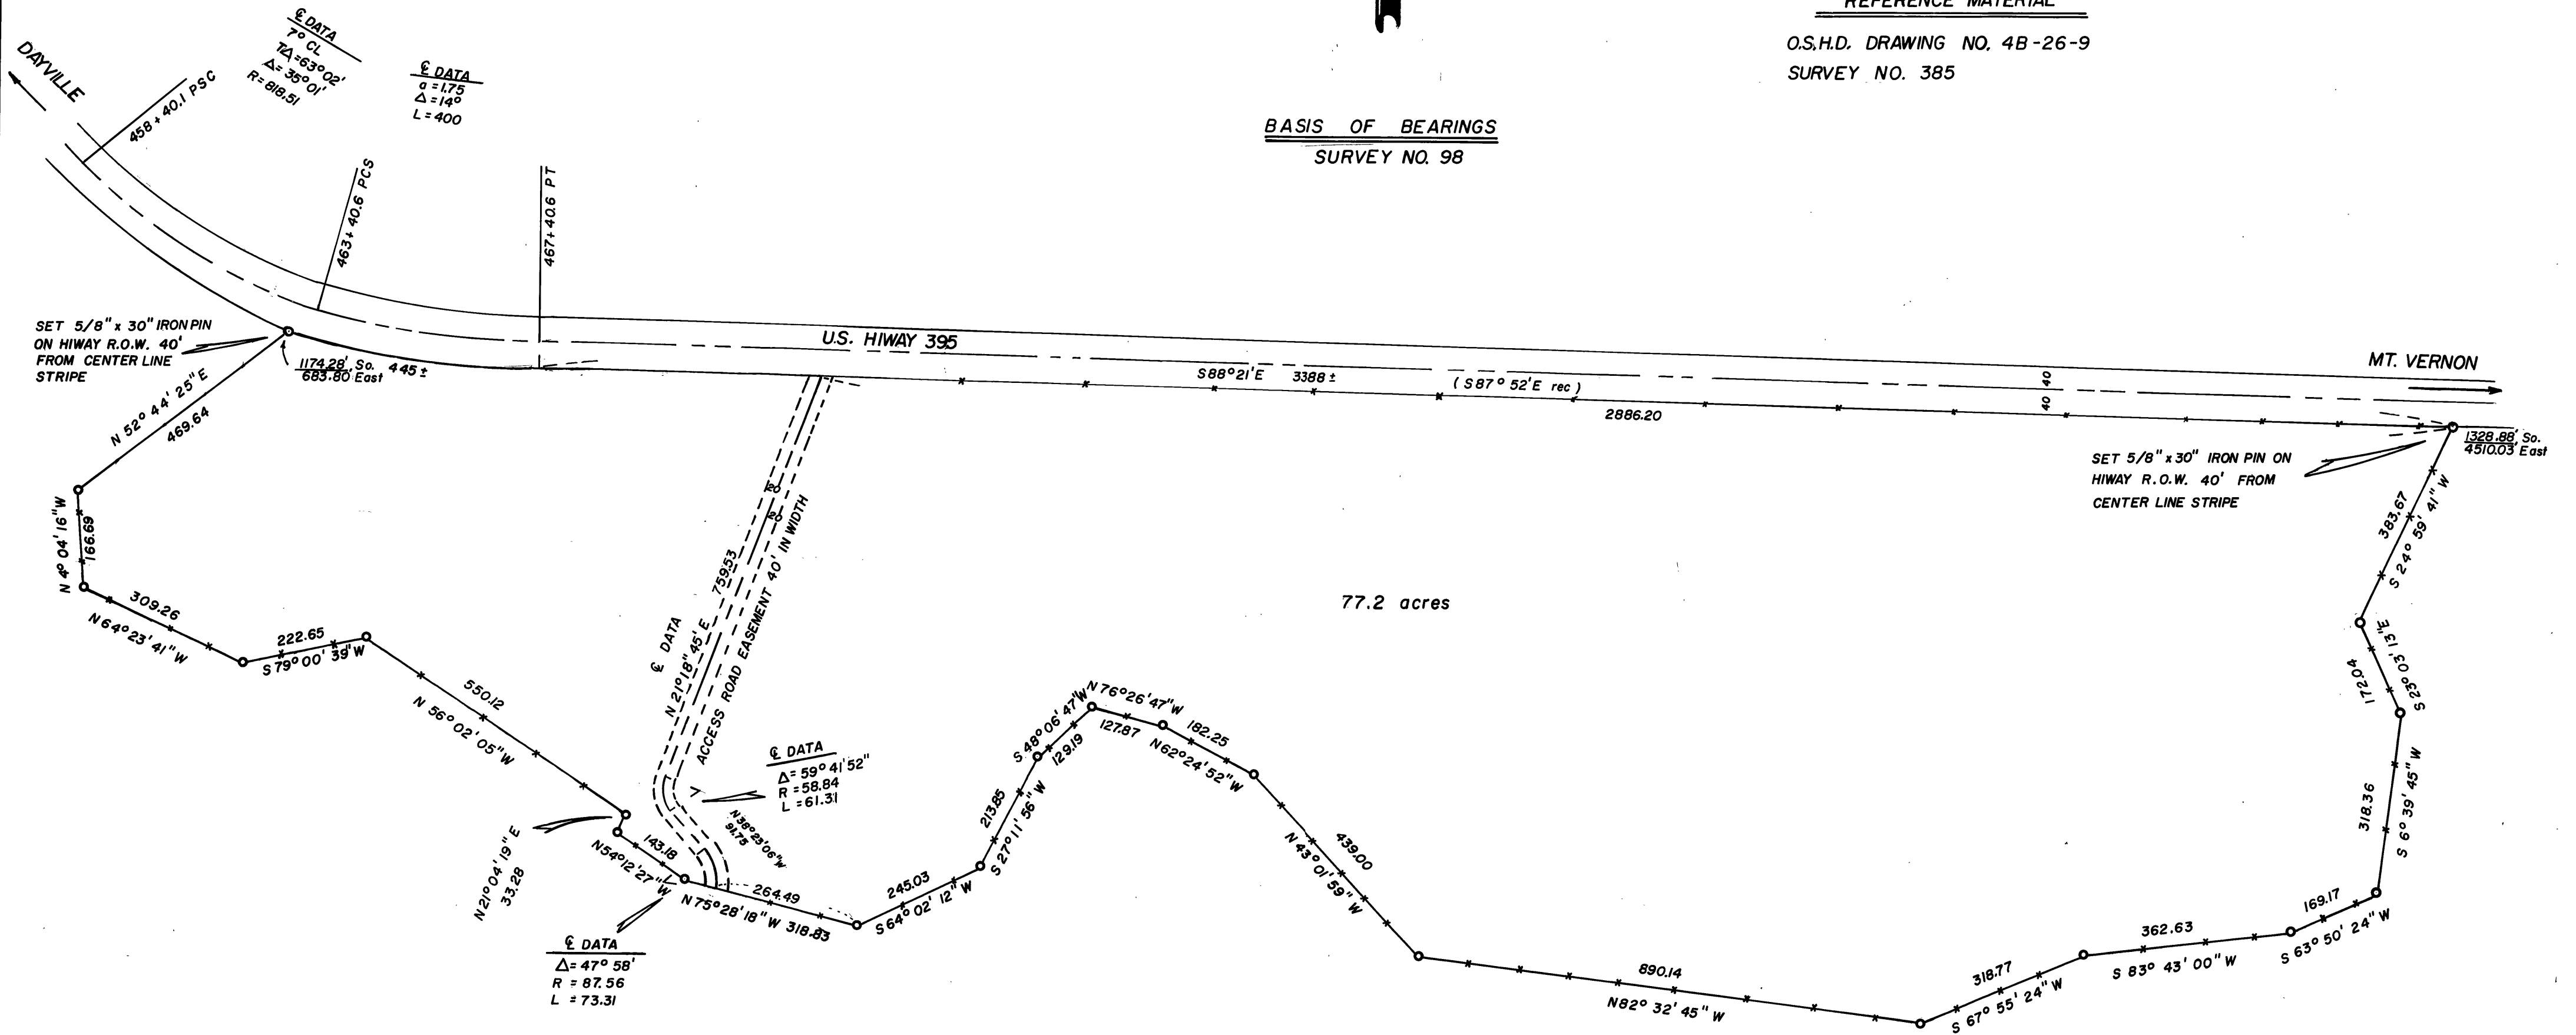

NOTE: Coordinates refer to NW Cor. Sec. 11
which is marked with a brass capped
iron pipe.

RECEIVED AND
FILED

OCT 19 1977
JOHN LIVEIRA, County Clerk
Deputy

REGISTERED
PROFESSIONAL
LAND SURVEYOR

ROBERT D. BAGETT
598

BAGETT, GRIFFITH & ASSOCIATES

John Day, Oregon
Map of Survey

A TRACT OF LAND SITUATED IN
THE N 1/2 SEC. 11 T13S R27E W.M.

GRANT COUNTY, OREGON

SURVEYED FOR	OREGON DEPT. OF FISH & WILDLIFE	
SURVEYED BY	R.D.B. & S.L.C.	8-77
Scale: 1"=200	Drawn by: S.L.C.	8-77