

11 12
14 13

12 7
13 18

Fd. brass cap monument



BASIS OF BEARINGS
SOLAR OBSERVATION

LEGEND

- - SET 5/8"x 30" Iron pin
- ⊙ - Fd. brass cap mon.

REGISTERED
PROFESSIONAL
LAND SURVEYOR

Robert D. Baggett


OREGON
JULY 12, 1963
ROBERT D. BAGGETT
598

13 18

24 19

14 13

23 24

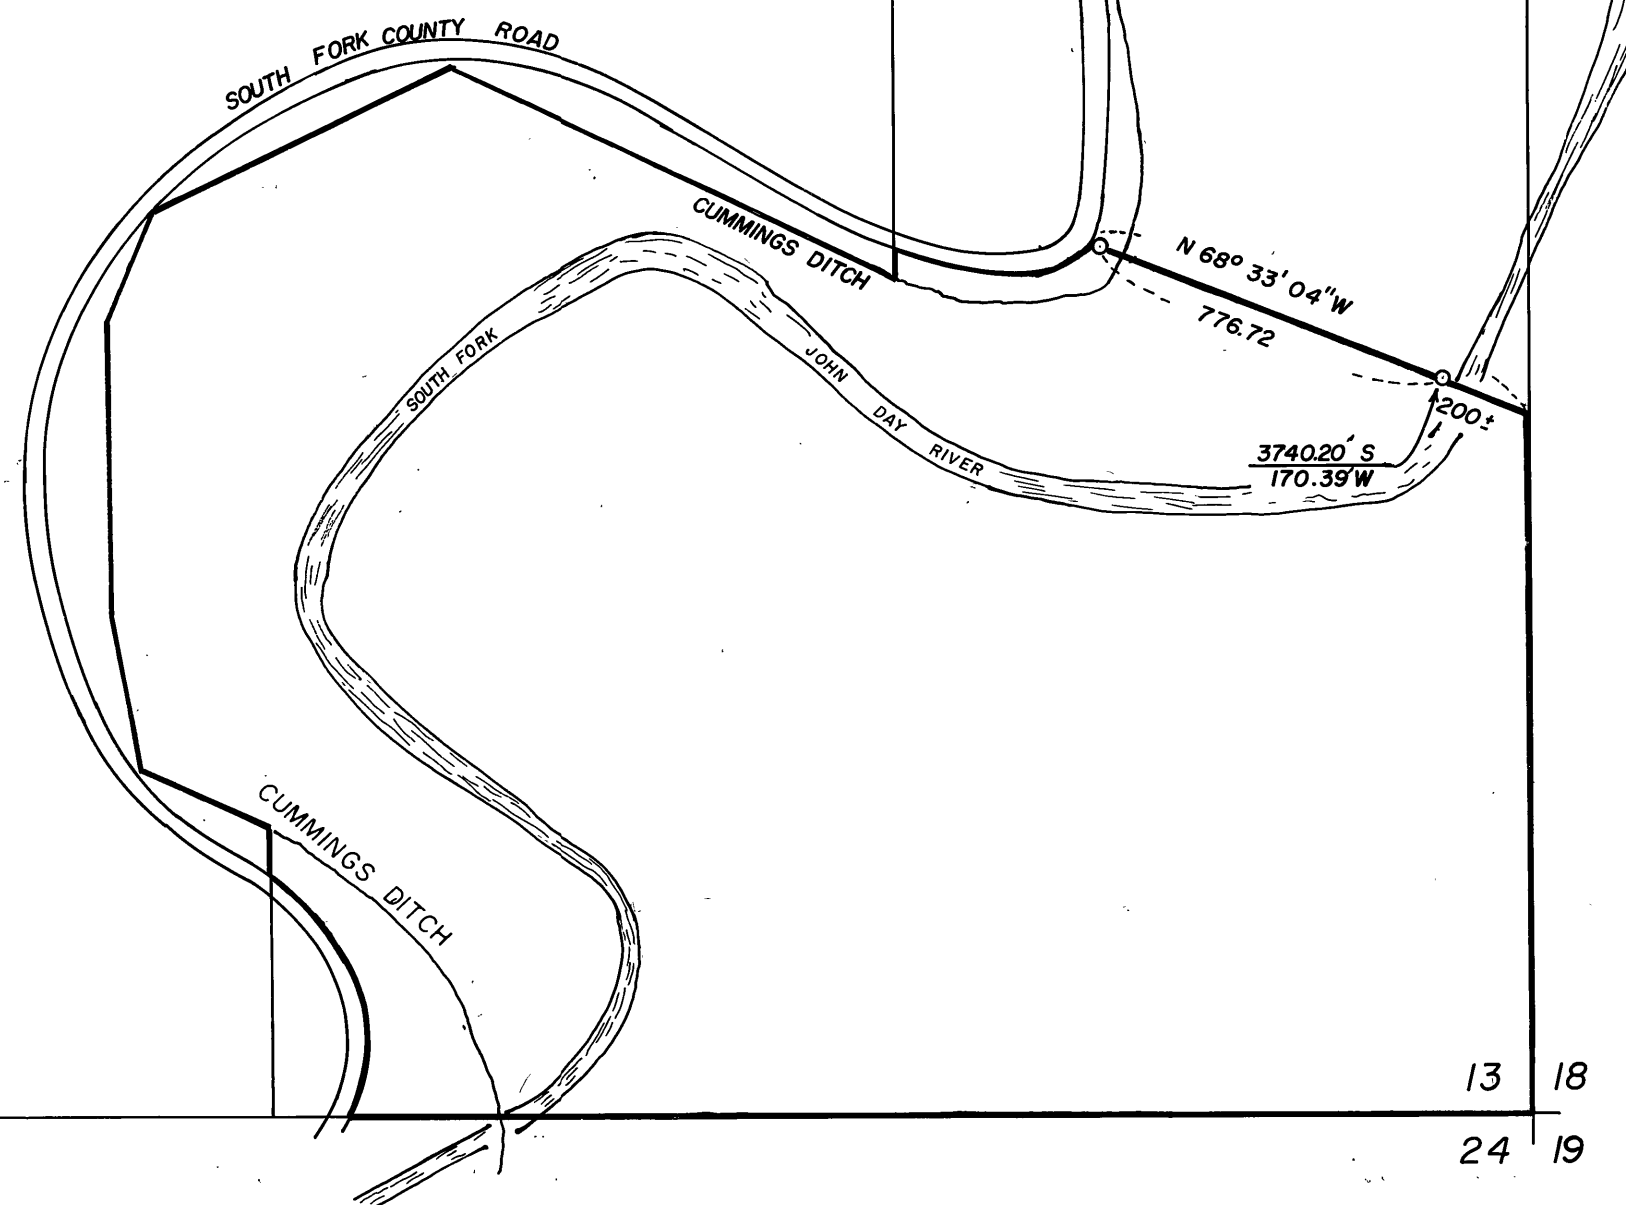

NOTE: Coordinates refer to the
N.E. cor. sec. 13.

RECEIVED AND
FILED

OCT 19 1977
John Liveira
JOHN LIVEIRA, County Clerk
By _____ Deputy

BAGETT, GRIFFITH & ASSOCIATES

John Day, Oregon
Map of Survey

LINE IN THE NE 1/4 SE 1/4 SEC. 13,
T13S, R26E, W.M.

GRANT COUNTY, OREGON

SURVEYED FOR	OREGON DEPT. OF FISH & WILDLIFE	
SURVEYED BY	R.D.B - S.L.C.	8-77
Scale: 1"= 400'	Drawn by: S.L.C.	8-77