


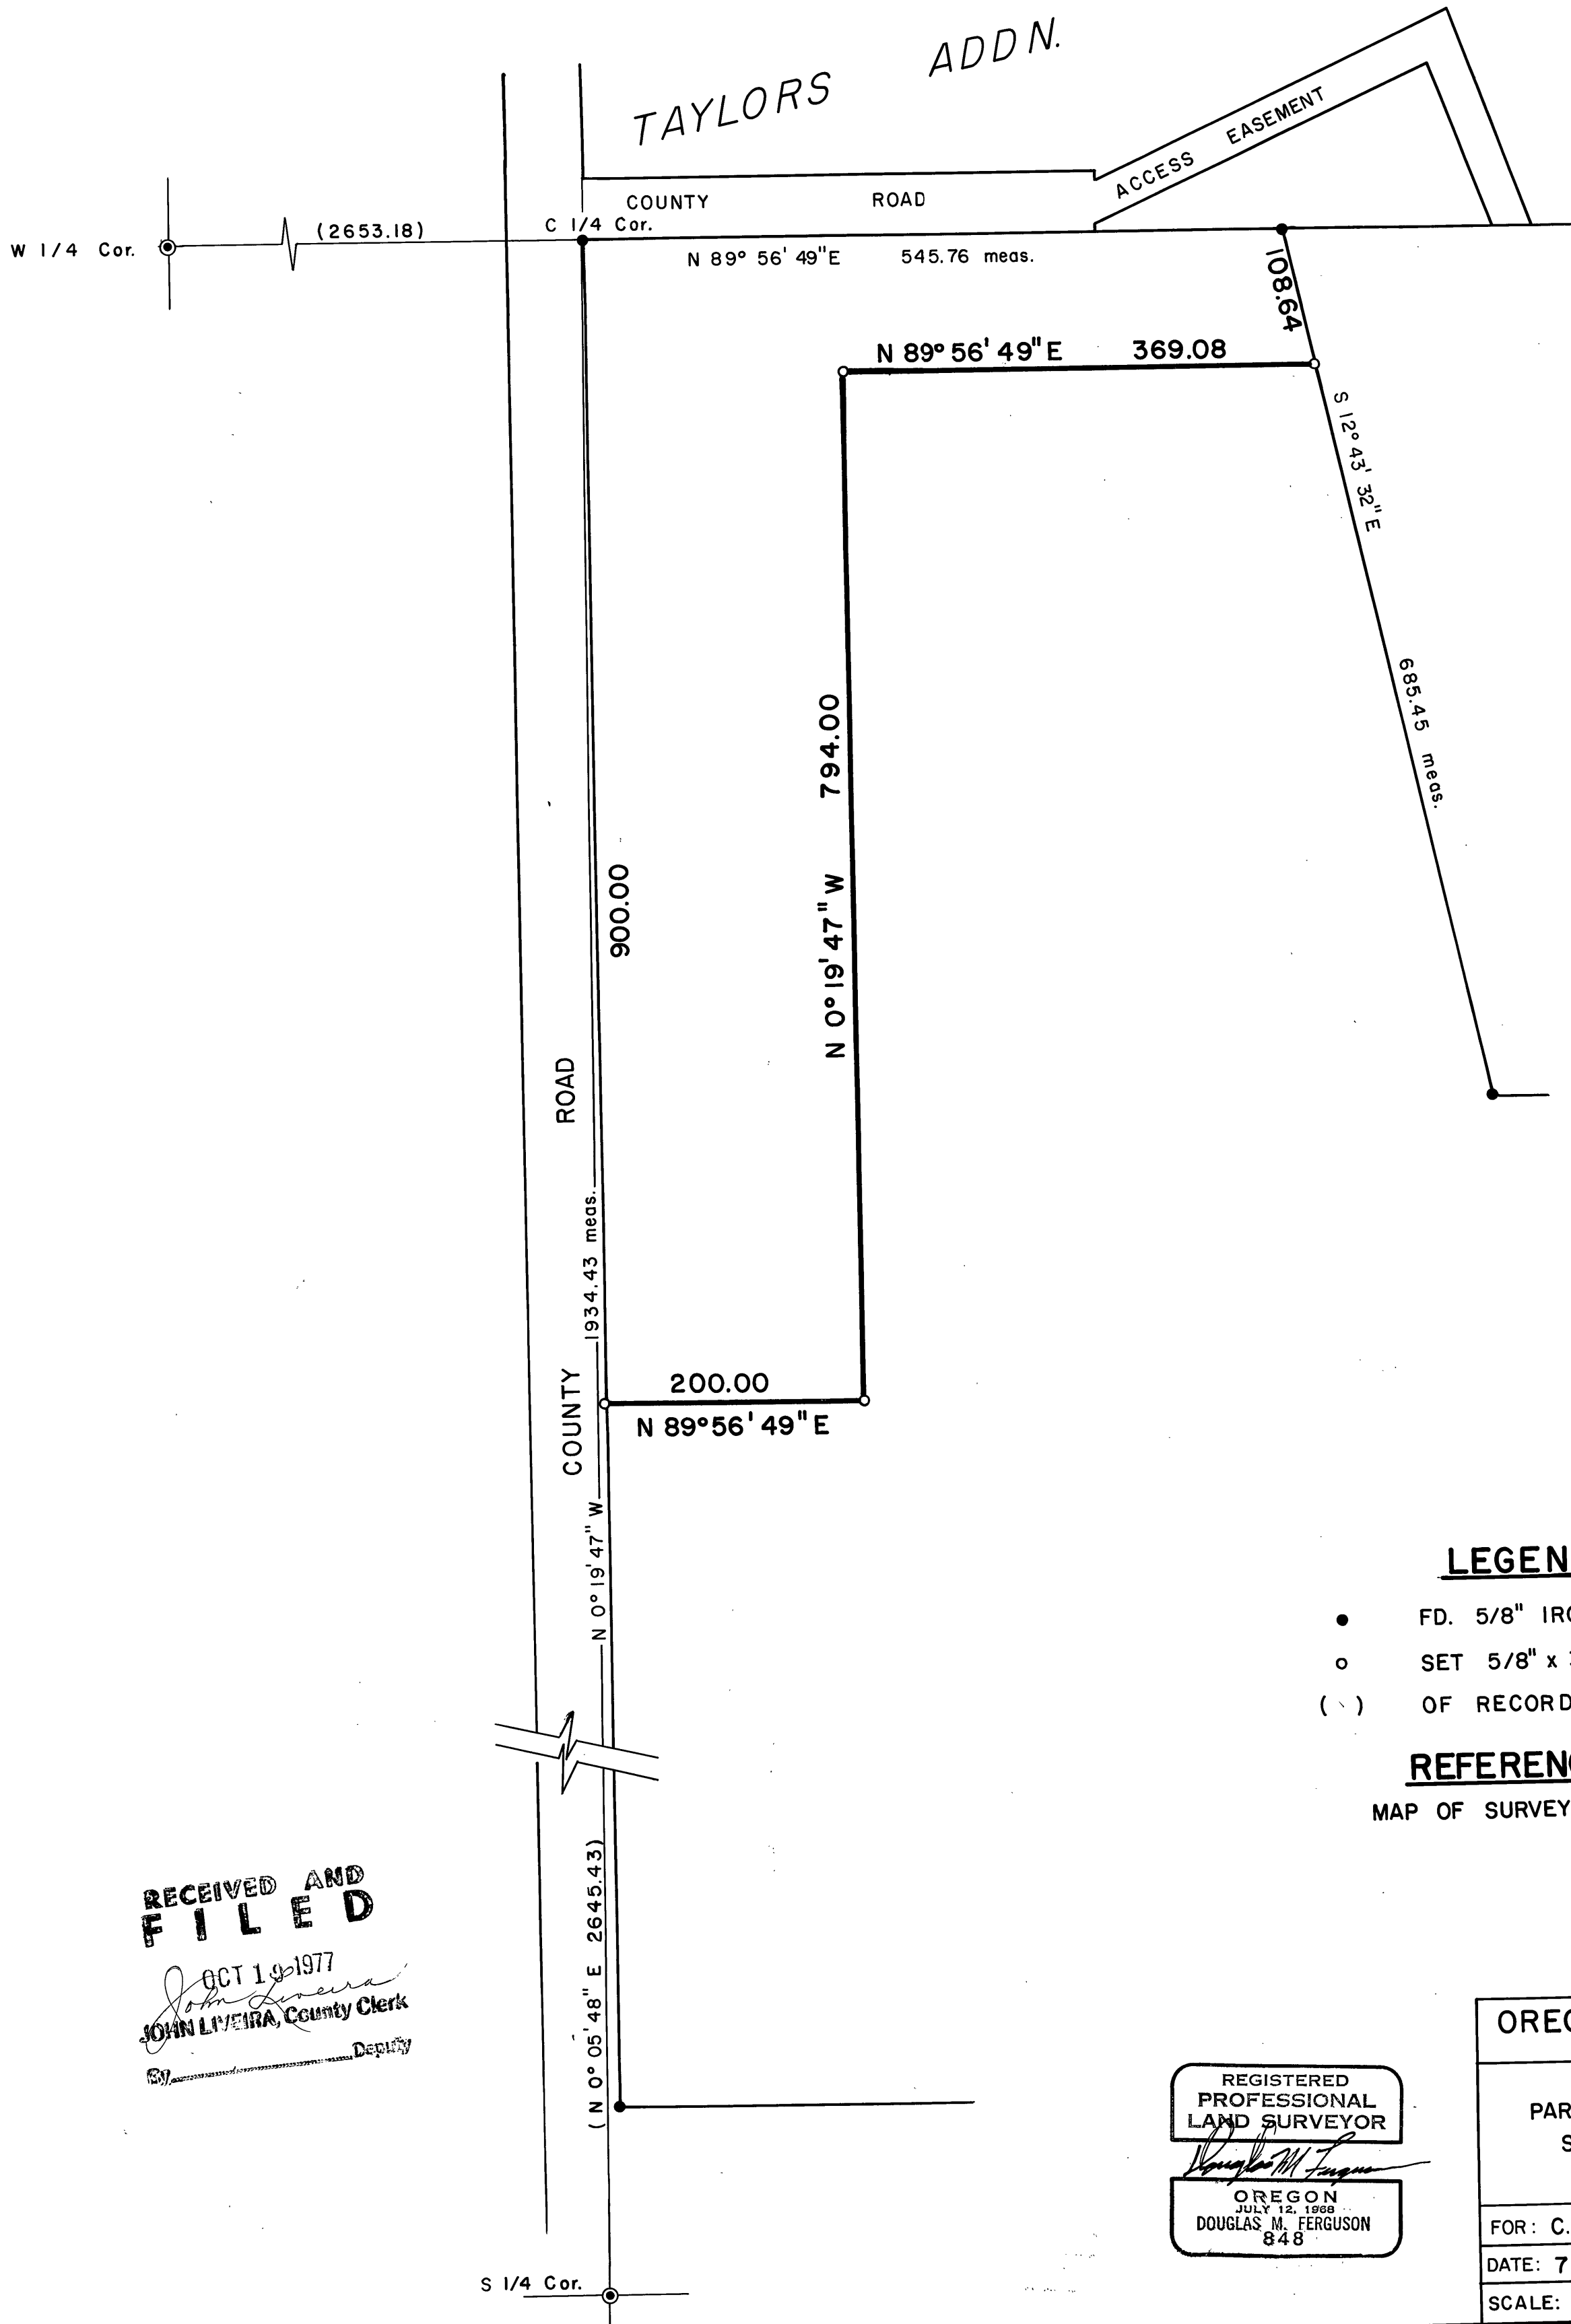

BASIS OF BEARINGS
MAP OF SURVEY NO. 422

LEGEND

- FD. 5/8" IRON PIN
- o SET 5/8" x 30" IRON PIN
- () OF RECORD

REFERENCES

MAP OF SURVEY NO. 422

RECEIVED AND
FILED
OCT 19 1977
JOHN L. LIVERA, County Clerk
Deputy

REGISTERED
PROFESSIONAL
LAND SURVEYOR

OREGON
JULY 12, 1968
DOUGLAS M. FERGUSON
848

OREGON EAST ENGINEERING, INC. MT. VERNON, ORE.		
Map of Survey		
PARTITION OF PARCEL SITUATED IN SE 1/4, SEC. 11, T.13S., R.33E., WM.		
GRANT COUNTY, OREGON		
FOR: C. DAVID KLINE	BY: D.M.F. & J.A.L.	
DATE: 7/77	DRAWING NO: B-13	SHEET 1 OF 1
SCALE: 1"= 100'	JOB NO. S-2477	DRAWN BY: J.A.L.

MAP OF SURVEY NO. 466