


Note:
Bearings and distances shown in parentheses are those of record from original survey notes by Charles M. Foster, U.S. deputy mineral surveyor dated October 13, 1892. Other bearings and distances shown are a result of this survey.

Field note book titled Property Line Survey Mineral Surveys No's 258, 258-B, 262-A, 262-B & 273, TBS, R36E, WM. For Wallowa-Whitman National Forest, is in U.S.F.S. custody.

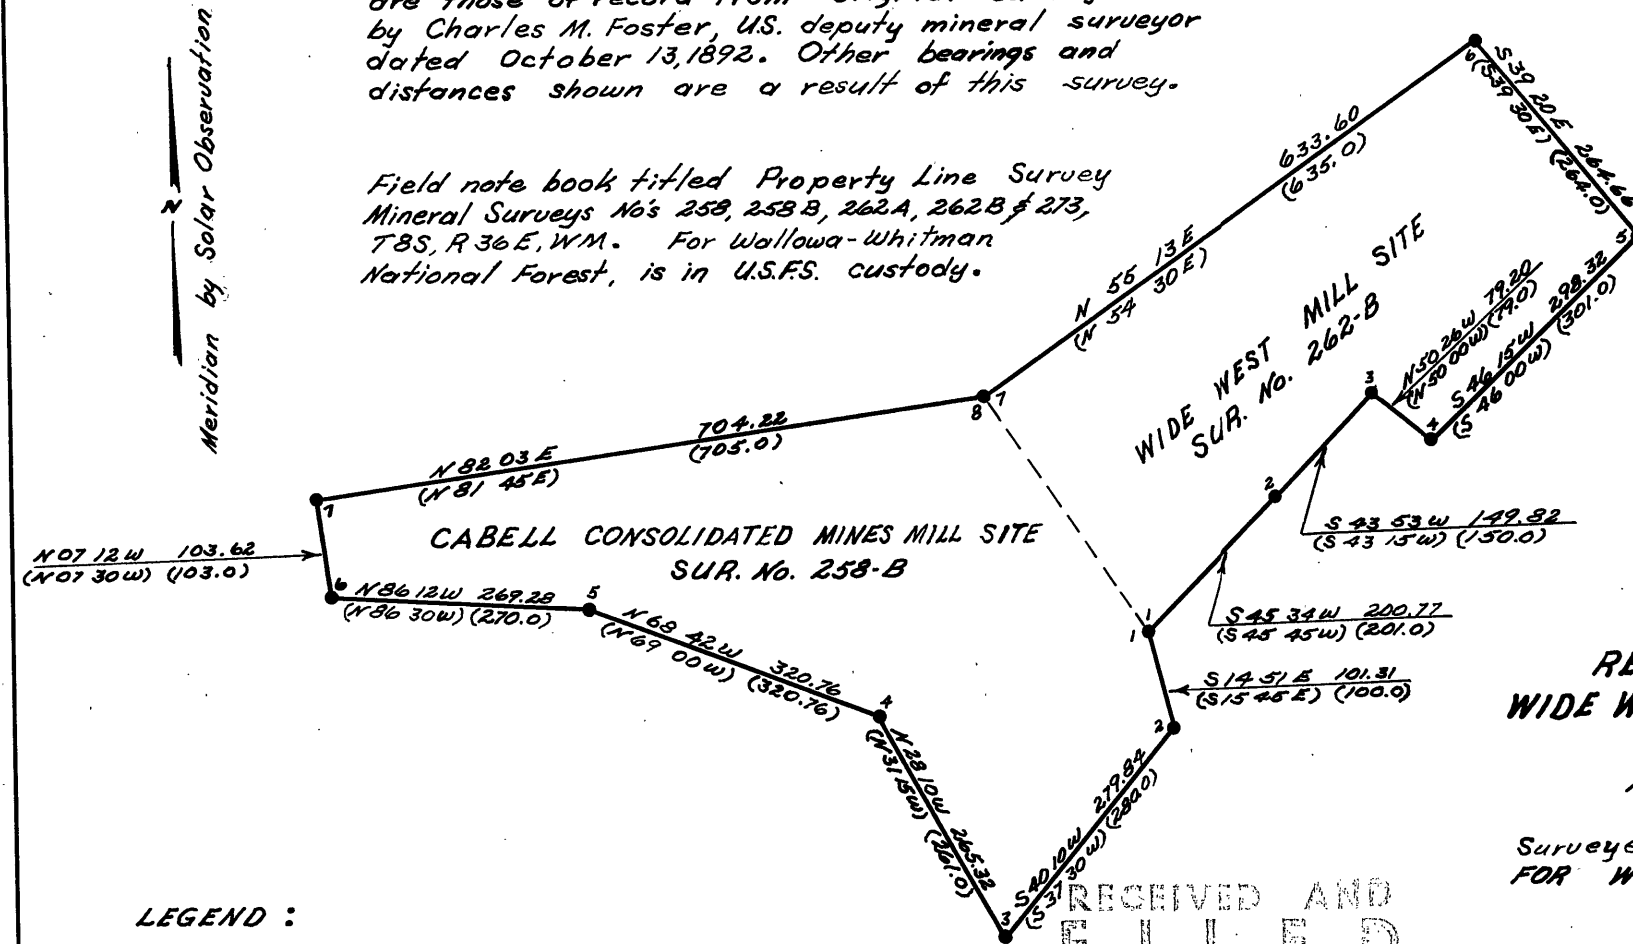

LEGEND :

- Monument 2" aluminum cap set this survey.

RECEIVED AND
FILED

NOV 15 1977

JOHN LIVEIRA, County Clerk

By DL Deputy

MAP OF SURVEY NO. 477

RECORD OF SURVEY PLAT
WIDE WEST & CABELL CONSOLIDATED MINES
MILL SITES

Mineral Surveys 258-B & 262-B
TBS, R36E WM
Surveyed July 1968 Scale 1" = 200'
FOR WALLOWA-WHITMAN NATIONAL FOREST

REGISTERED
OREGON
LAND SURVEYOR

James H. Hambleton
10-2-68

JULY 10, 1964
JAMES H. HAMBLETON
645

FILED 1-9-69
BAXER COUNTY SURVEYOR
SURVEY NO. 8-36-1