


Meridian from 1937 Retracement

Note :
Bearings and distances shown in parentheses are those of record from retracement survey notes, by Otis Gould, U.S. mineral surveyor, dated July 1937. Other bearings and distances shown are a result of this survey.

Field note book titled Property Line Survey, Mineral Survey No's 258, 258 B, 262 A 262 B & 273, T8S, R36E W.M. For Wallowa-Whitman National Forest, is in U.S.F.S. custody.

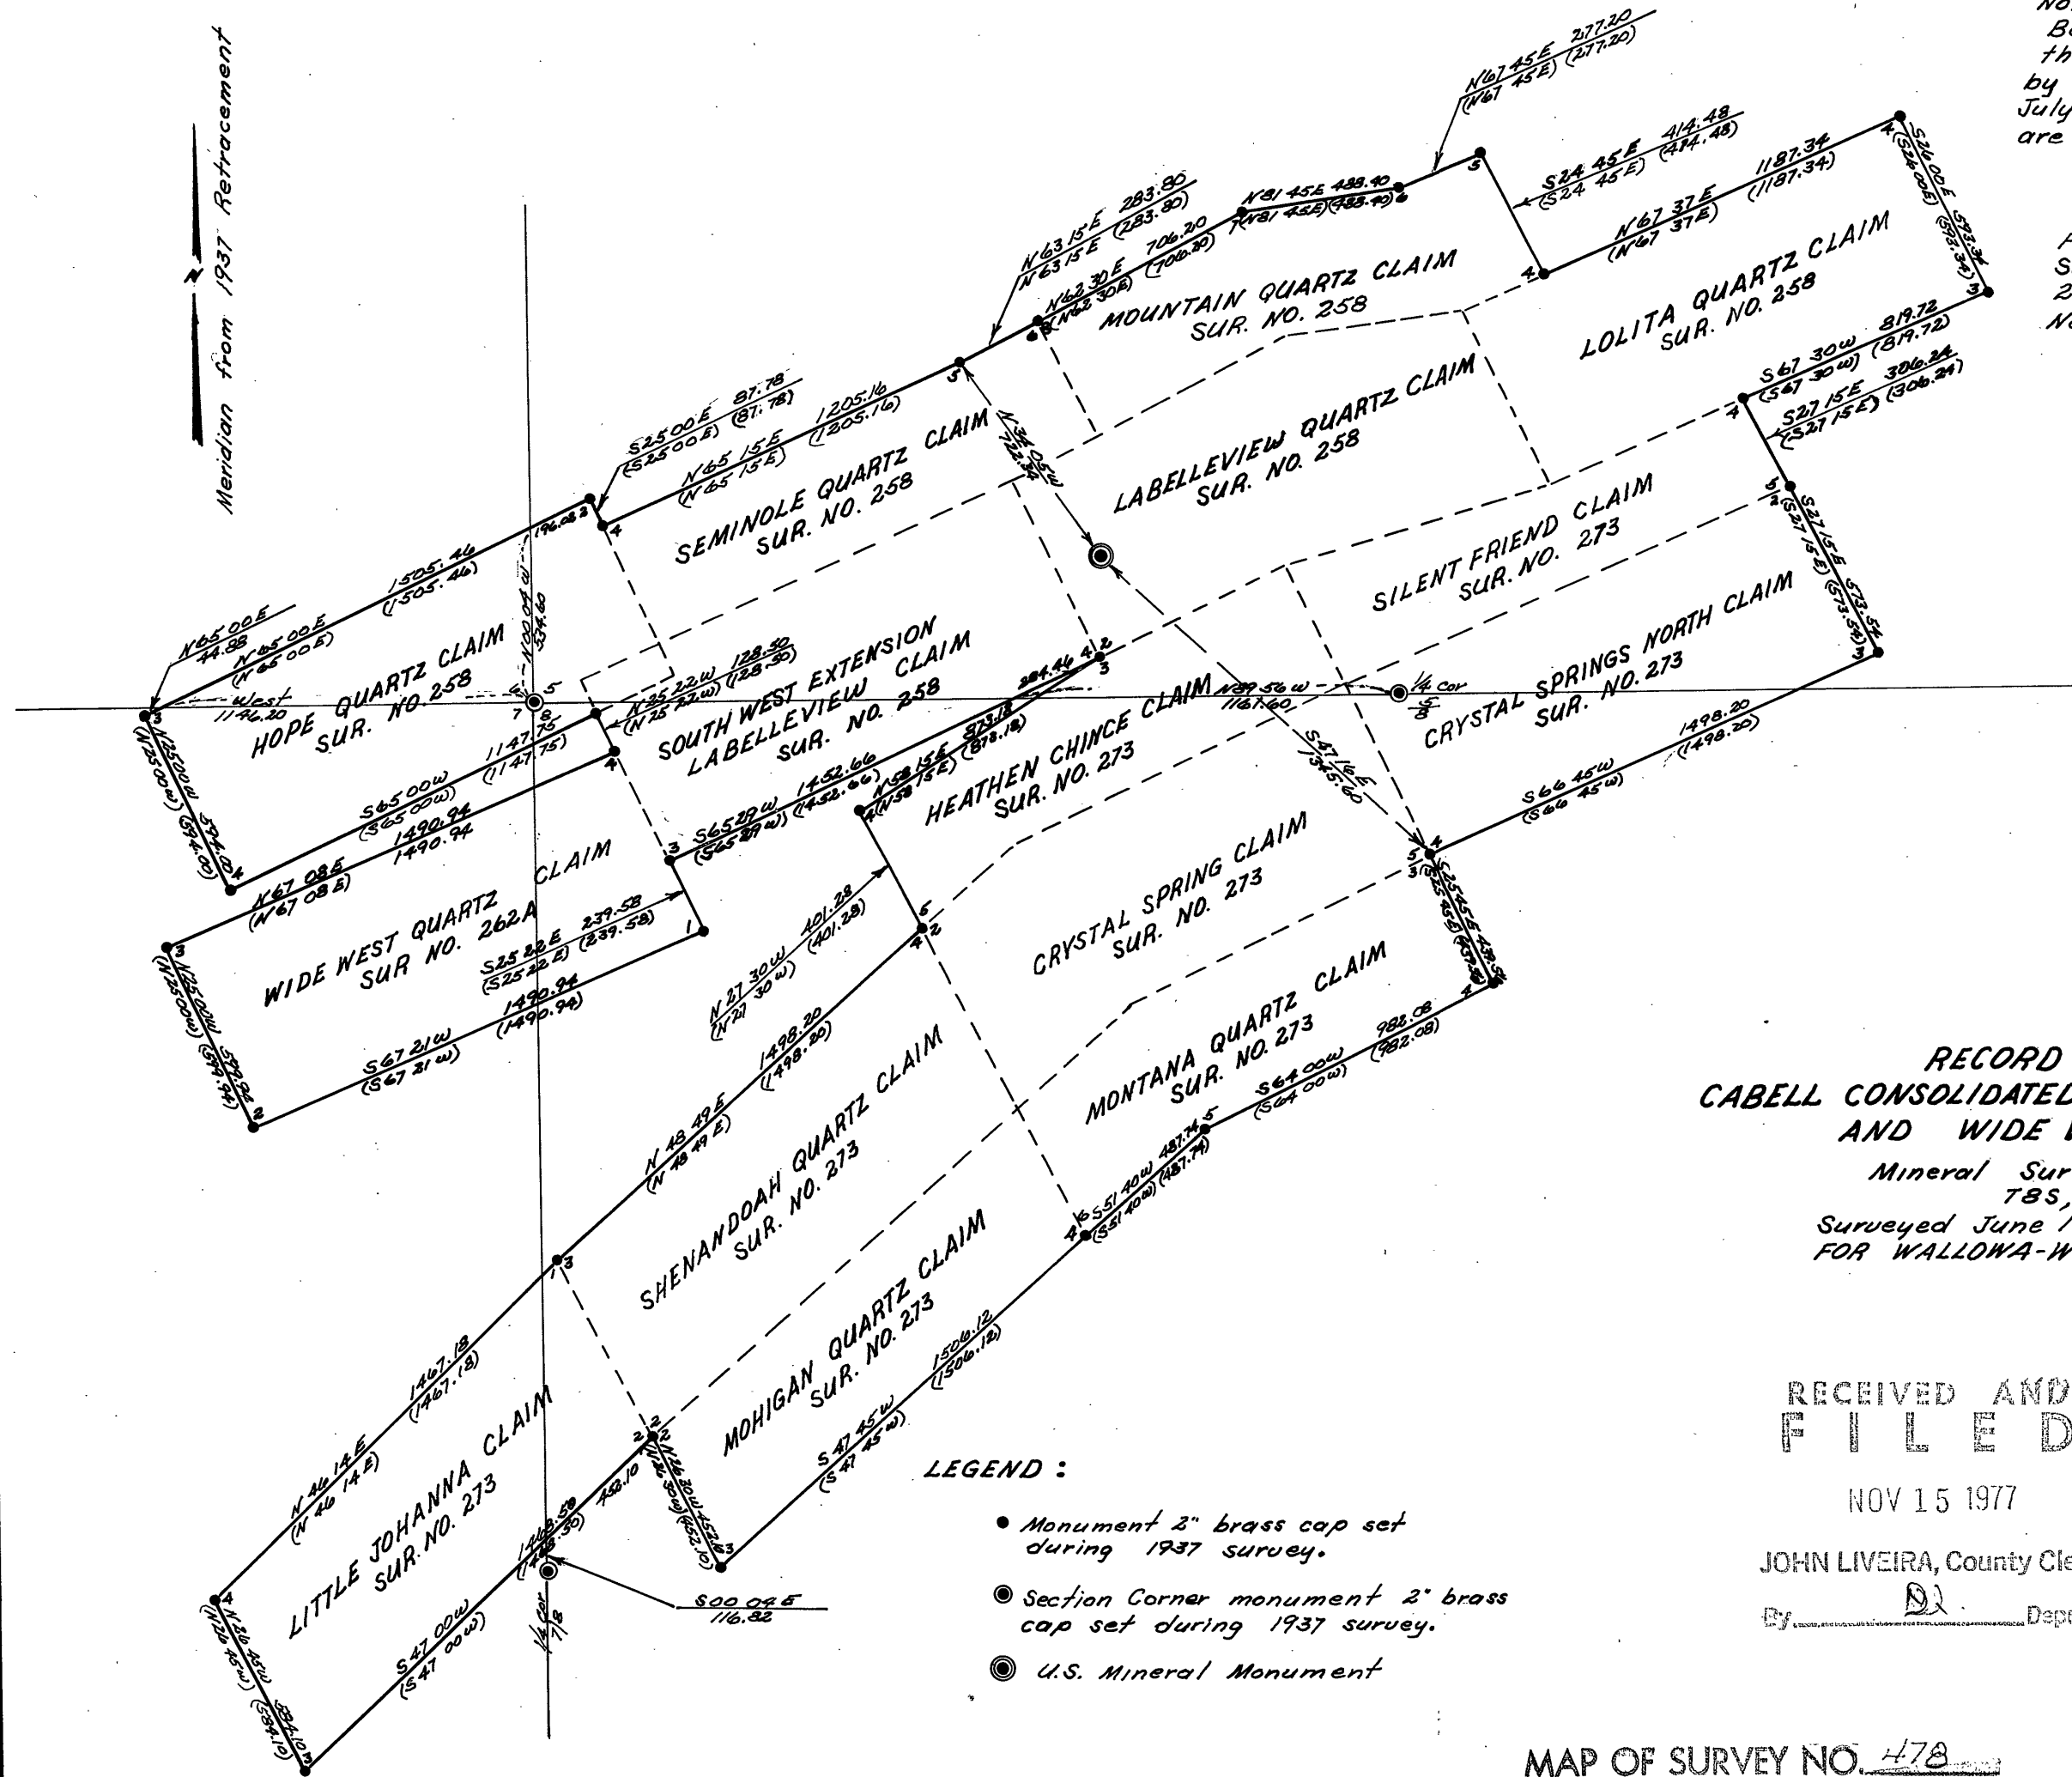

RECORD OF SURVEY PLAT
CABELL CONSOLIDATED, CRYSTAL SPRING CONSOLIDATED
AND WIDE WEST QUARTZ CLAIMS

Mineral Survey No's 258, 262A & 273
T8S, R36E, W.M.
Surveyed June 1968 Scale 1" = 500'
FOR WALLOWA-WHITMAN NATIONAL FOREST

RECEIVED AND
FILED

NOV 15 1977

JOHN LIVEIRA, County Clerk

By *[Signature]* Deputy

FILED 1-9-69
BAKER COUNTY SURVEYOR
SURVEY NO. 8-36-16

REGISTERED
OREGON
LAND SURVEYOR
James H. Hambleton
10-15-68
JULY 10, 1964
JAMES H. HAMBLETON
645

MAP OF SURVEY NO. 478