


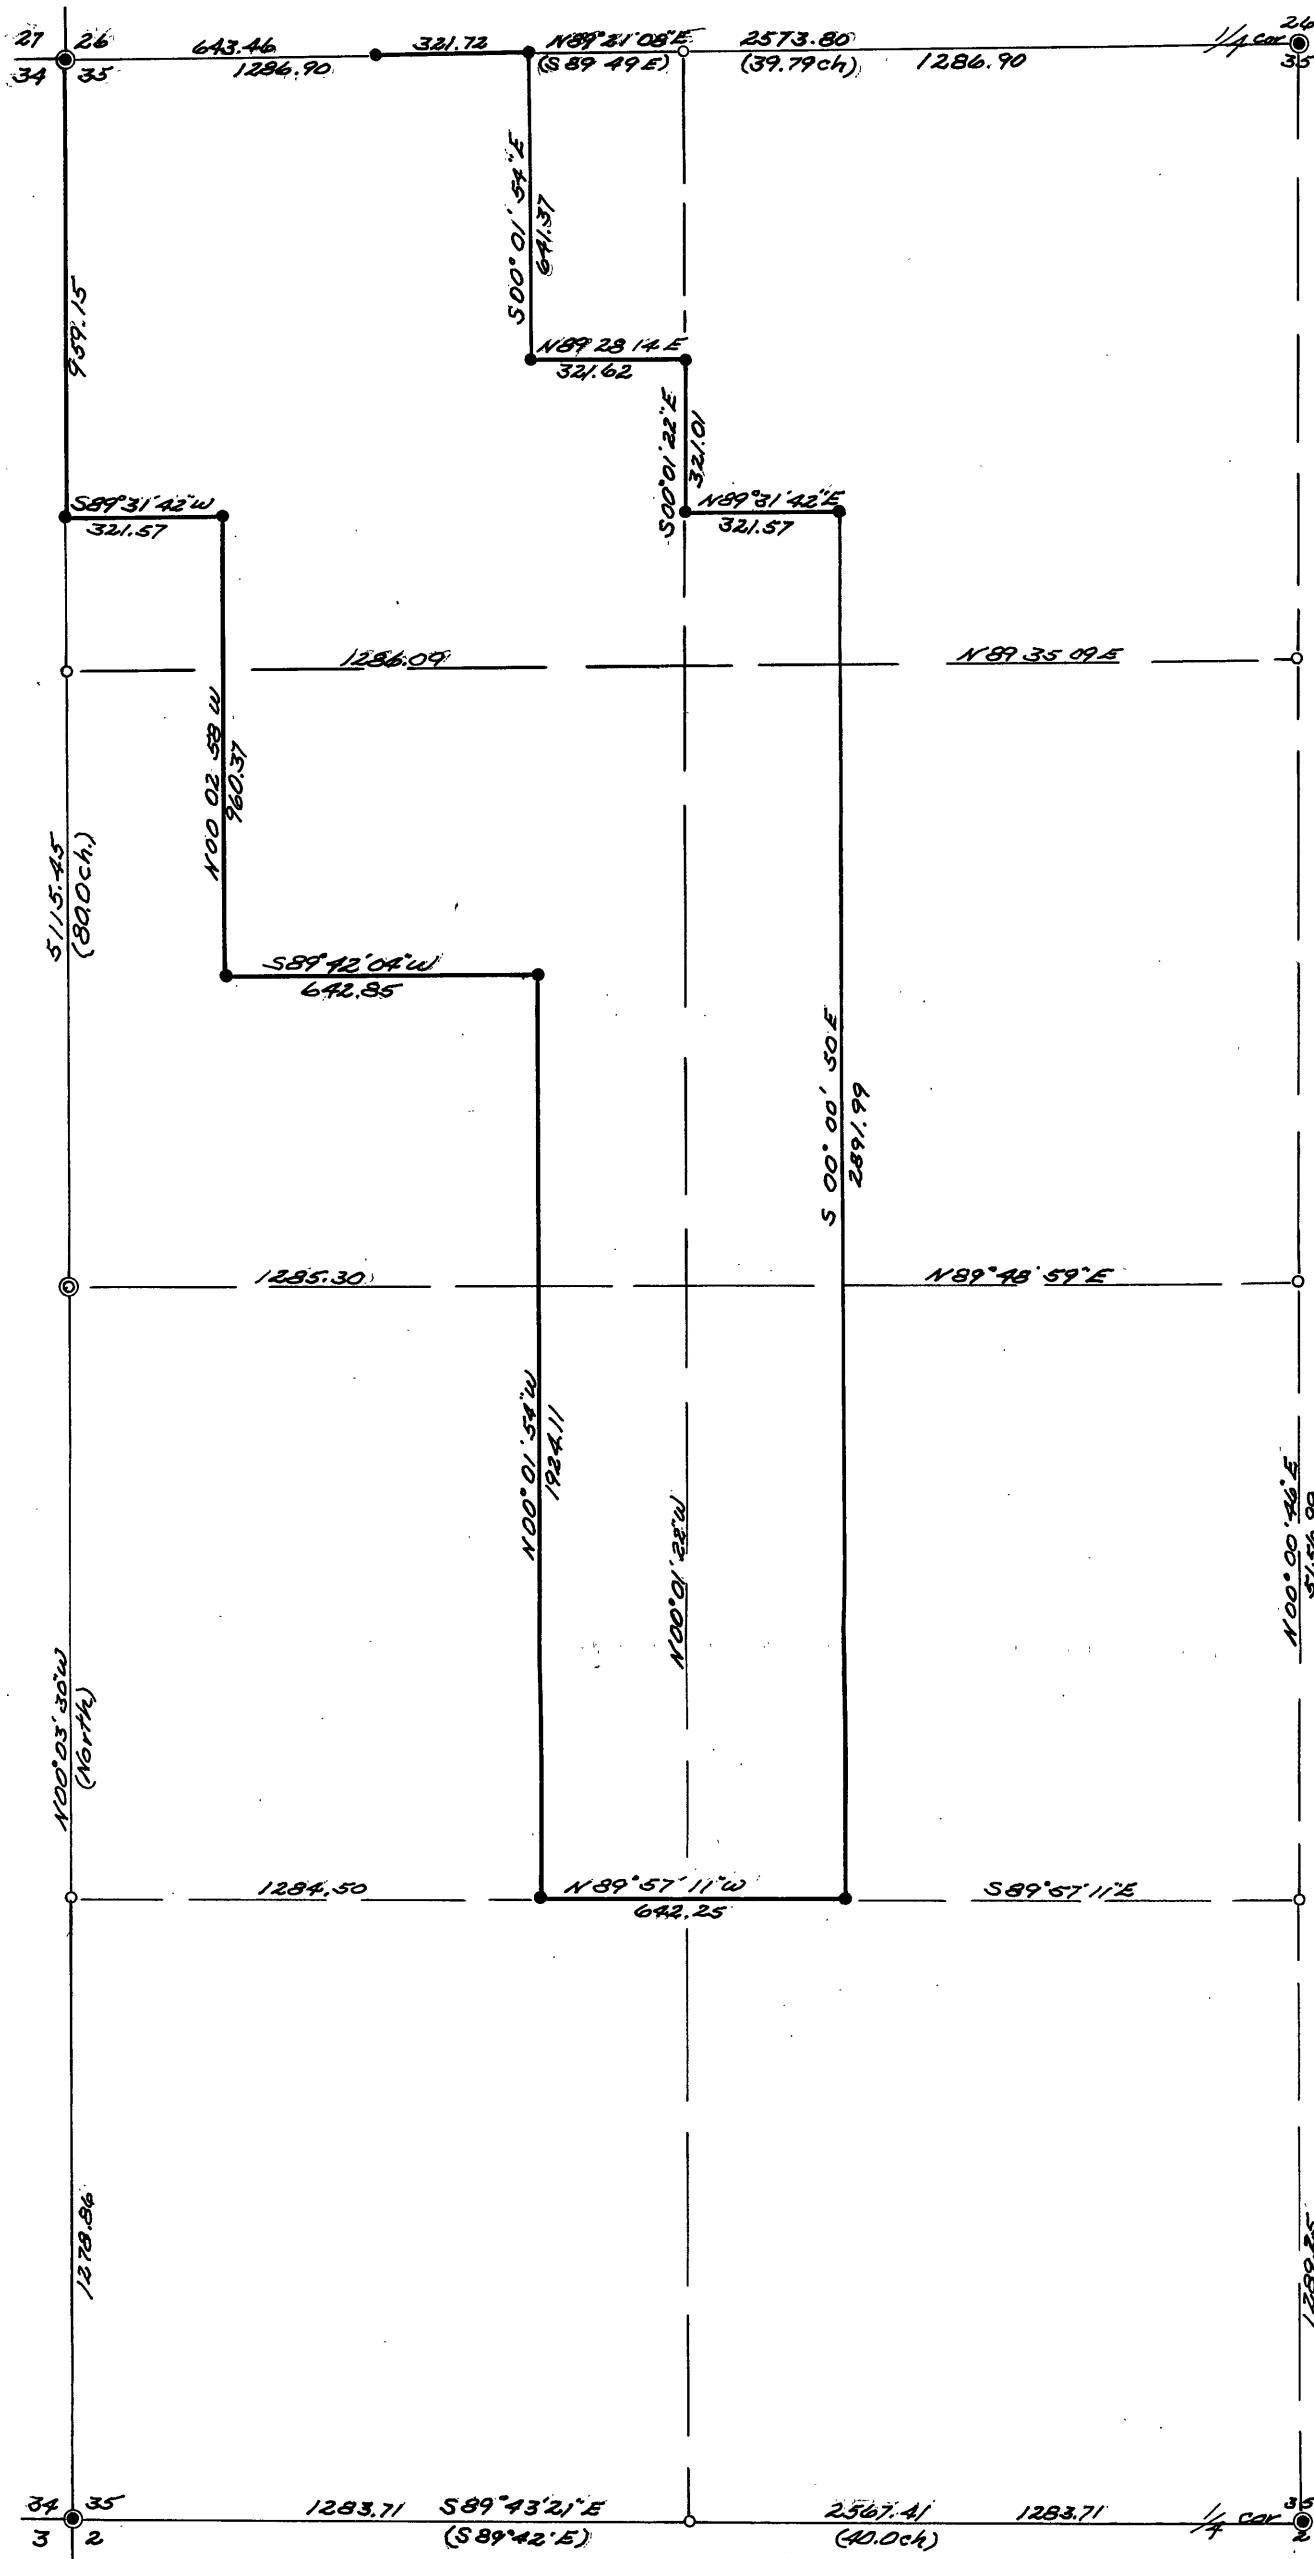

Note :
Bearings and distances shown in parentheses are those of record from original survey notes, by Herman D. Graddon under contract no. 416, dated October 1881. Other bearings and distances shown are a result of this survey.

Field note book titled Property Line Survey, Sec. 35 T9S, R35E W.M. & Mineral Survey No's 420, 595, 617 & 709 For Wallowa-Whitman National Forest, is in U.S.F.S. custody.

LEGEND:

- Monument 2" aluminum cap set this survey.
- Subdivision corner not set this survey.
- Section Corner monument 2" aluminum cap set this survey.
- Section corner not found or set during this survey.

RECORD OF SURVEY PLAT SUBDIVISION OF SECTION 35 T9S, R35E W.M.

Surveyed September 1968 Scale 1"=400'
FOR WALLOWA-WHITMAN NATIONAL FOREST

RECEIVED AND
FILED

NOV 15 1977

JOHN LIVEIRA, County Clerk

By L. I. Deputy

FILED 1-9-69

BAKER COUNTY SURVEYOR

SURVEY NO. 9-35-36

MAP OF SURVEY NO. 479

