


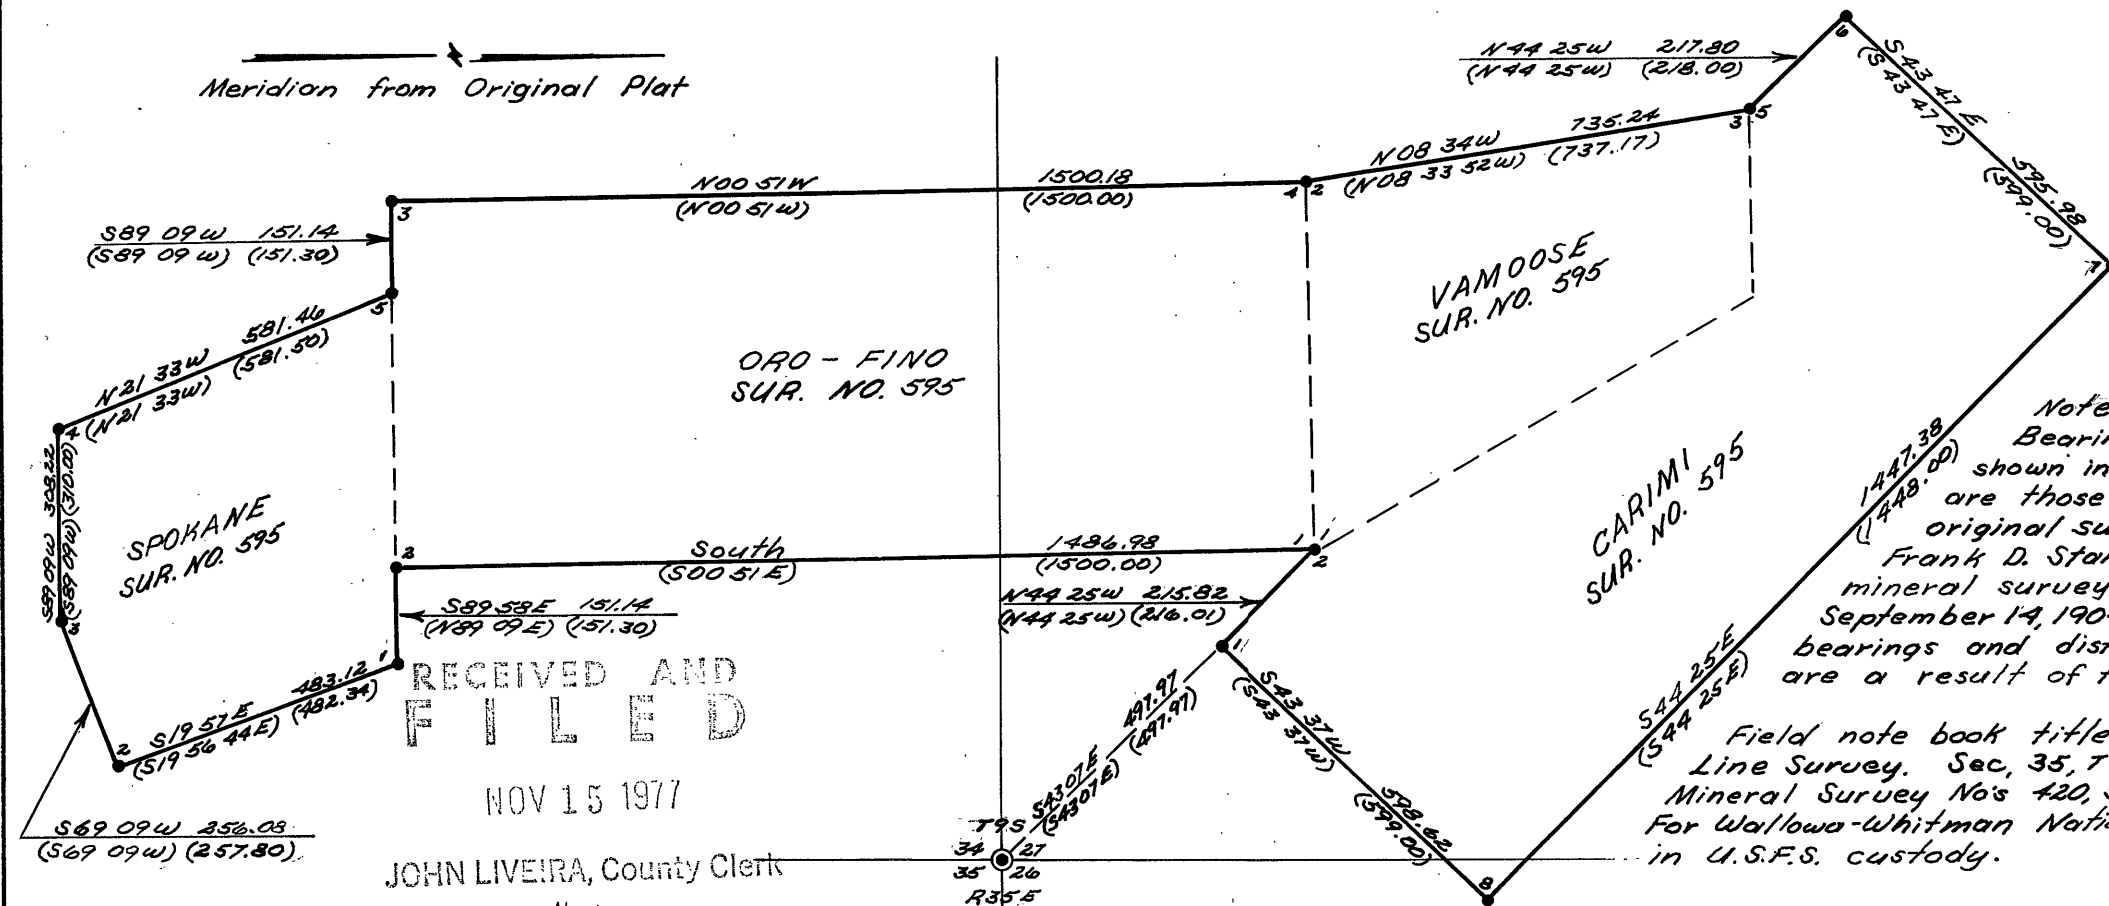

Note :
Bearings and distances shown in parentheses are those of record from original survey notes, by Frank D. Stanley, U.S. deputy mineral surveyor, dated September 14, 1904. Other bearings and distances shown are a result of this survey.

Field note book titled Property Line Survey. Sec. 35, T9S, R35E W.M. & Mineral Survey No's 420, 595, 617 & 709 For Wallowa-Whitman National Forest, is in U.S.F.S. custody.

RECORD OF SURVEY PLAT ORO-FINO, VAMOOSE, CARIMI AND SPOKANE LODES

Mineral Survey No. 595
T9S, R35E, W.M.
Surveyed August 1968
FOR WALLOWA-WHITMAN NATIONAL FOREST

REGISTERED
OREGON
LAND SURVEYOR

James H. Hambleton
10-15-68

JULY 10, 1964
JAMES H. HAMBLETON
645

MAP OF SURVEY NO. 480