


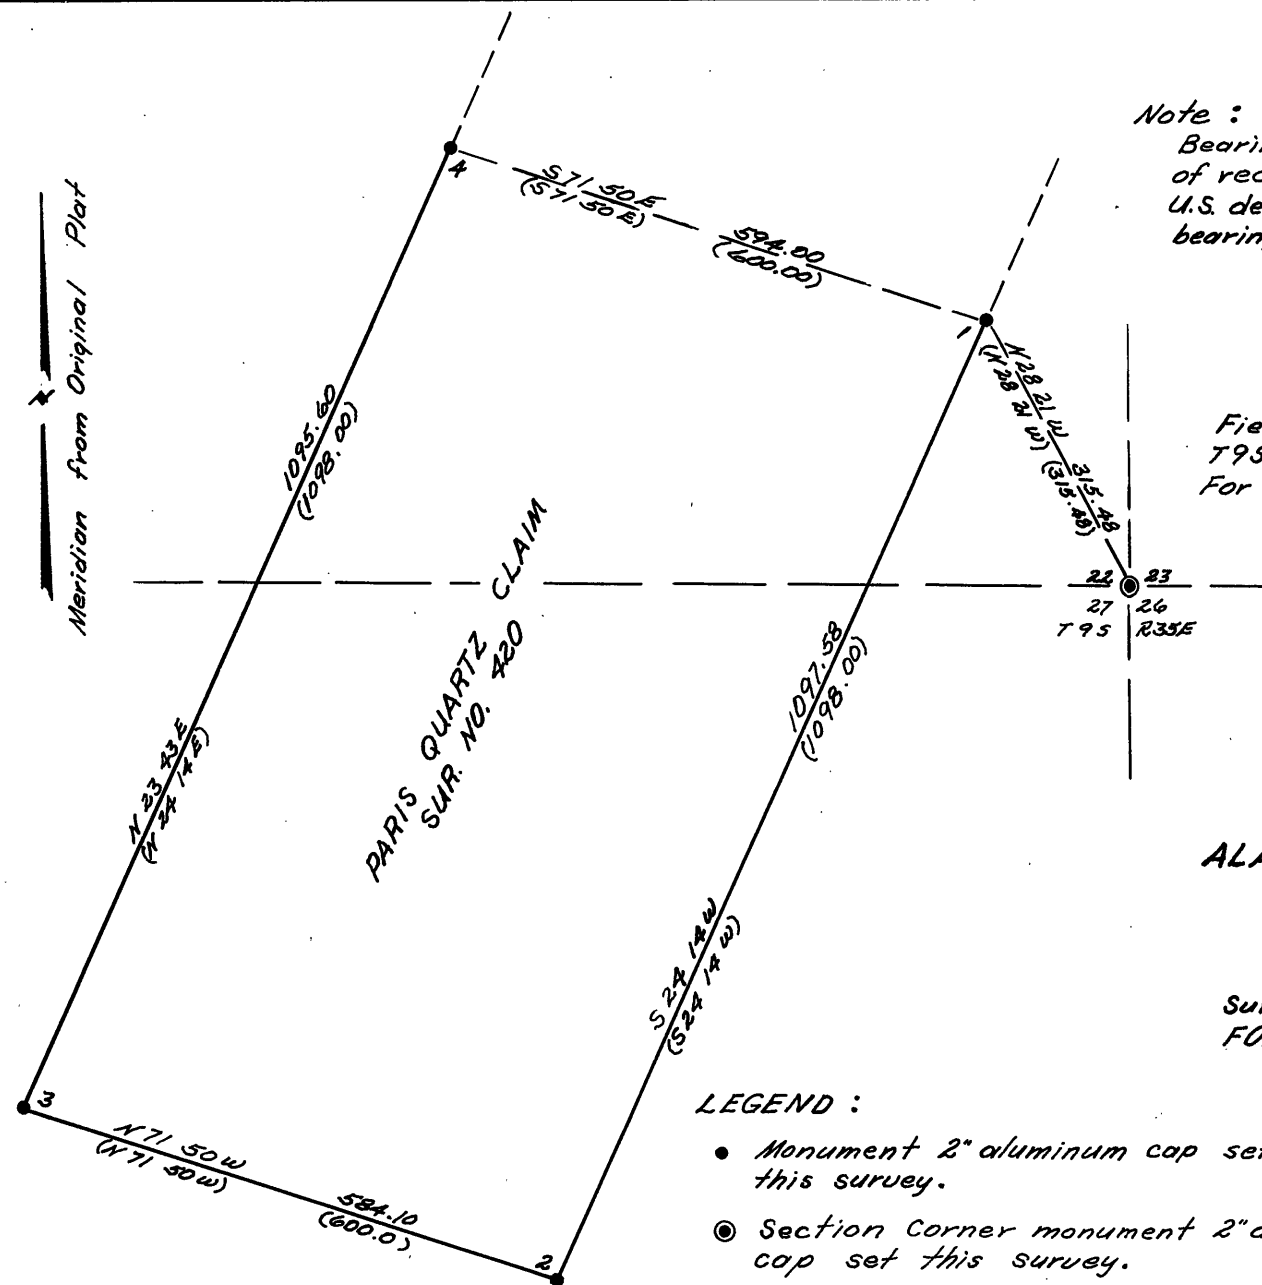

Note :
Bearings and distances shown in parentheses are those of record from original survey notes by Frank D. Stanley U.S. deputy surveyor, dated December 20, 1901. Other bearings and distances shown are a result of this survey.

Field note book titled Property Line Survey, Sec. 35, T9S, R35E, WM. & Mineral Survey No's 420, 595, 617 & 709 For Wallowa-Whitman National Forest, is in U.S.F.S. custody.

RECEIVED AND
FILED

NOV 15 1977

JOHN LIVEIRA, County Clerk

RECORD OF SURVEY PLAT, ALAMO CONSOLIDATED MINING CLAIM, Deputy
PAIRS QUARTZ CLAIM

Mineral Survey No. 420
T9S R35E WM
Surveyed July 1968 Scale 1"=200'
FOR WALLOWA-WHITMAN NATIONAL FOREST

- LEGEND :
- Monument 2" aluminum cap set this survey.
 - ⊙ Section Corner monument 2" aluminum cap set this survey.

REGISTERED
OREGON
LAND SURVEYOR

James H. Hambleton
10-11-68

JULY 10, 1964
JAMES H. HAMBLETON
645

FILED 1-9-69
BAKER COUNTY SURVEYOR
SURVEY NO. 9-35-1

MAP OF SURVEY NO. 482