


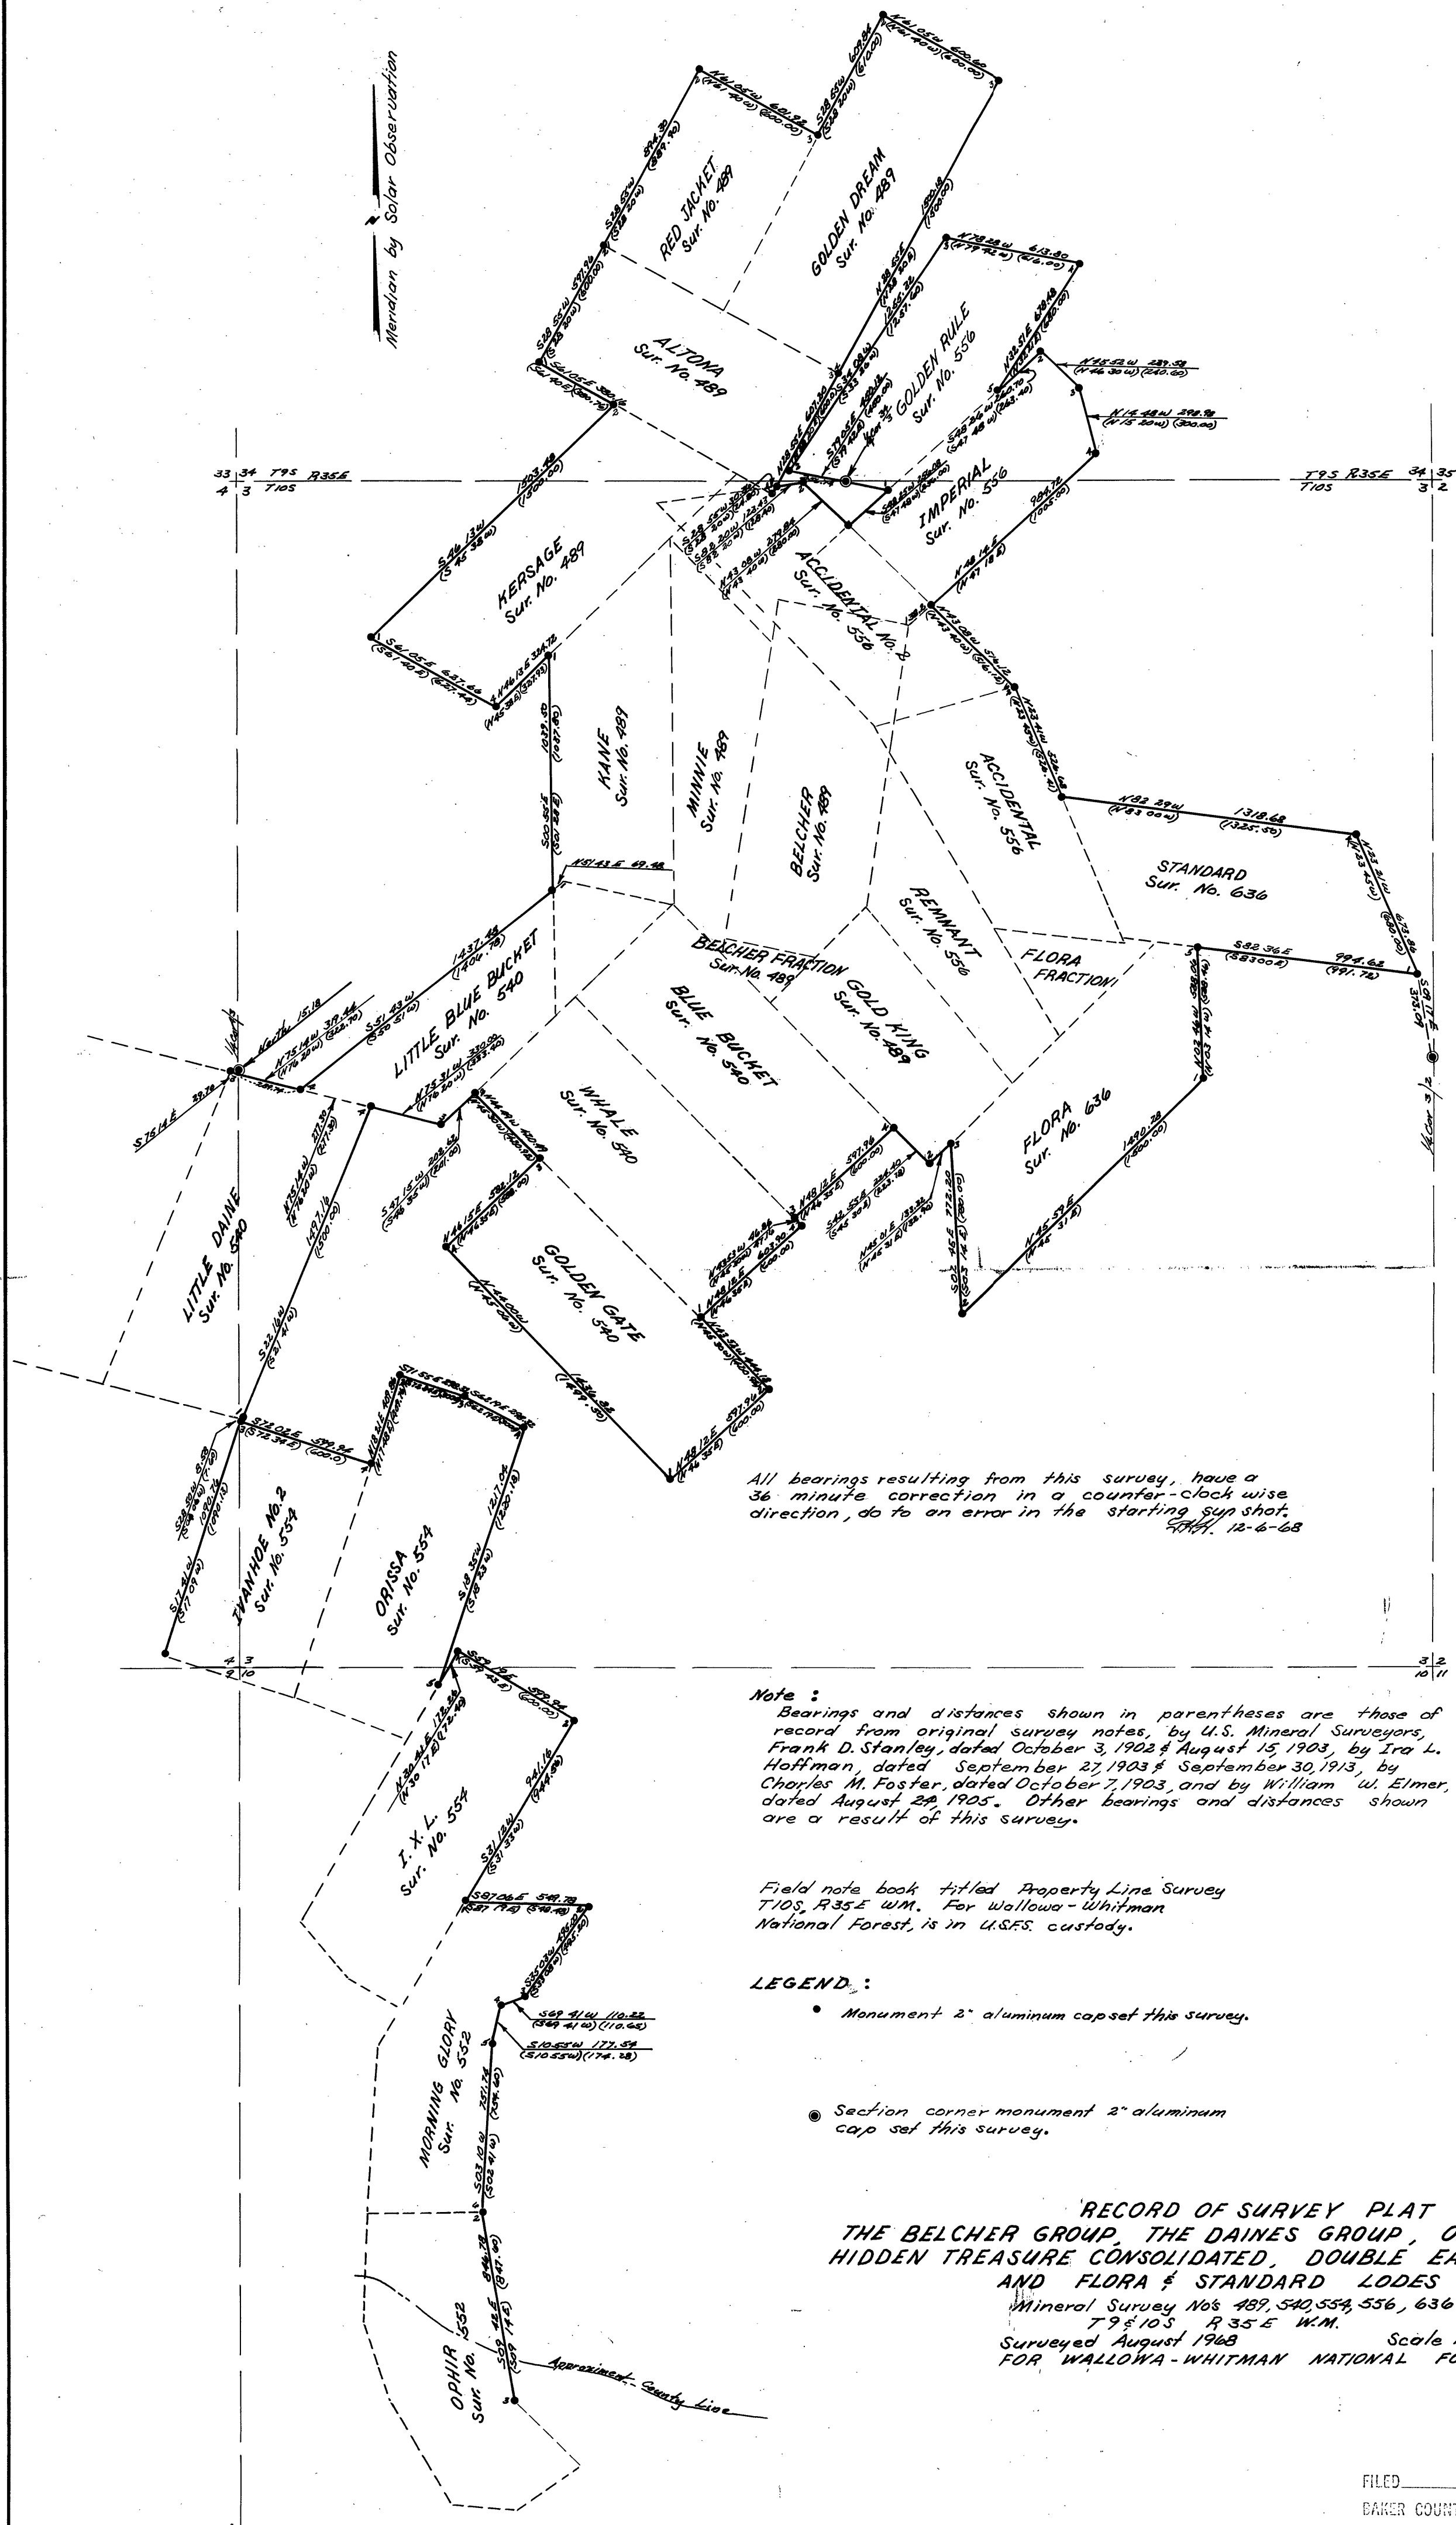

All bearings resulting from this survey, have a 36 minute correction in a counter-clock wise direction, do to an error in the starting sun shot.
S.M.T. 12-6-68

Note :
Bearings and distances shown in parentheses are those of record from original survey notes, by U.S. Mineral Surveyors, Frank D. Stanley, dated October 3, 1902 & August 15, 1903, by Ira L. Hoffman, dated September 27, 1903 & September 30, 1913, by Charles M. Foster, dated October 7, 1903, and by William W. Elmer, dated August 24, 1905. Other bearings and distances shown are a result of this survey.

Field note book titled Property Line Survey T10S, R35E W.M. For Wallowa-Whitman National Forest, is in U.S.F.S. custody.

- LEGEND :**
- Monument 2" aluminum cap set this survey.
 - Section corner monument 2" aluminum cap set this survey.

RECORD OF SURVEY PLAT
THE BELCHER GROUP, THE DAINES GROUP, OPHIR CONSOLIDATED,
HIDDEN TREASURE CONSOLIDATED, DOUBLE EAGLE CONSOLIDATED,
AND FLORA & STANDARD LODES
Mineral Survey Nos 489, 540, 554, 556, 636
Surveyed August 1968 Scale 1"=500'
FOR WALLOWA-WHITMAN NATIONAL FOREST

RECEIVED AND
FILED
NOV 15 1977
JOHN LIVEIRA, County Clerk
By *PL* Deputy

REGISTERED
OREGON
LAND SURVEYOR
James H. Hambleton
10-16-68
JULY 10, 1964
JAMES H. HAMBLETON
645

FILED 1-9-69
BAKER COUNTY SURVEYOR
SURVEY NO. 10-35-9