


RECORD OF SURVEY PLAT
SUBDIVISION of SECTION 11, 13 & 14, T8S, R35½E WM
GRANT COUNTY OREGON

WALLOWA WHITMAN NATIONAL FOREST
 Scale 1"=1000'
 Date 7-25-77

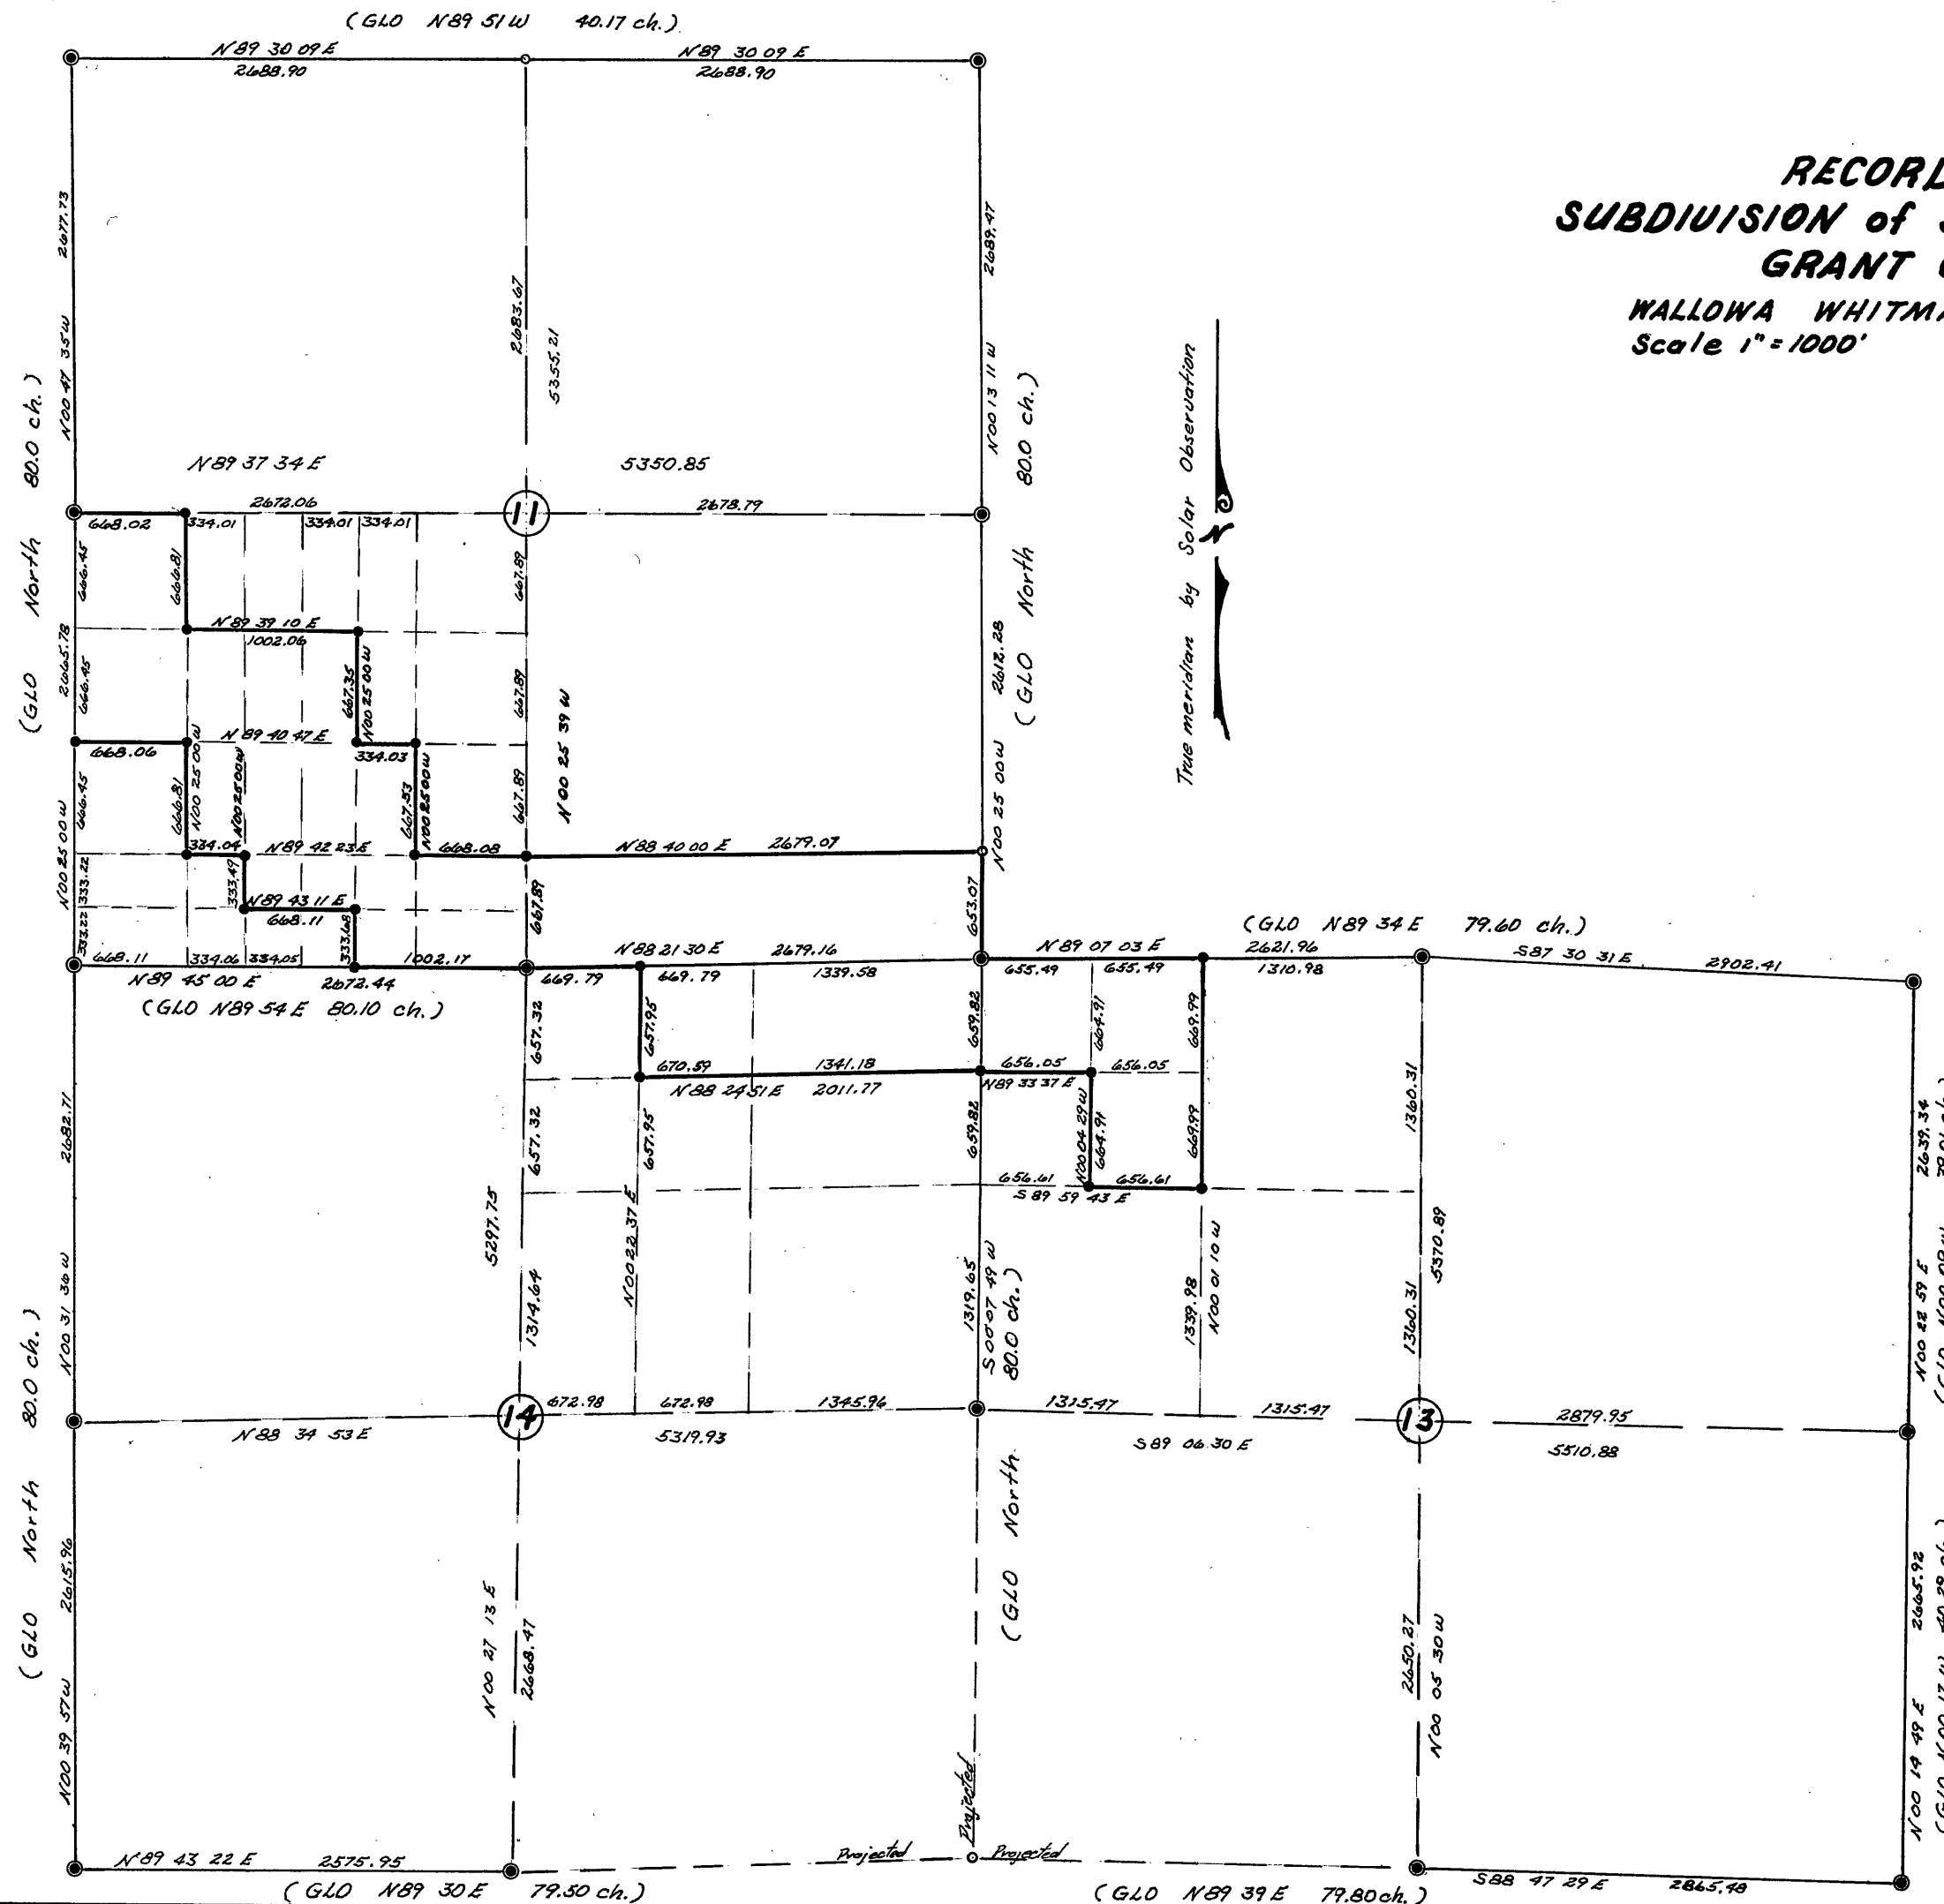

NOTE :

This survey is an amendment to a survey dated June 1968 and therefore voids the 1968 survey in its entirety.

SURVEYORS CERTIFICATE :

I, James H. Hambleton, do hereby certify that this is a true representation of a survey made by me during 1976 & 1977, in order to amend a previous survey made by my firm.

**RECEIVED AND
 FILED**

NOV 15 1977

JOHN LIVEIRA, County Clerk

By D. L. Deputy

REGISTERED
 PROFESSIONAL
 LAND SURVEYOR

James H. Hambleton

OREGON
 JULY 10, 1964
 JAMES H. HAMBLETON
 645

MAP OF SURVEY NO. 485

Supercedes Survey No. 473