


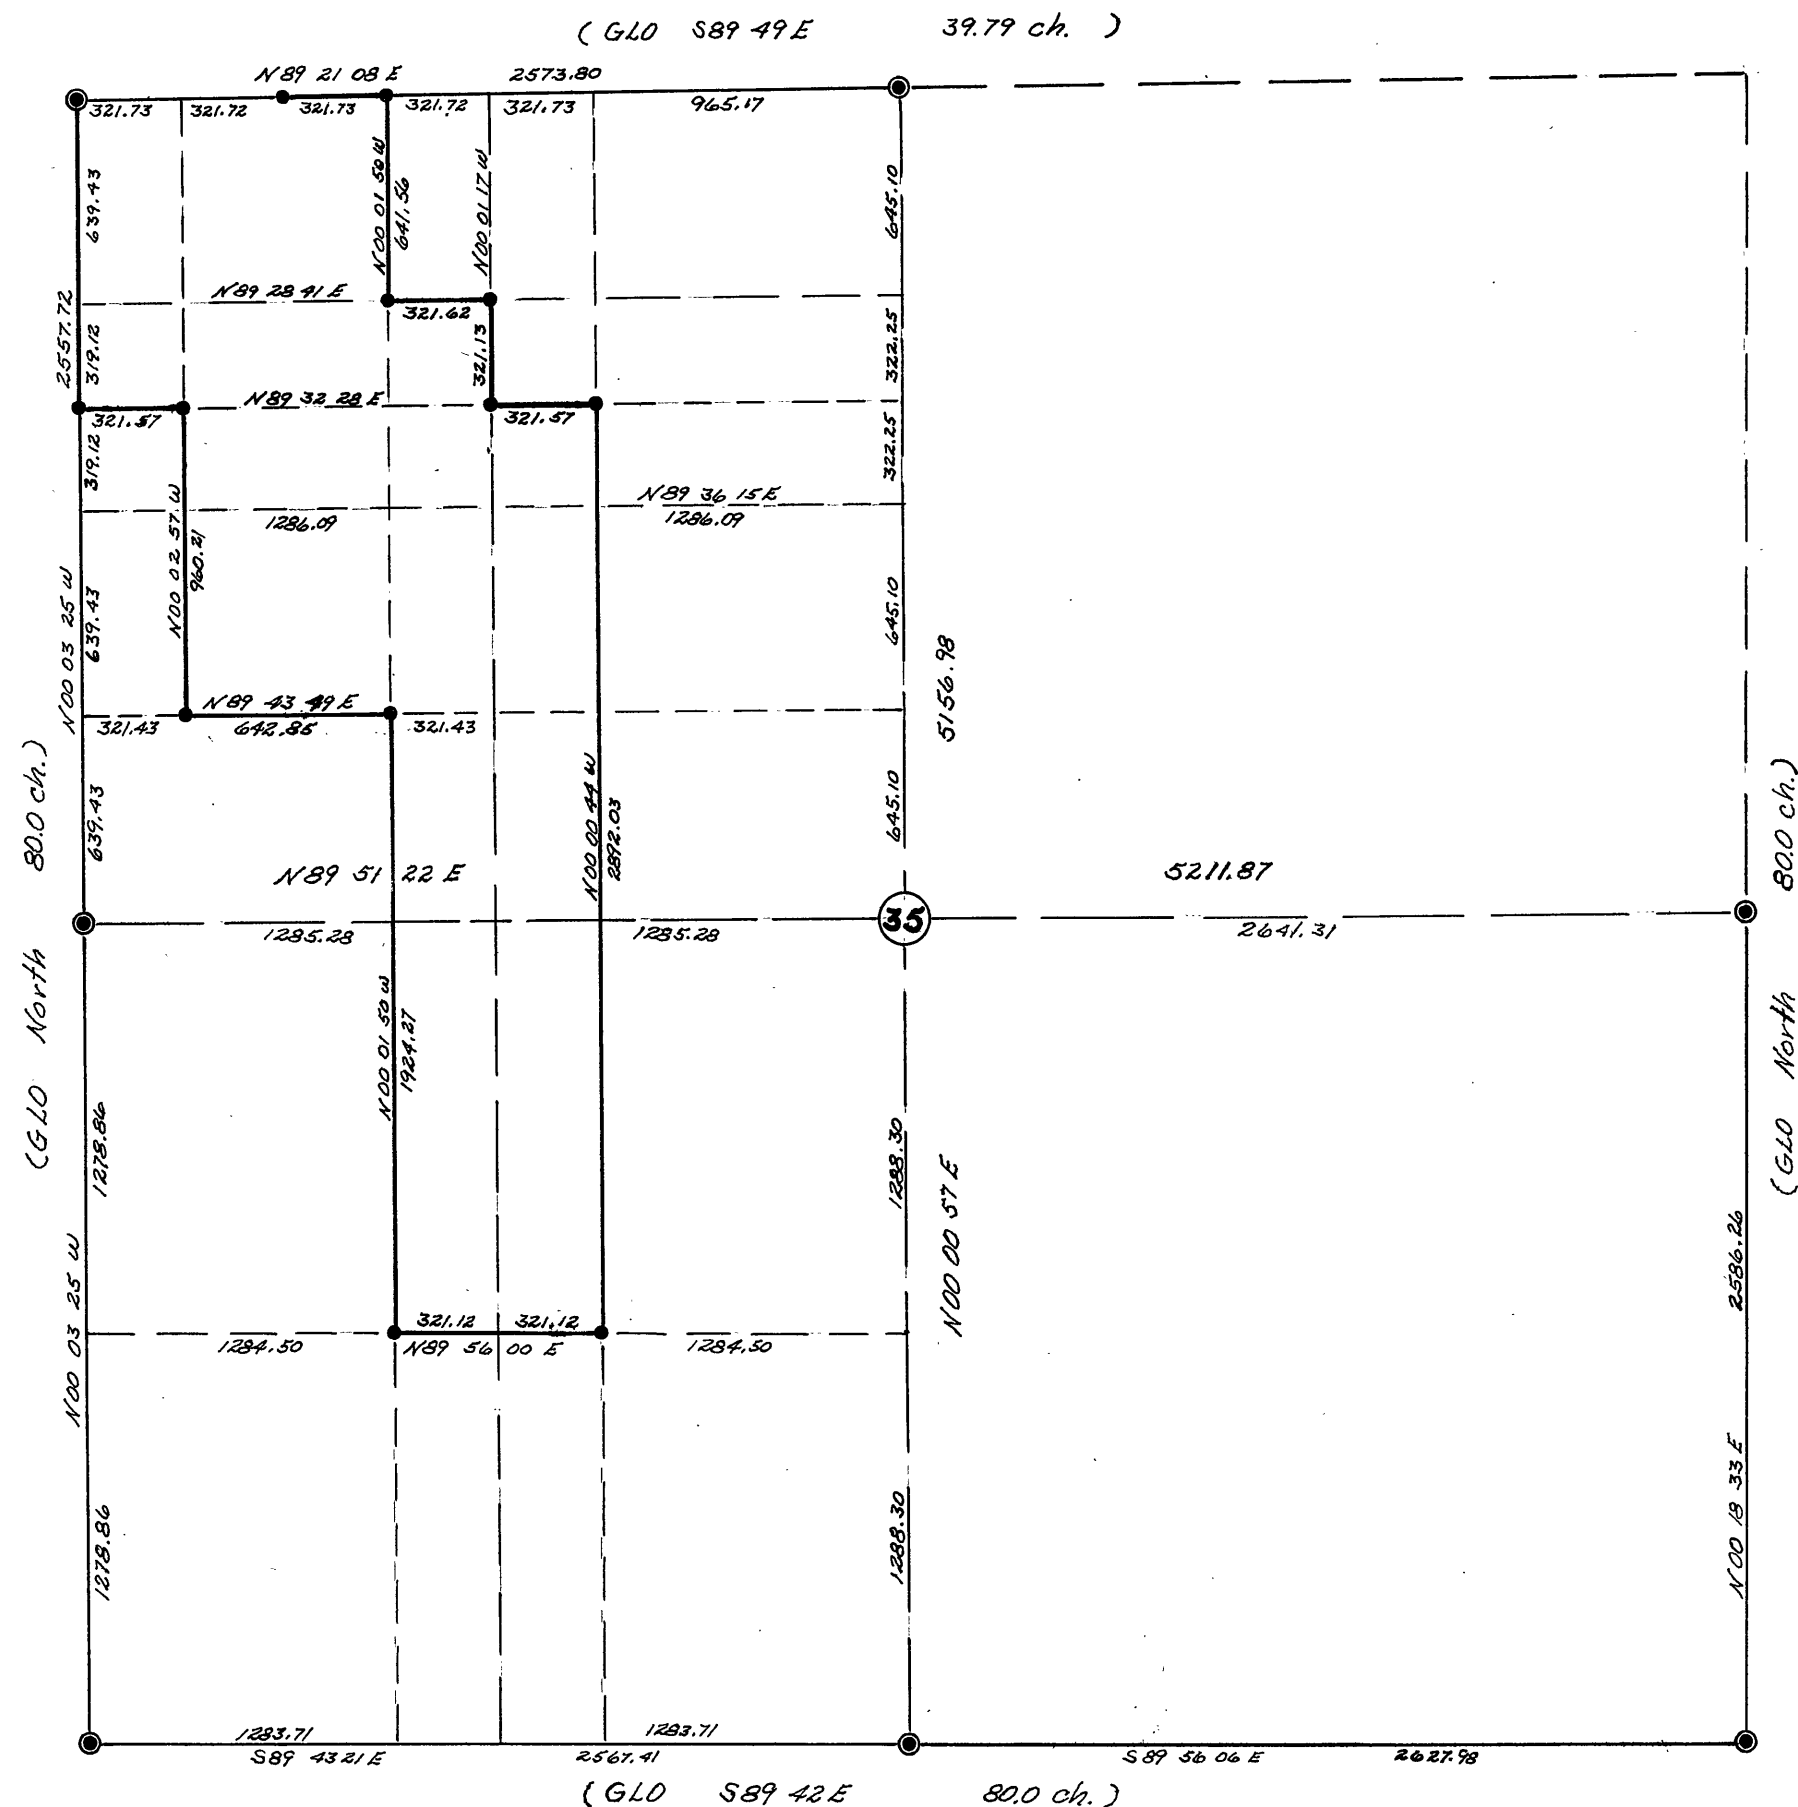

**RECORD of SURVEY PLAT
SUBDIVISION of SECTION 35, T9S, R35E WM.
GRANT COUNTY OREGON**

WALLOWA WHITMAN NATIONAL FOREST
Scale 1"=600' Date 7-25-77

NOTE :

This survey is an amendment to a survey dated September 1968 and therefor voids the 1968 survey in its entirety.

SURVEYORS CERTIFICATE :

I, James H. Hambleton, do hereby certify that this is a true representation of a survey made by me during 1976 & 1977, in order to amend a previous survey made by my firm.

RECEIVED AND
FILED

NOV 15 1977

JOHN LIVEIRA, County Clerk

By D. L. Deputy

REGISTERED
PROFESSIONAL
LAND SURVEYOR

James H. Hambleton

OREGON
JULY 10, 1964
JAMES H. HAMBLETON
645

MAP OF SURVEY NO. 486

Supersedes Survey No. 479