


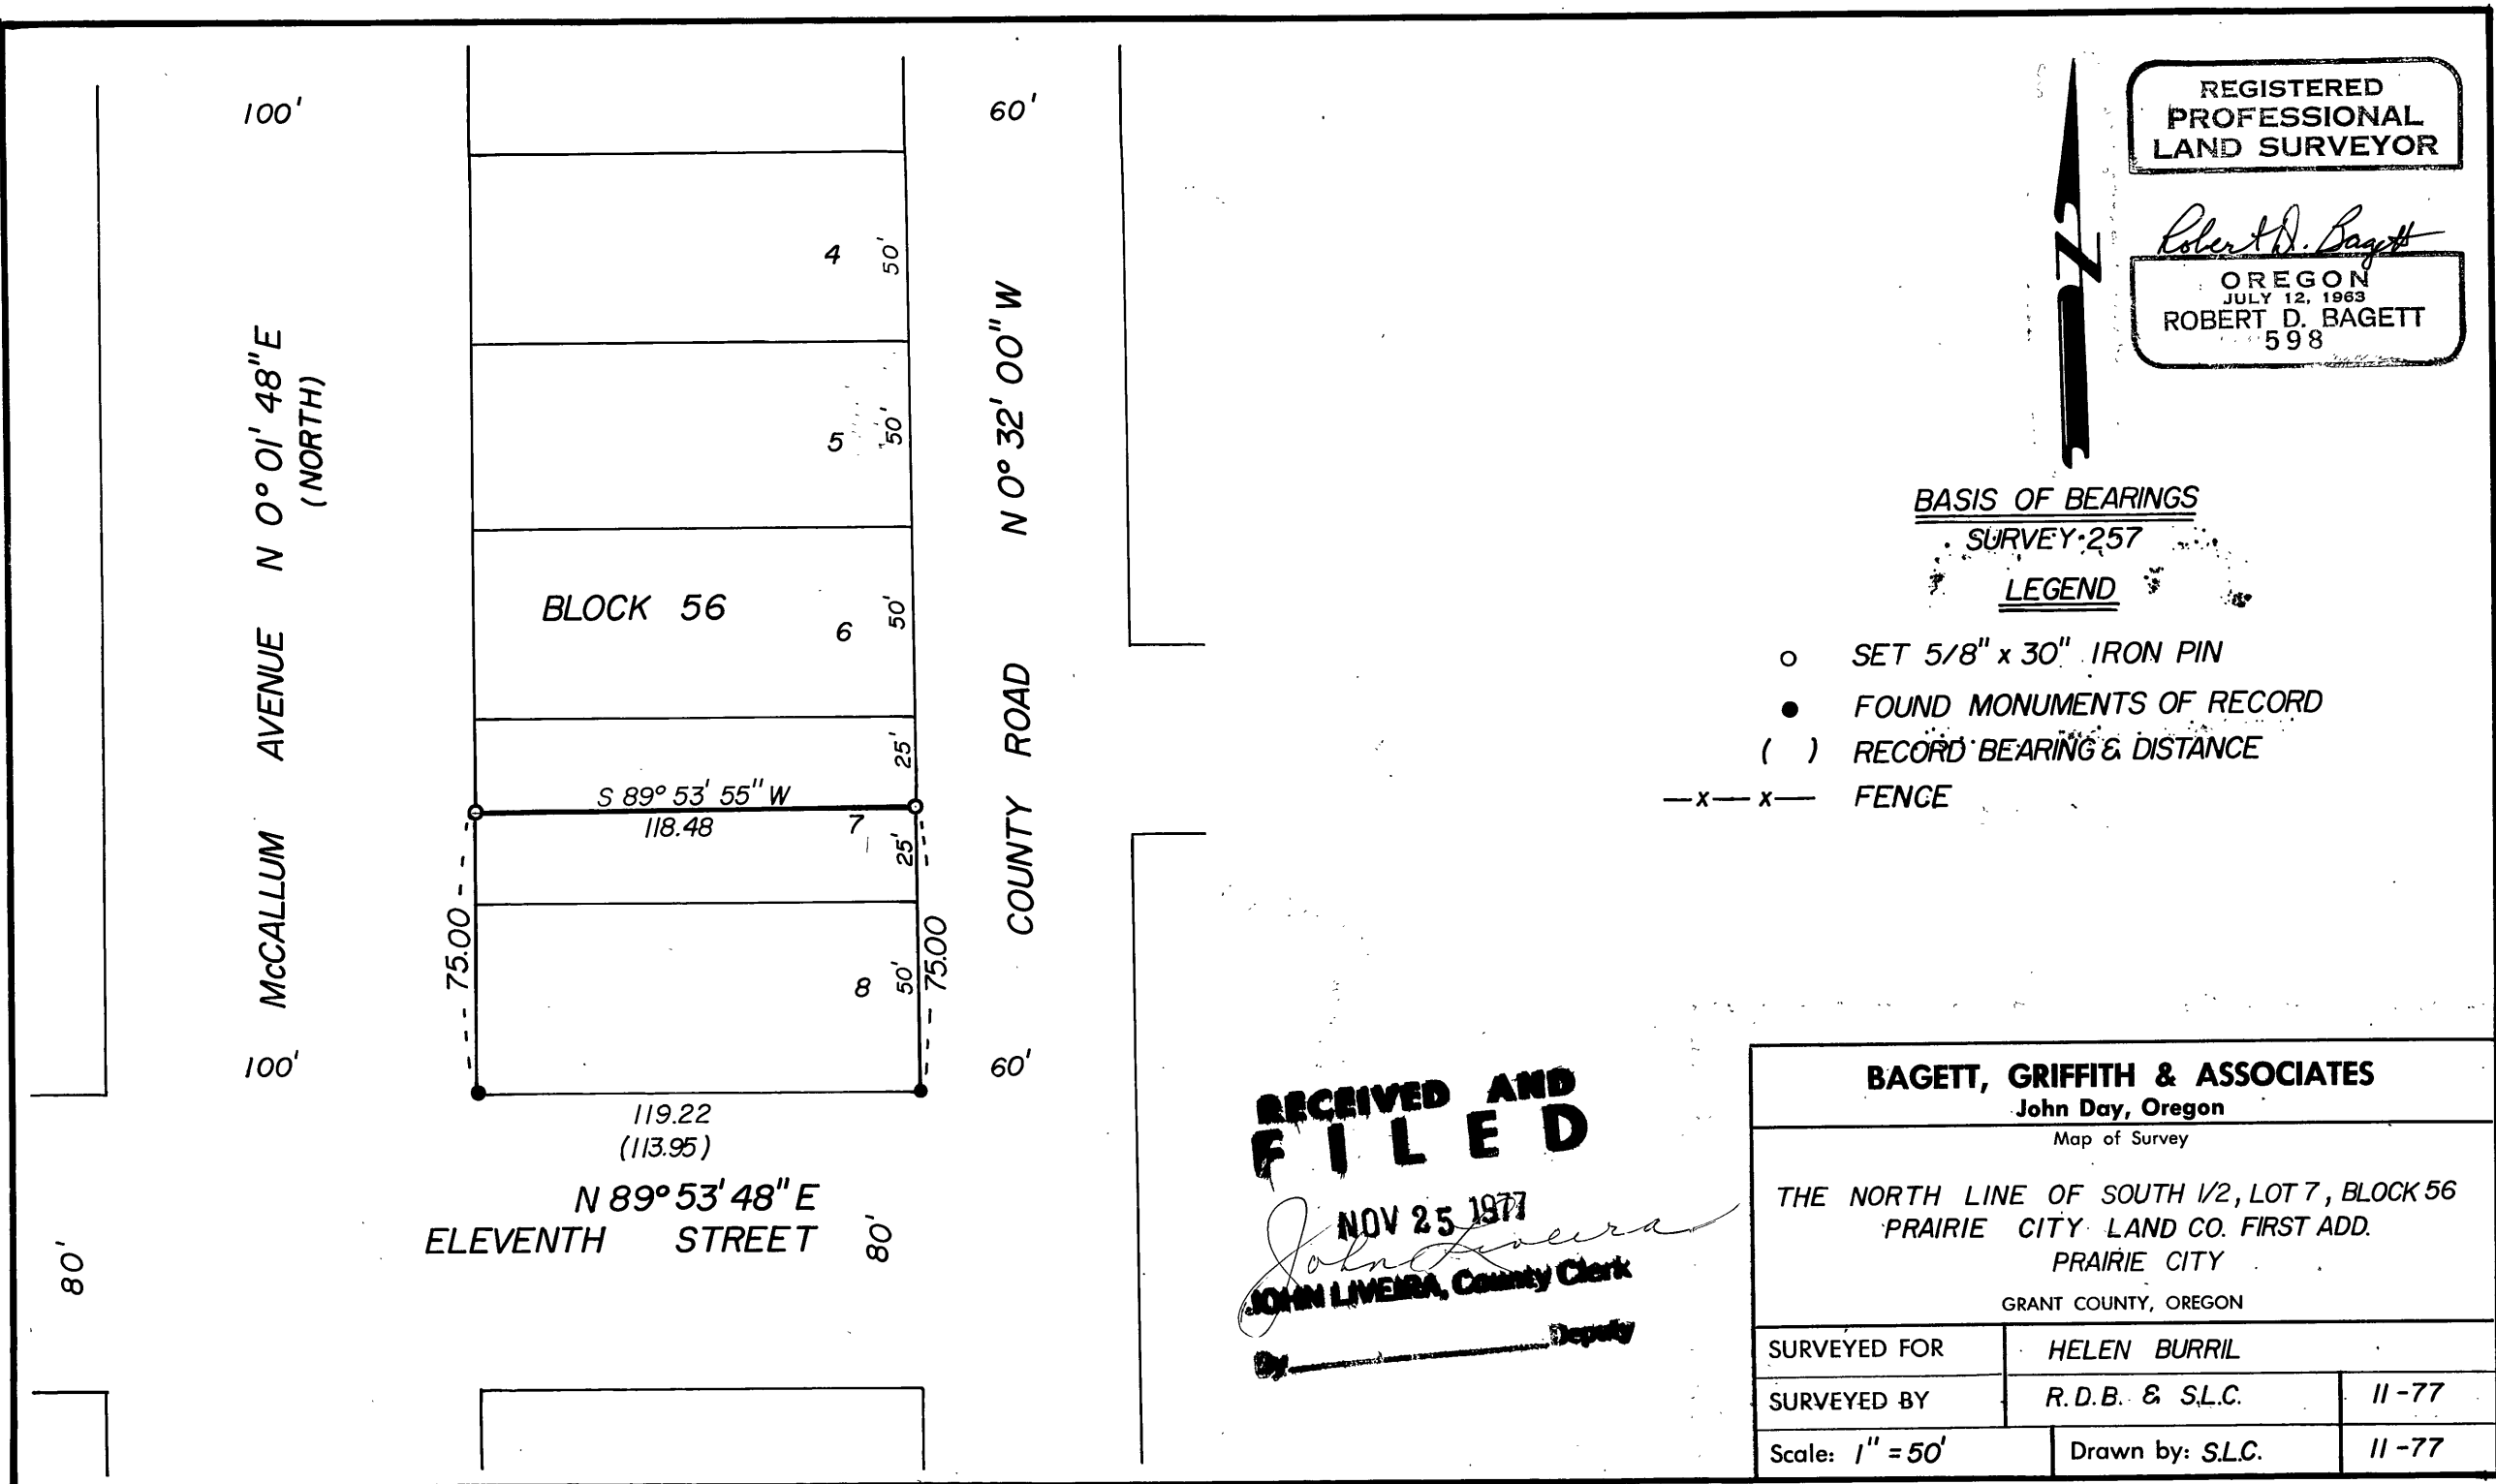

REGISTERED
PROFESSIONAL
LAND SURVEYOR

Robert D. Bagett

OREGON
JULY 12, 1963
ROBERT D. BAGETT
598

BASIS OF BEARINGS
SURVEY 257
LEGEND

- SET 5/8" x 30" IRON PIN
- FOUND MONUMENTS OF RECORD
- () RECORD BEARING & DISTANCE
- x—x— FENCE

RECEIVED AND
FILED

NOV 25 1977
John Liveira
JOHN LIVEIRA, County Clerk
Deputy

BAGETT, GRIFFITH & ASSOCIATES		
John Day, Oregon		
Map of Survey		
THE NORTH LINE OF SOUTH 1/2, LOT 7, BLOCK 56		
PRAIRIE CITY LAND CO. FIRST ADD.		
PRAIRIE CITY		
GRANT COUNTY, OREGON		
SURVEYED FOR	HELEN BURRIL	
SURVEYED BY	R.D.B. & S.L.C.	11-77
Scale: 1" = 50'	Drawn by: S.L.C.	11-77