

MONUMENTATION OF STREET CENTERLINES
PRAIRIE CITY, OREGON



BASIS OF BEARINGS


U. S. C. & G. S. FOWARD BEARING FROM PRAIRIE CITY
NORTH BASE Δ , TO PRAIRIE CITY SOUTH BASE Δ .

LEGEND

- SET CONCRTE MONUMENT WITH BRASS CAP AT INTERSECTION OF STREET CENTERLINES (SEE DETAIL)
- ⊙ FOUND MONUMENTS OF RECORD
- () BEARINGS & DISTANCES OF RECORD

REFERENCES

CLEAVER & COZART ADDITION TO PRAIRIE CITY
KIRCHHEINER'S ADDITION TO PRAIRIE CITY
KILBOURN'S ADDITION TO PRAIRIE CITY
RIVERSIDE ADDITION " " "
FLAGEOLET ADDITION " " "
HARDMAN ADDITION " " "
MAP OF SURVEY NO'S 113,138,191,196,420,442

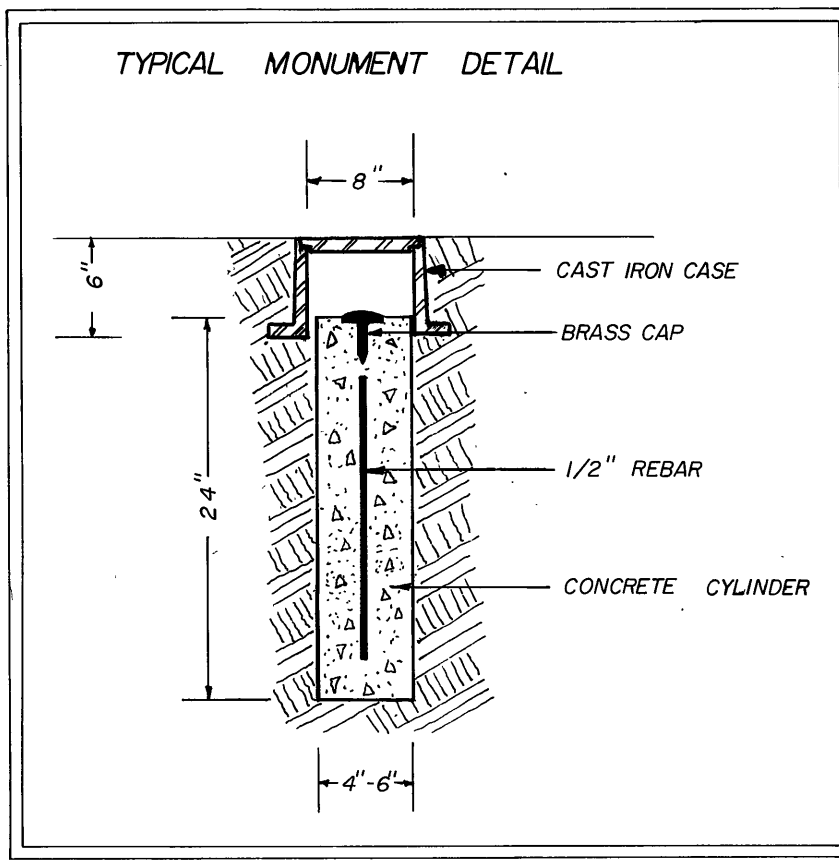

RECEIVED AND
FILED
SEP 6 1906

BAGETT, GRIFFITH & ASSOCIATES John Day, Oregon Map of Survey		
MONUMENTATION OF STREET CENTERLINES PRAIRIE CITY GRANT COUNTY, OREGON		
SURVEYED FOR	PRAIRIE CITY	
SURVEYED BY	R.D.B., W.G., S.L.C.	REGAN SURVEY 9-15-77
Scale: 1" = 200'	Drawn by: S.L.C.	11-77