


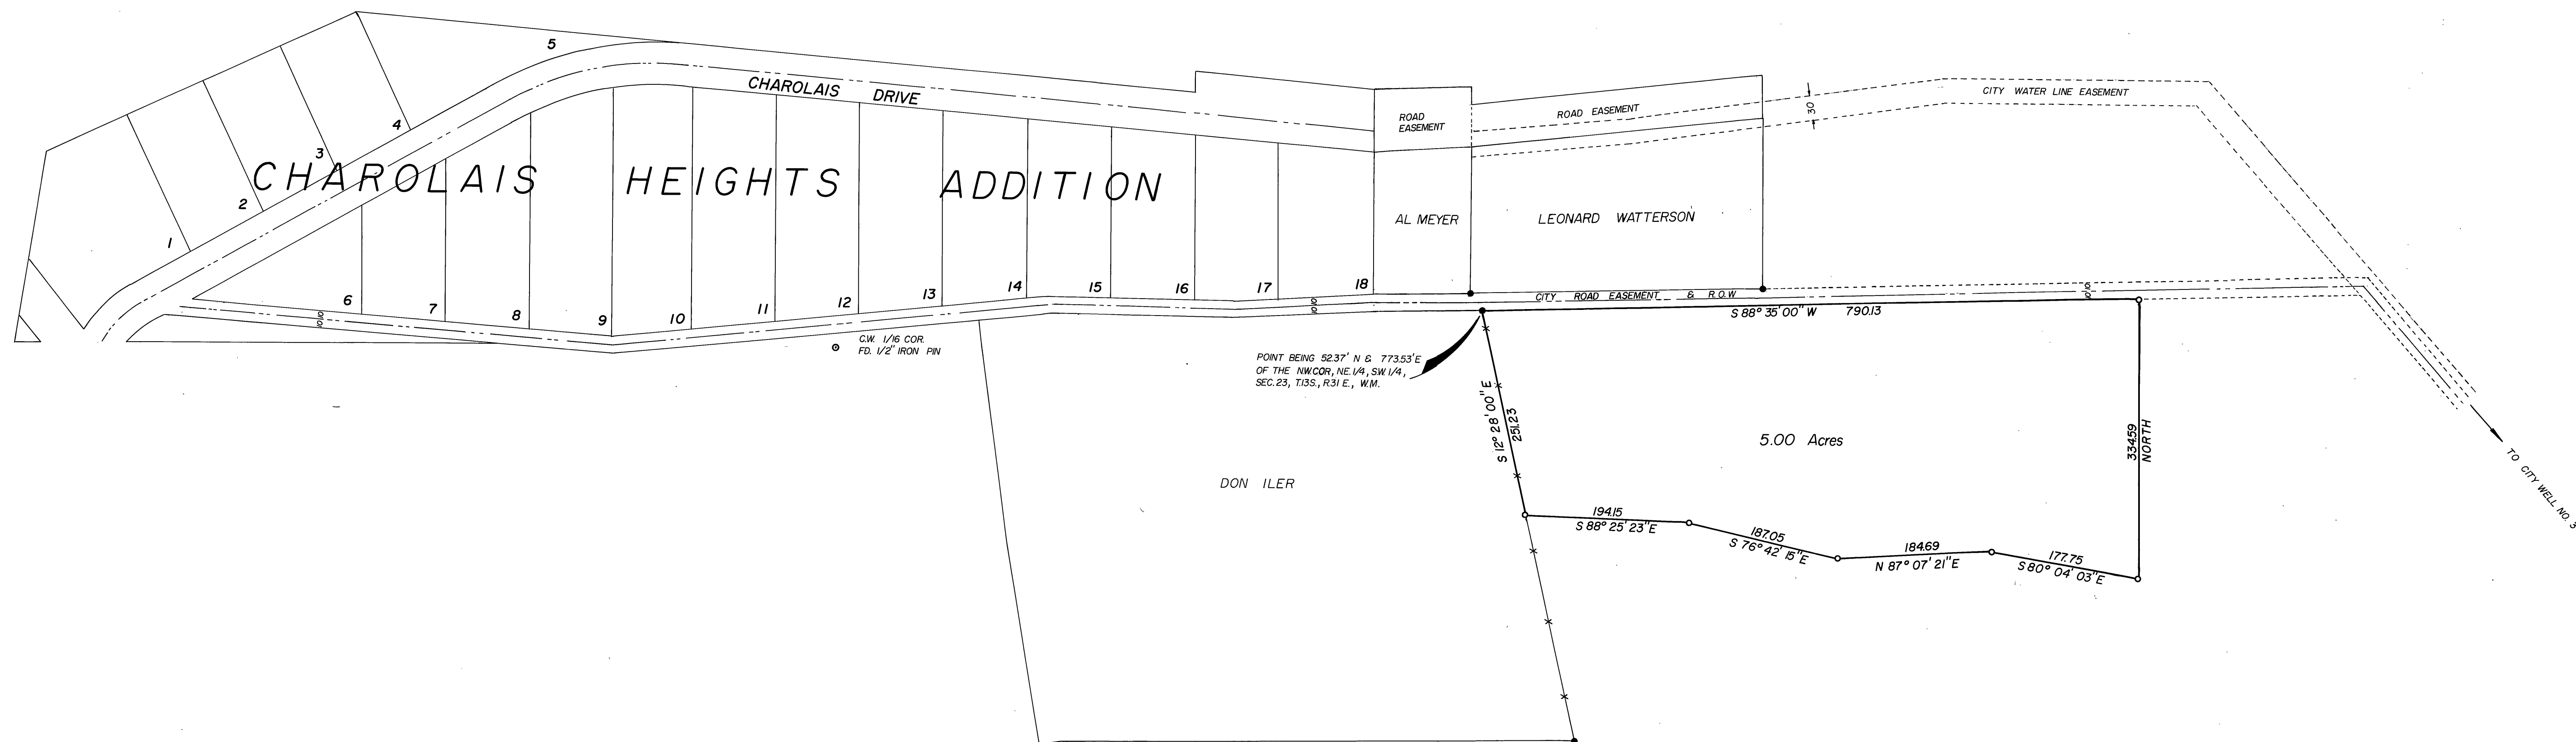

BASIS OF BEARINGS
SOLAR OBSERVATION



LEGEND

- SET 5/8" x 30" IRON PIN
- FOUND 5/8" x 30" IRON PIN
- x-x- FENCE

REFERENCES

MAP OF SURVEY NO. 166, 190, 258, 429
CHAROLAIS HEIGHTS ADDITION



**RECEIVED AND
FILED**

JUN 23 1978

JOHN LIVEIRA, County Clerk
By *Betty Louney* Deputy

BAGETT, GRIFFITH & ASSOCIATES John Day, Oregon Map of Survey			
A PARCEL OF LAND IN THE SW 1/4 NE 1/4, NW 1/4 SE 1/4, NE 1/4 SW 1/4, SE 1/4 NW 1/4, SEC. 23, T13S, R31E, W1M. JOHN DAY			
GRANT COUNTY, OREGON			
SURVEYED FOR	JOHN HOLMSTROM		
SURVEYED BY	R.D.B., S.L.C.	12/77	
Scale: 1" = 100'	Drawn by: S.L.C.	12/77	