


SURVEY MAP

Showing points found and set during a survey made on
Dec. 5 thru Dec. 7 at the request of the City Council of Seneca.

CITY OF SENECA, GRANT COUNTY, OREGON

Situated in the SW $\frac{1}{4}$ of Section 35, T.16 S., R. 31 E., W.M., Grant County, Oregon

By: M.A. Palmer & Sons
Engineering & Surveying
254 N. Alder - Box 61
Burns, Oregon

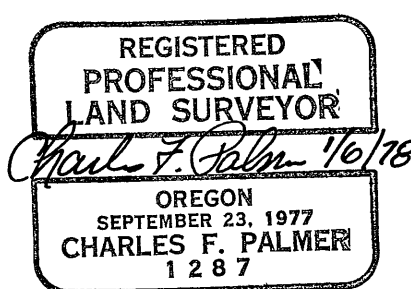

RECEIVED AND
FILED

JAN 30 1978
JOHN LIVEIRA, County Clerk
By _____ Deputy

Drawn by: C.F. Palmer
JO 120 : 196

January 6, 1978

34 | 35
3 | 2

T.16 S., R. 31 E., W.M.

