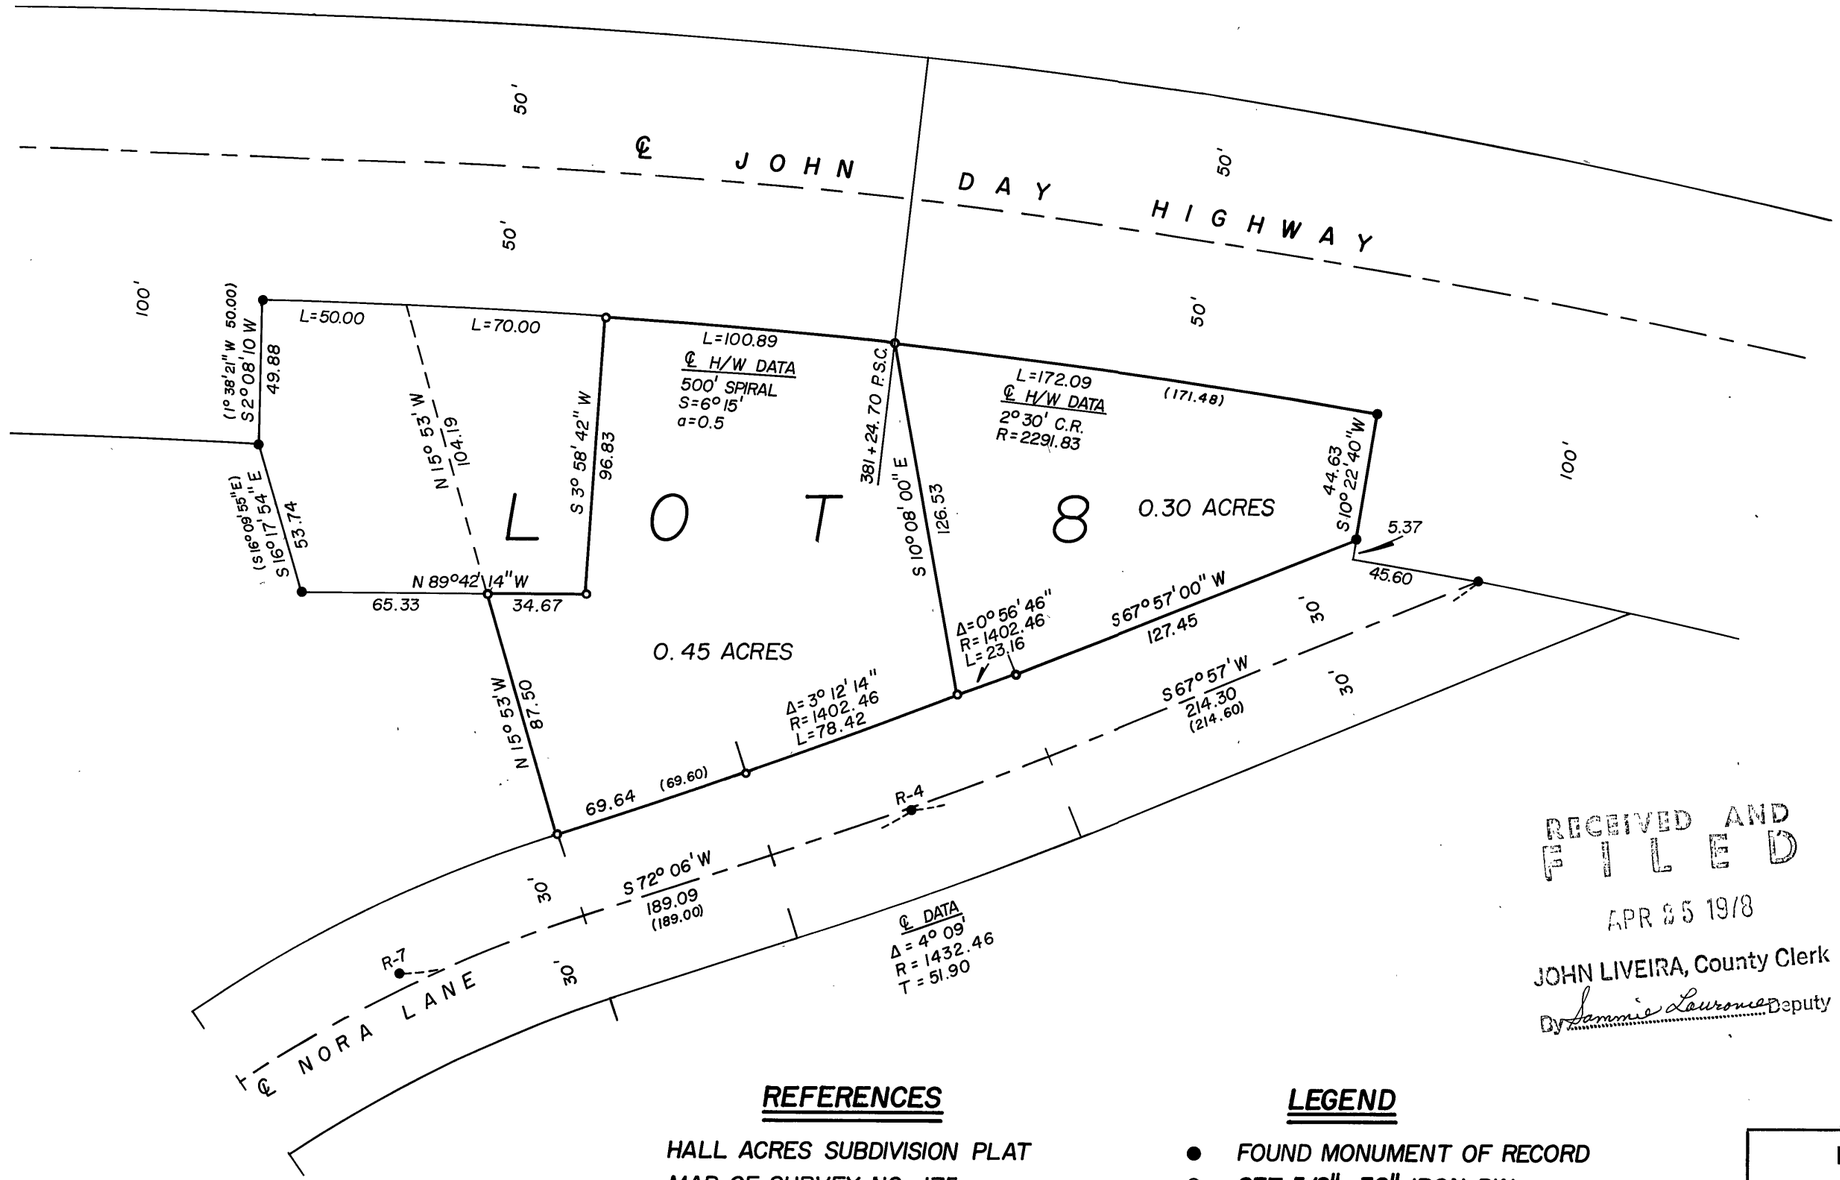

BASIS OF BEARINGS

REC. BEARING BETWEEN
NORA LANE ℄ P.I.
MONUMENTS R-4 & R-7

RECEIVED AND
FILED
APR 25 1978
JOHN LIVEIRA, County Clerk
By Jannie Lauronce Deputy

REGISTERED
PROFESSIONAL
LAND SURVEYOR

Robert D. Bagett

OREGON
JULY 12, 1963
ROBERT D. BAGETT
598

REFERENCES

HALL ACRES SUBDIVISION PLAT
MAP OF SURVEY NO. 175

LEGEND

- ● FOUND MONUMENT OF RECORD
- ○ SET 5/8" x 30" IRON PIN
- ( ) RECORD BEARING & DISTANCE

BAGETT, GRIFFITH & ASSOCIATES
John Day, Oregon

Map of Survey

LOT 8, BLOCK 1

HALL ACRES SUBDIVISION

GRANT COUNTY, OREGON

SURVEYED FOR	DON LUNDBOM	
SURVEYED BY	R.D.B. & S.F.J.	4-17-78
Scale: 1" = 50'	Drawn by: K.M.S.	4-18-78

MAP OF SURVEY NO. 507