


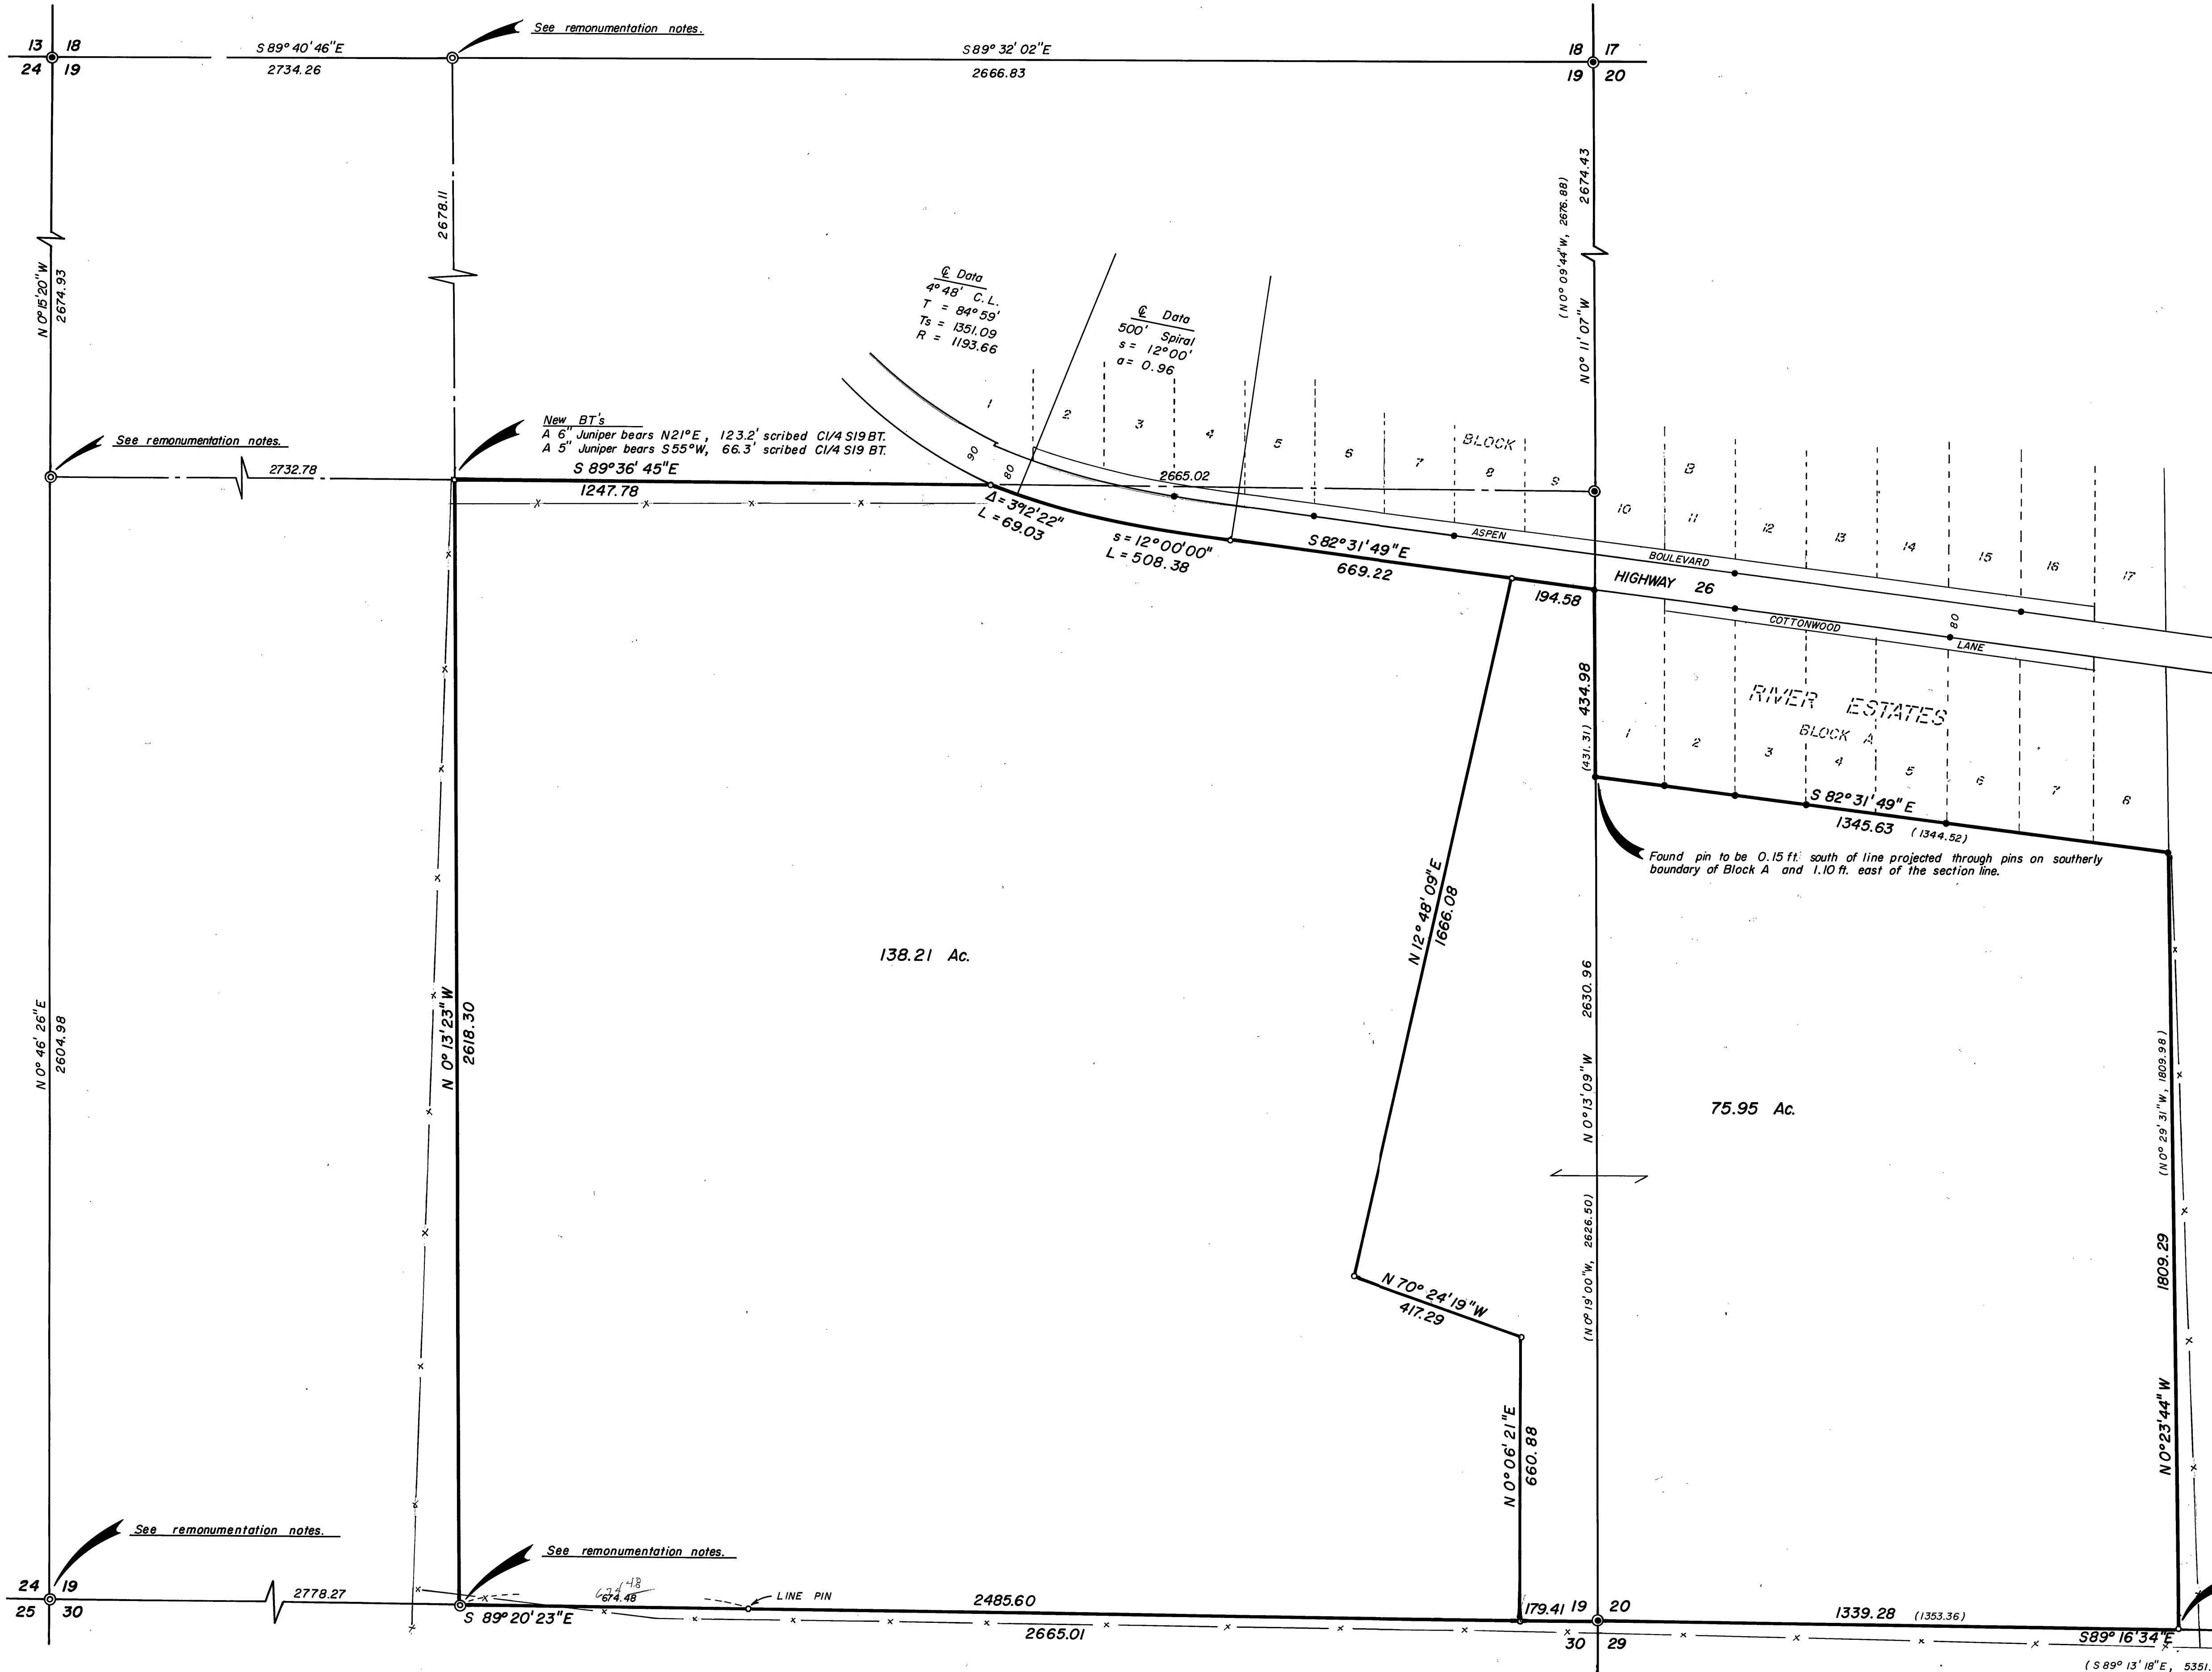

BASIS OF BEARINGS
RIVER ESTATES SUBDIVISION

REFERENCES

RIVER ESTATES SUBDIVISION PLAT
MAP OF SURVEY NO. 156
G. L. O. NOTES

LEGEND

- FOUND BRASS CAP MON.
- ⊙ SET 2 1/2" x 30" IRON PIPE WITH BRASS CAP
- FD. IRON PIN OF RECORD
- SET 5/8" x 36" IRON PIN
- () RECORD BEARINGS & DIST.
- *—*— EXISTING FENCES

RECEIVED AND
FILED

JUN 1 1978
JOHN L. VEIRA, County Clerk
By: Deputy

REGISTERED
PROFESSIONAL
LAND SURVEYOR
DOUGLAS M. FERGUSON
848

OREGON EAST ENGINEERING, INC.
Mt. Vernon, Oregon

Map of Survey
Split a Parcel of Land Situated in
SE 1/4, Sec. 19 & SW 1/4, Sec. 20,
T. 13 S., R. 29 E., W. M.
GRANT COUNTY, OREGON

For: John Kalita By: D.M.F. & J.A.L.
Date: 3/78 Drawing No: A-66 Sheet 1 of 1
Scale: 1" = 200' Job No: S-0178 Drawn By: J.A.L.