


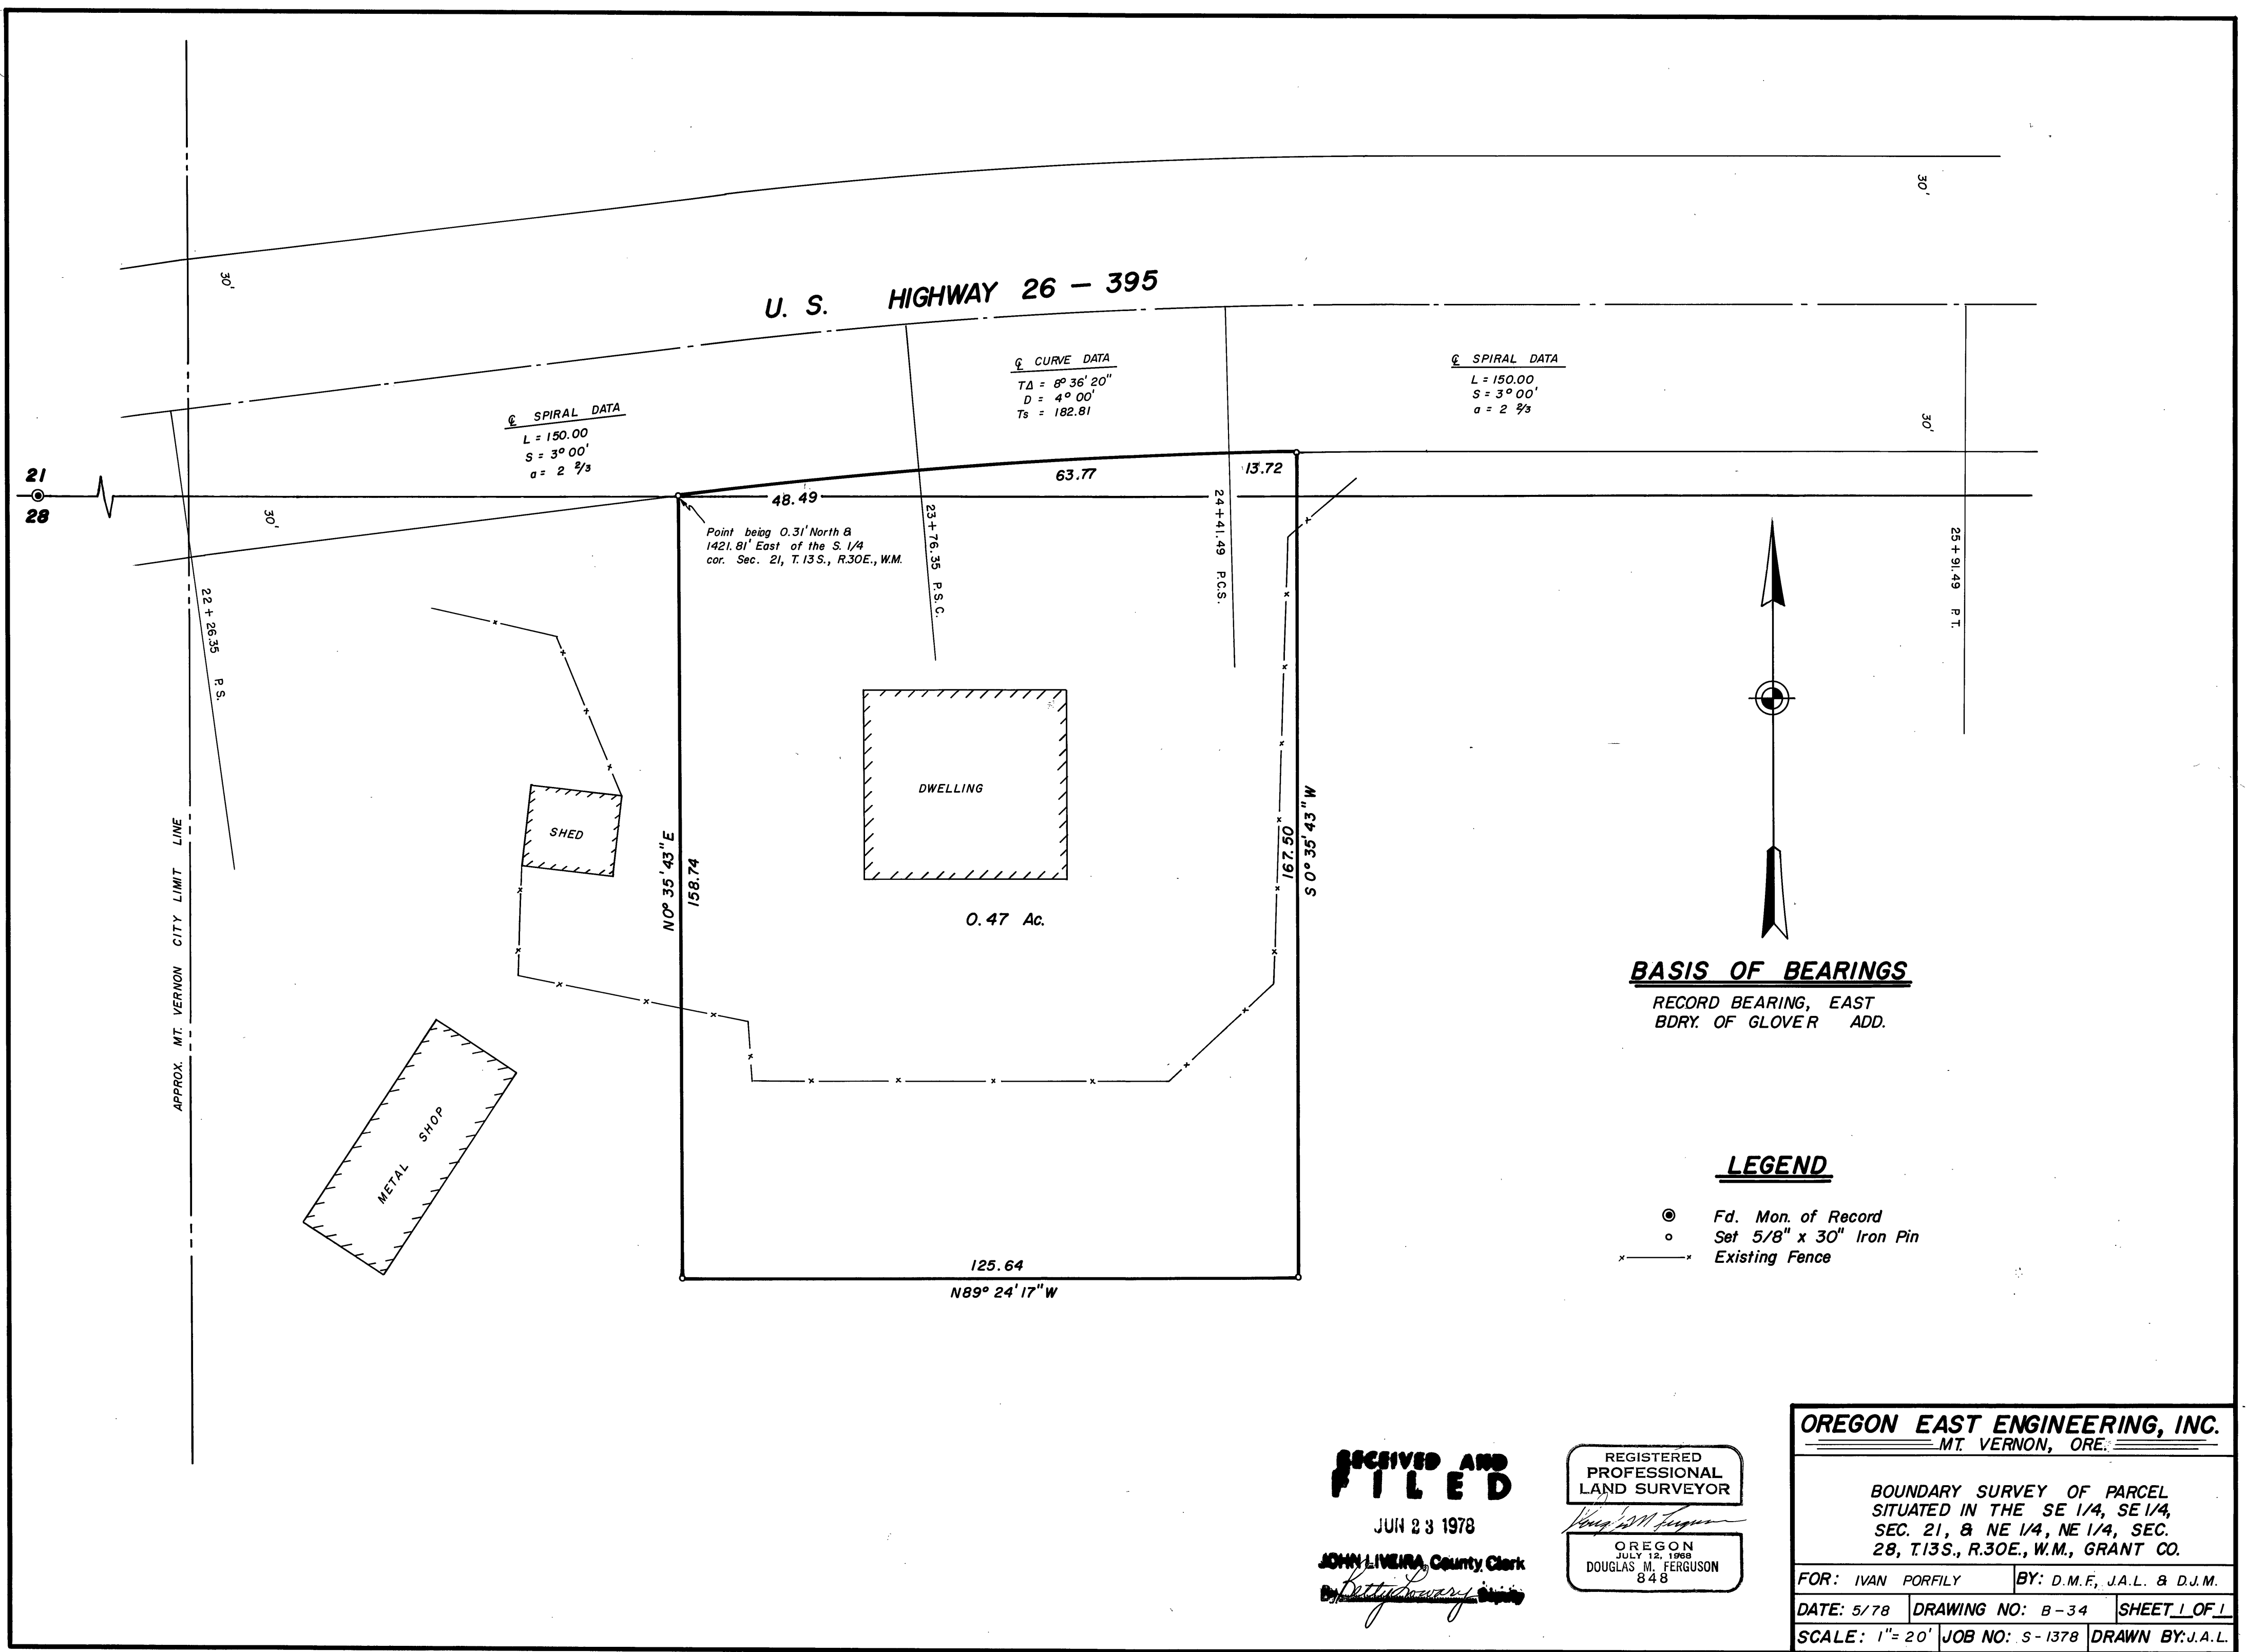

BASIS OF BEARINGS
RECORD BEARING, EAST
BDRY. OF GLOVER ADD.

LEGEND
● Fd. Mon. of Record
○ Set 5/8" x 30" Iron Pin
— Existing Fence

RECEIVED AND FILED
JUN 23 1978
JOHN L. LEMURA, County Clerk
[Signature]

REGISTERED
PROFESSIONAL
LAND SURVEYOR
[Signature]
OREGON
JULY 12, 1968
DOUGLAS M. FERGUSON
848

OREGON EAST ENGINEERING, INC. MT. VERNON, ORE.		
BOUNDARY SURVEY OF PARCEL SITUATED IN THE SE 1/4, SE 1/4, SEC. 21, & NE 1/4, NE 1/4, SEC. 28, T.13S., R.30E., W.M., GRANT CO.		
FOR: IVAN PORFELY	BY: D.M.F., J.A.L. & D.J.M.	
DATE: 5/78	DRAWING NO: B-34	SHEET 1 OF 1
SCALE: 1" = 20'	JOB NO: S-1378	DRAWN BY: J.A.L.